




ARCHITECTURAL WOODWORK SHOP DRAWINGS (2nd. Phase Part II)

MATERIALS:


- *BIRCH PLYWOOD CORE .
- * WD-1: PLAIN SLICED MAPLE VENEER ON MDF CORE.
- * WD-2: MAPLE SOLID WOOD.
- * LOCKING SUPPORTS FOR WOOD SHELVES: 5MM NICKEL PINS.
- * EURO HINGES: SALICE "SILENTIA" 200 SERIES.
- * SLEEVE TYPE CONNECTING SCREWS: KD-555NP.
- * DRAWER SLIDES: ACCURIDE #3132EC "ECLIPSE"
- * DOOR/ DRAWER PULLS/ KNOBS. TBD.
- * SOLID SURFACE: B.O.
- * GRANITE/ STONE : B.O.

NOTE: FINISH TO BE SELECTED BY OWNER/ ARCHITECT.
PER SAMPLE PROVIDED BY WOOD HARBOR HONEY.

LEGEND:

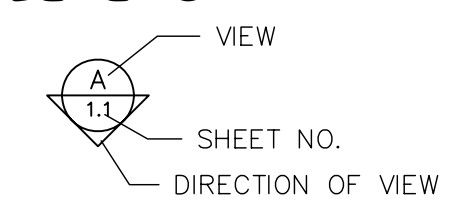

TITLE
SHEET

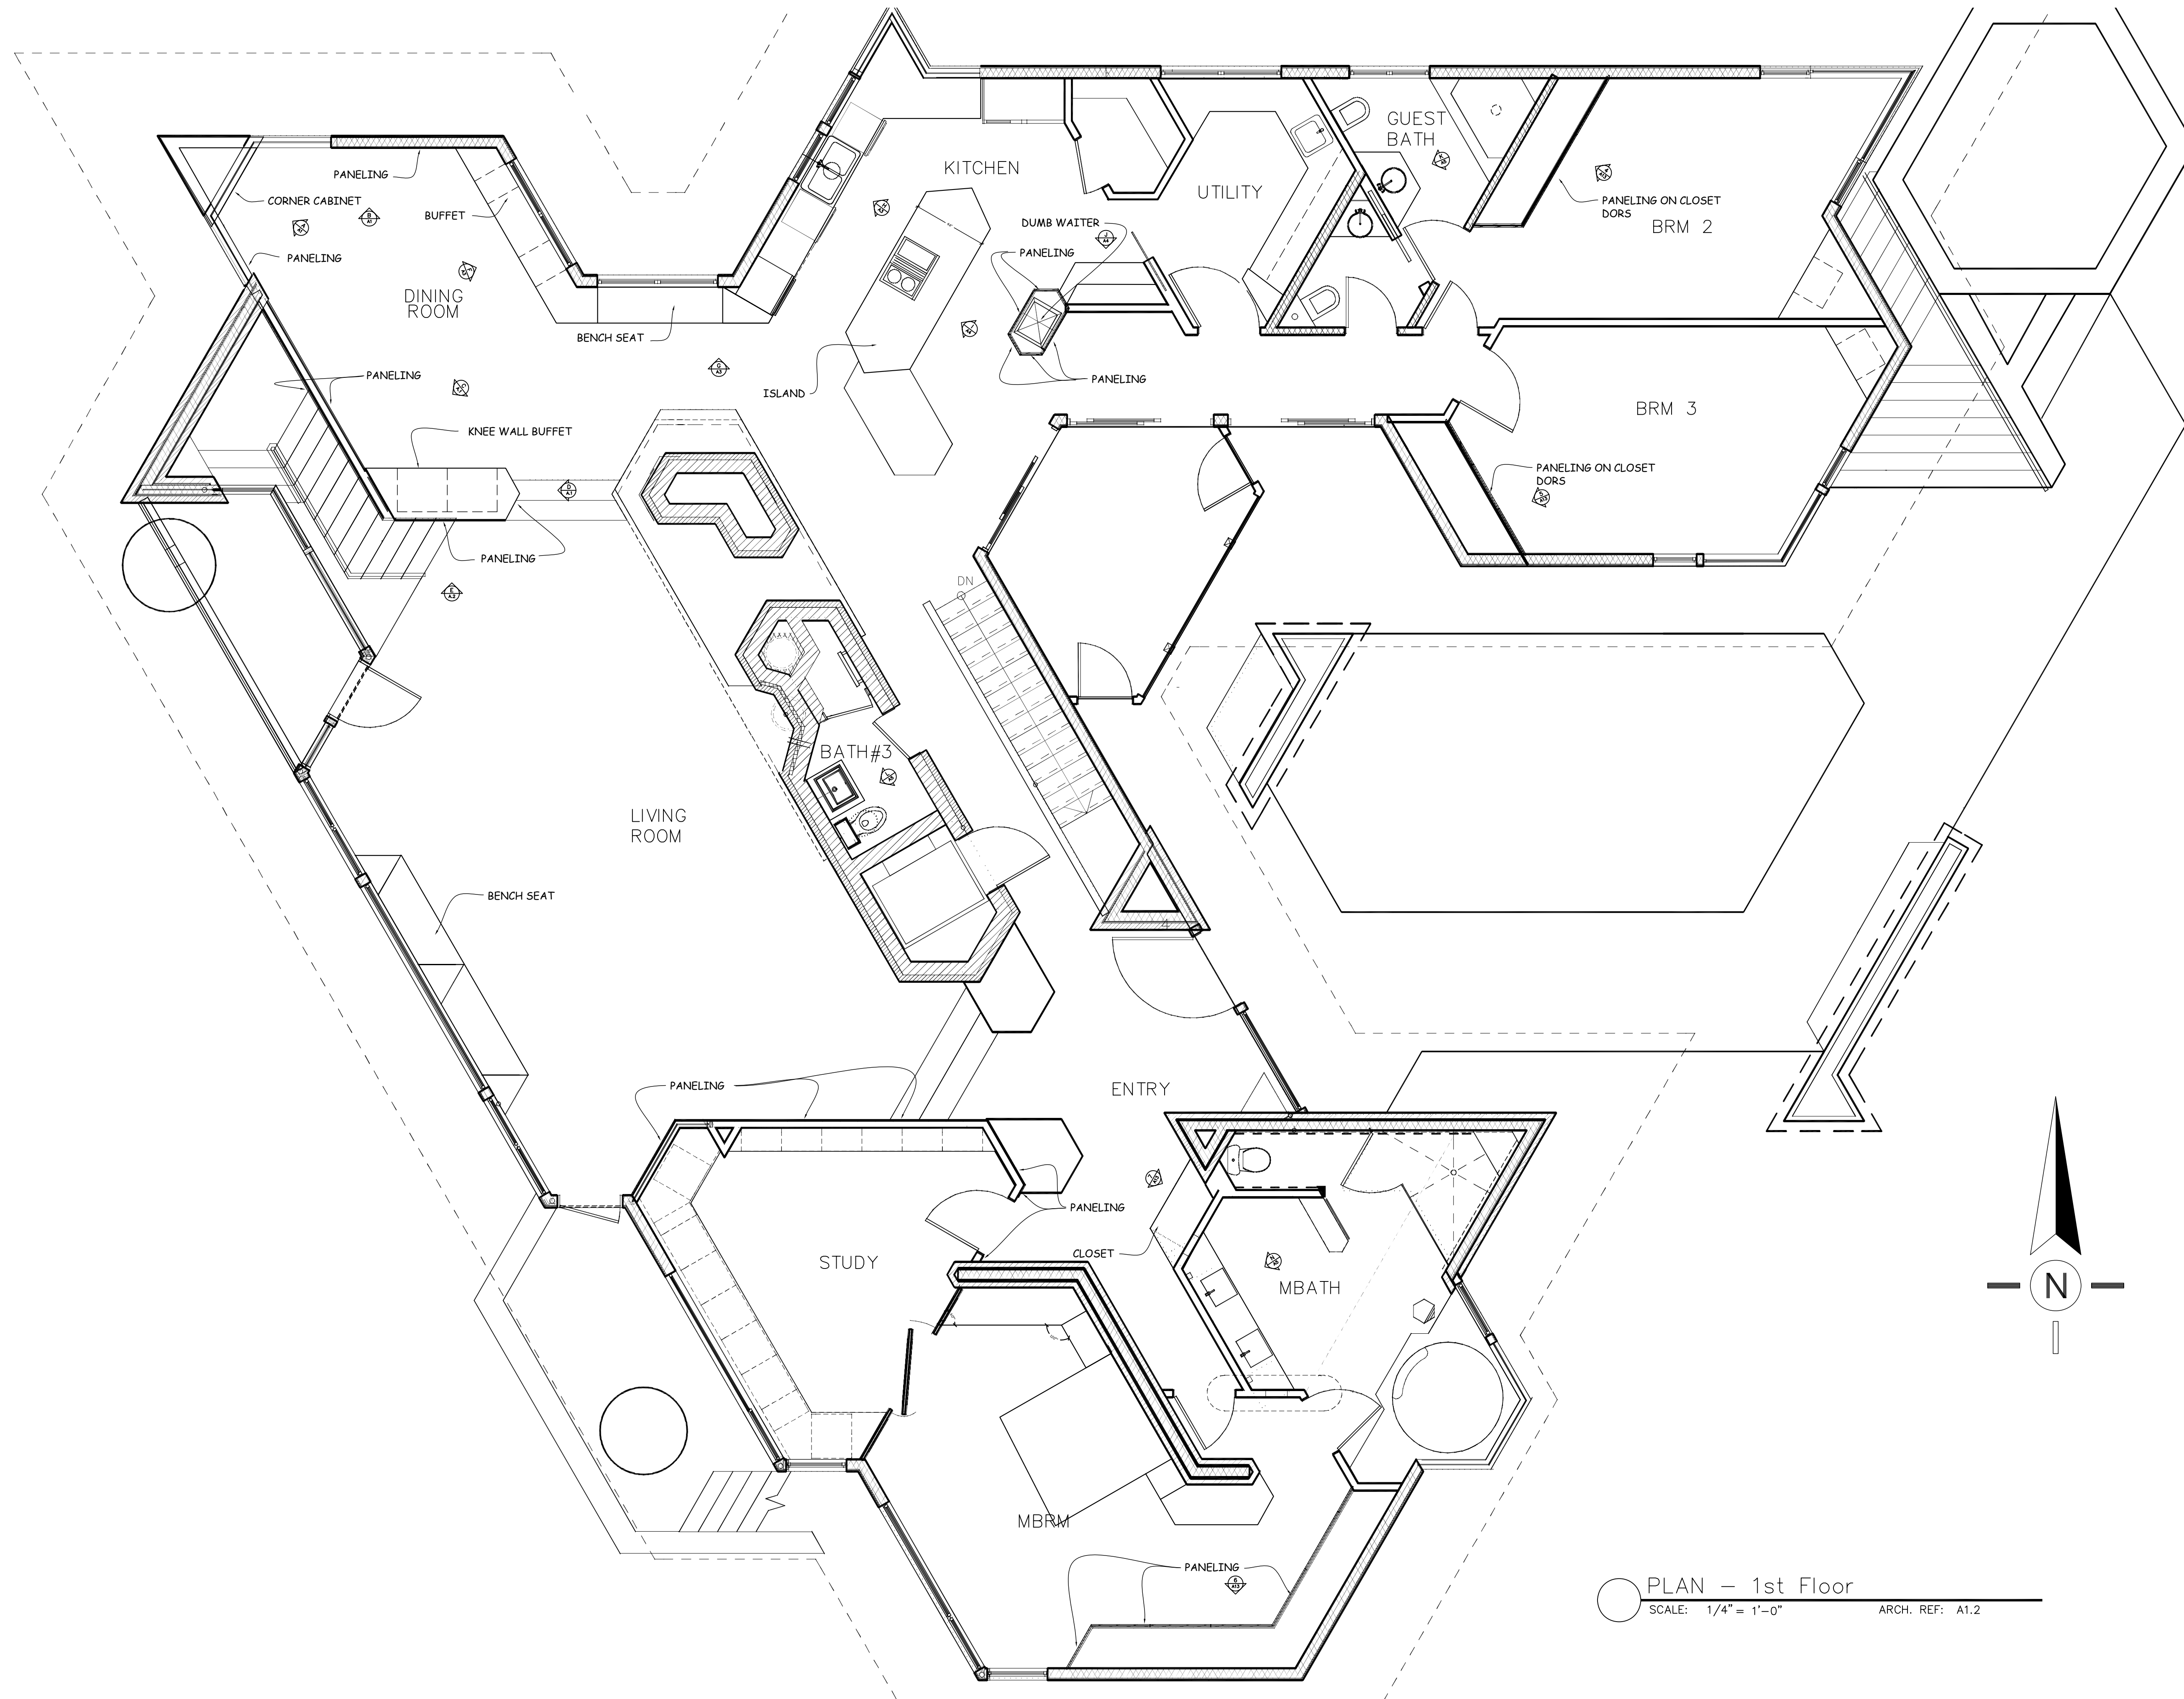

PLAN - 1st Floor
 SCALE: 1/4" = 1'-0" ARCH. REF: A1.2

General Notes

SHOP NOTES:

N&N Architectural Drafting Service
 Computer Aided Design & Drafting/ CNC Programming

LEGEND:
 VIEW
 SHEET NO.
 DIRECTION OF VIEW

Drawn by Nono K.

No.	Revision/Issue	Date
1	UPDATED	2-03
2	2nd Phase	2-27
2	2nd Phase Part II	7-23

DRAWING RECORD

ARCHITECT:


CONTRACTOR:

Project Name and Address:

Project: **First Floor** Sheet: **0.1**

Date: **1-29-07**

JOB # : *

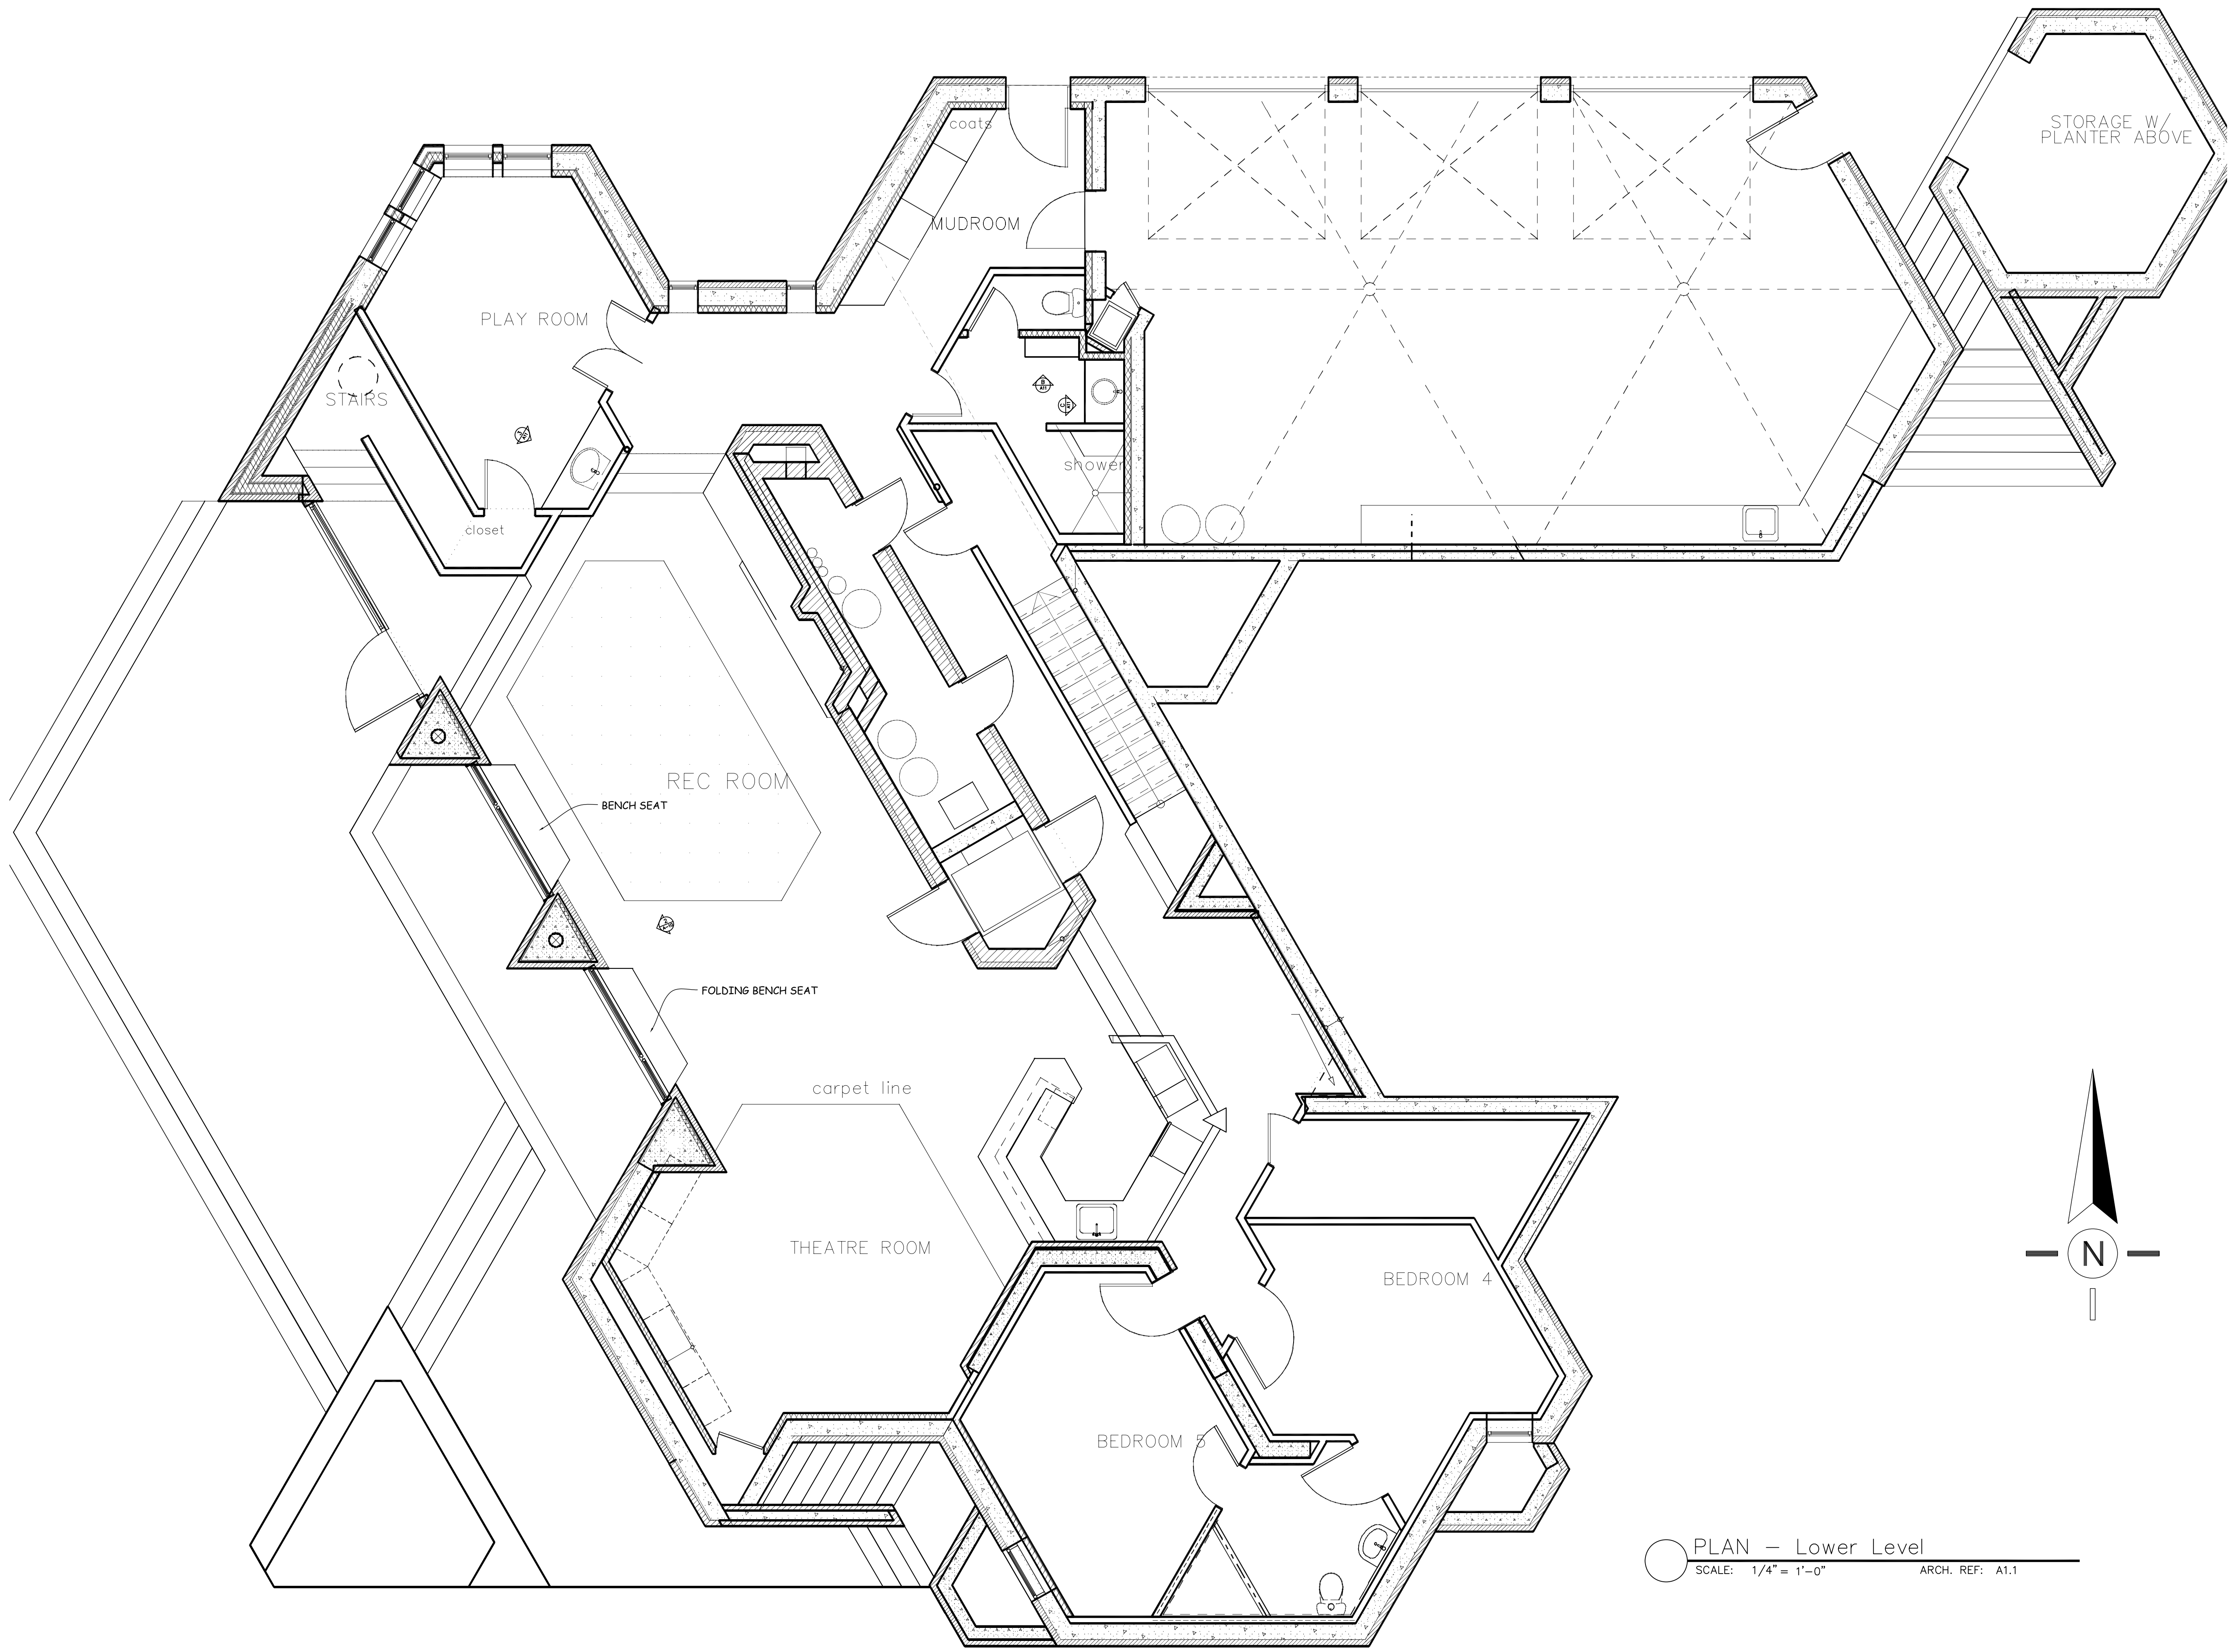

General Notes

SHOP NOTES:

N&N Architectural Drafting Service
 Computer Aided Design & Drafting/ CNC Programming

LEGEND:
 (Symbol with X) VIEW
 (Symbol with X X) SHEET NO.
 (Symbol with arrow) DIRECTION OF VIEW

Drawn by Nono K.


No.	Revision/Issue	Date
-	UPDATED	2-03
1	MARKUP PER OWNER/ARCH.	2-27
-	1ST PHASE ADDITION	3-21
-	1ST PHASE ADDITION PART II	5-11
-	2nd PHASE PART II	7-23

DRAWING RECORD


ARCHITECT:
 CONTRACTOR:
 Project Name and Address:

Project: Lower level	Sheet:
Date: 5-11-07	0.2
JOB # : *	


PLAN - Lower Level
 SCALE: 1/4" = 1'-0" ARCH. REF: A1.1

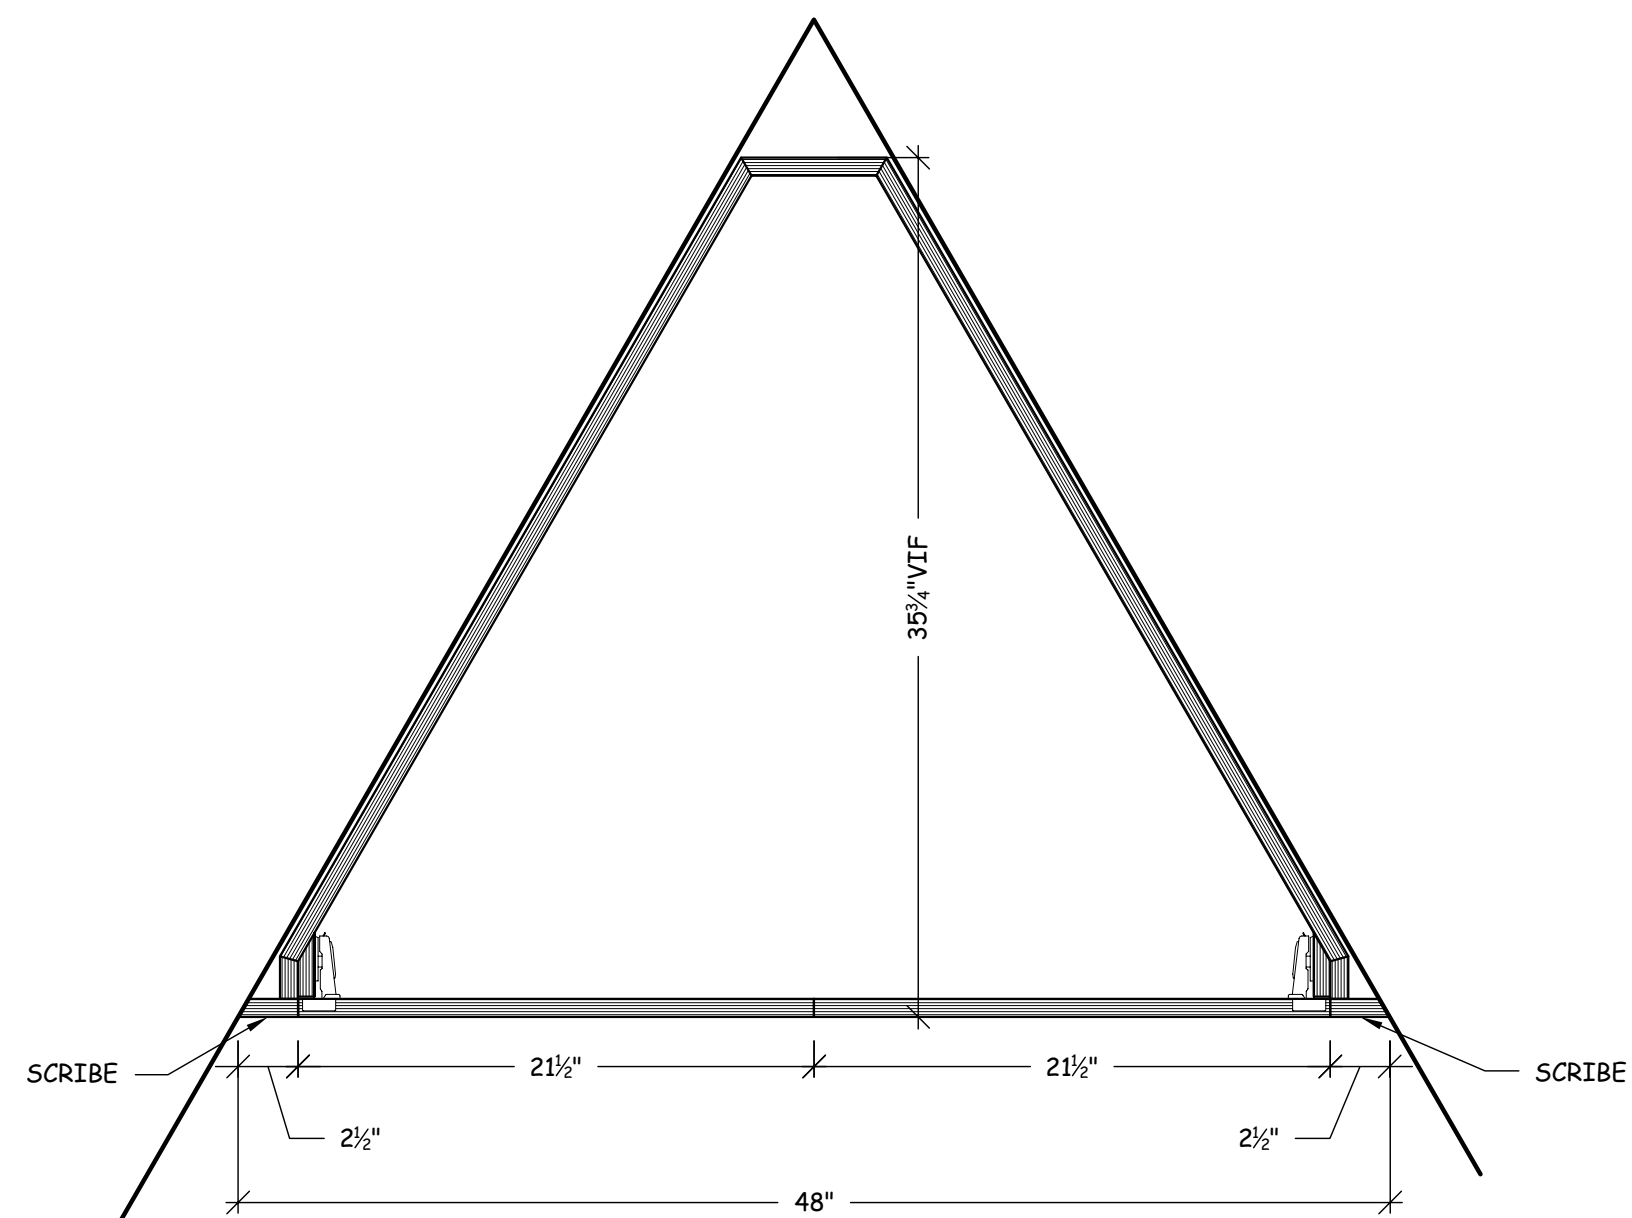


2X HORIZONTAL SECTION- CORNER CABINET
SCALE: 1 1/2" = 1'-0"

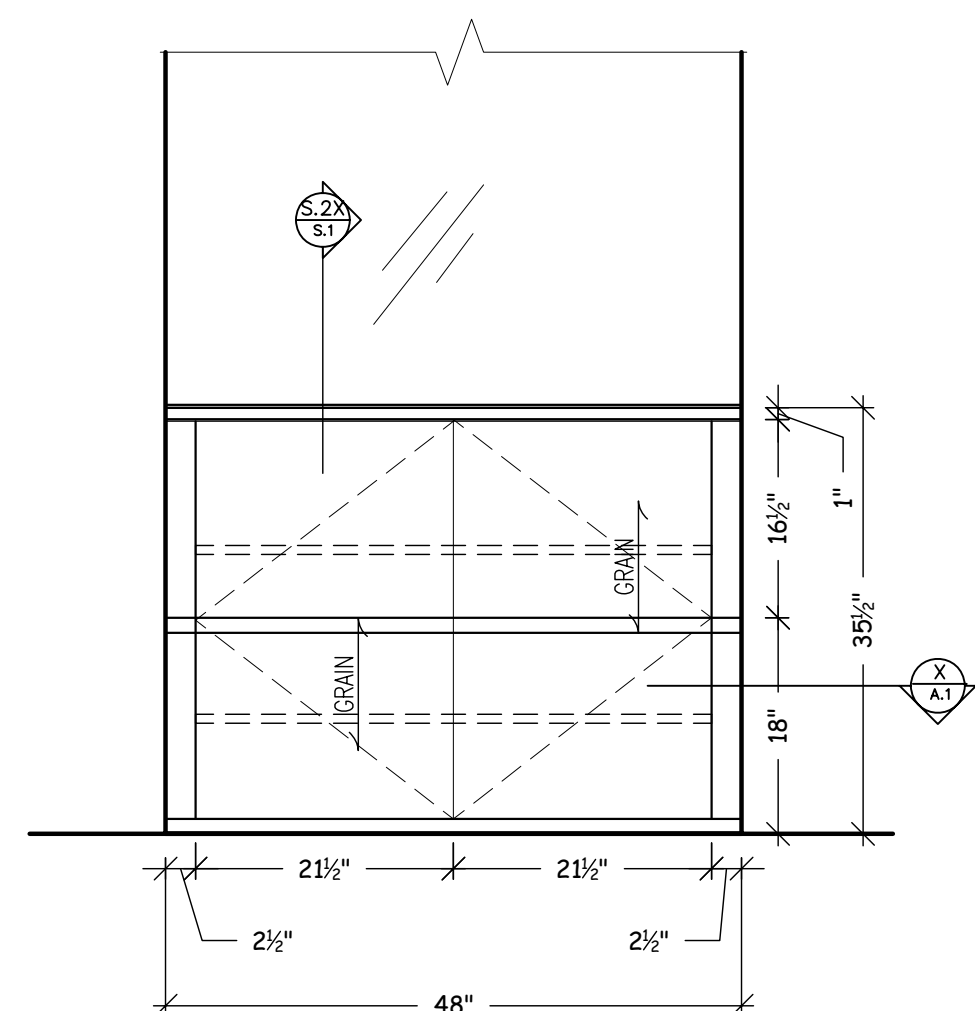


A ELEVATION- DINING RM. (N/W)
SCALE: 3/4" = 1'-0"

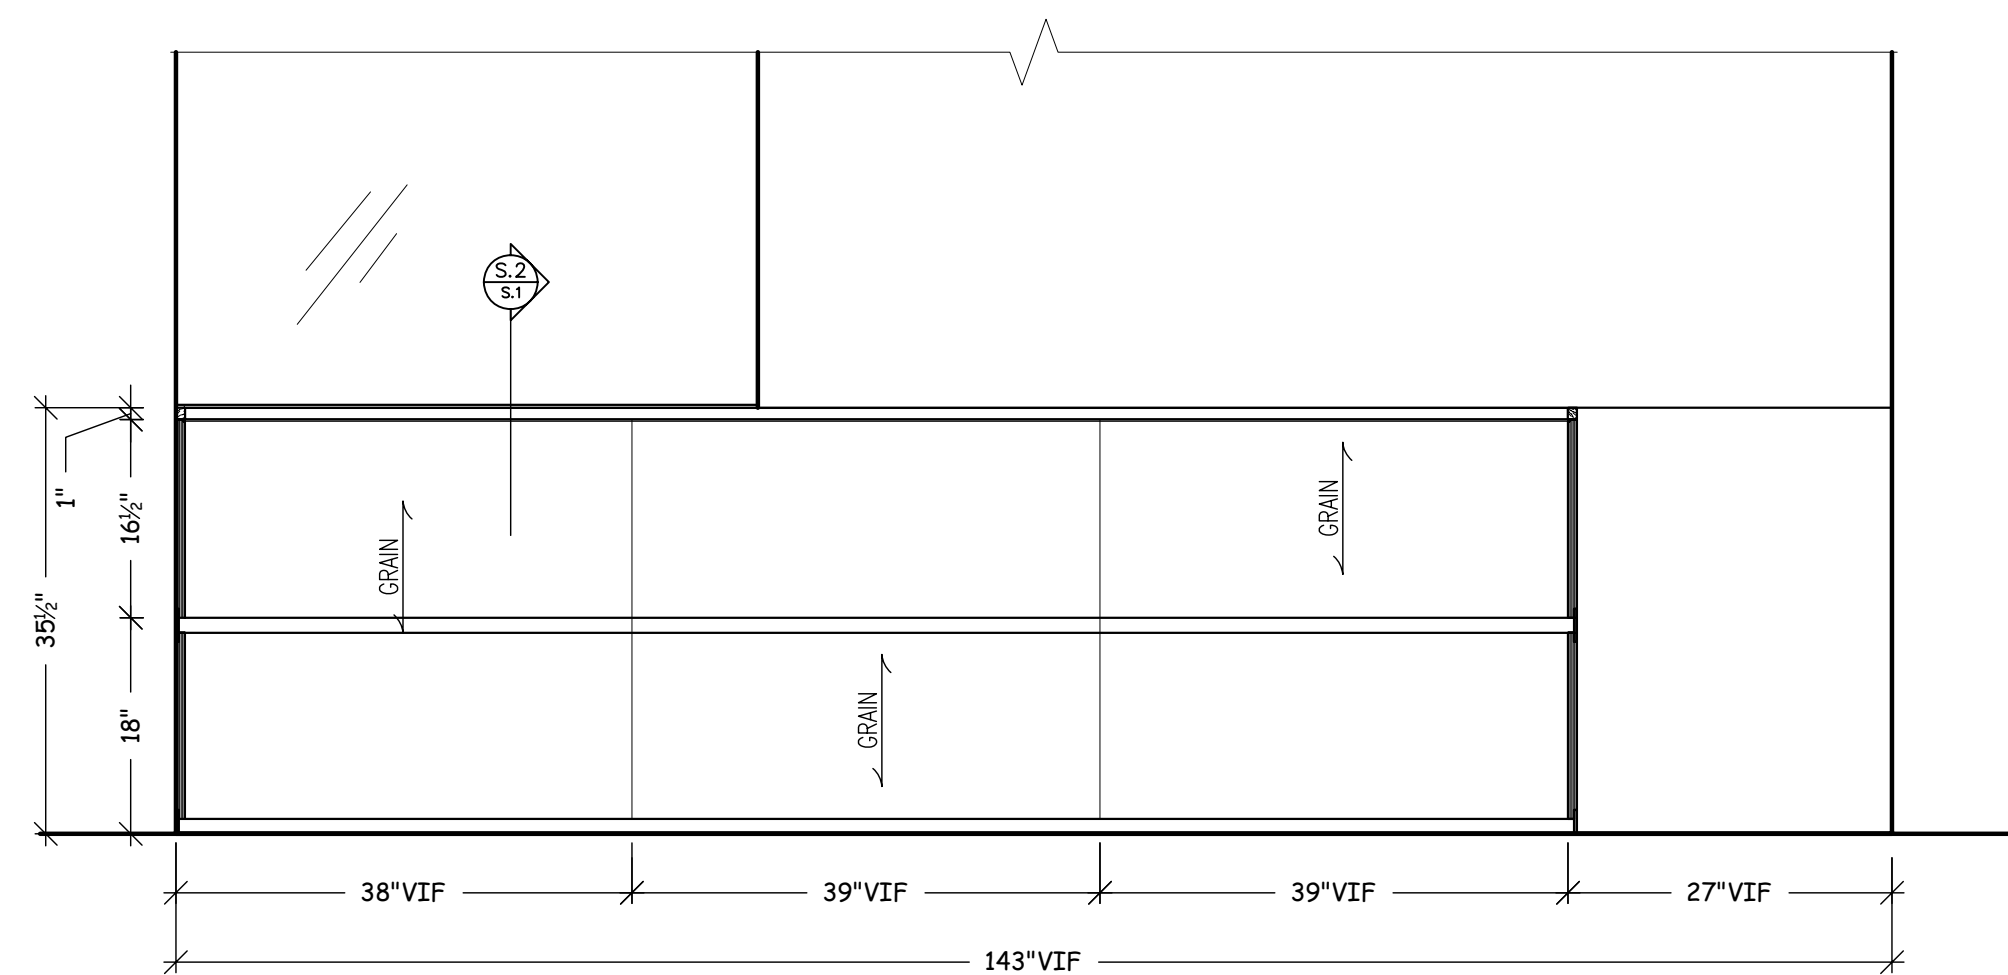

B ELEVATION- DINING RM. (N/E)
SCALE: 3/4" = 1'-0"

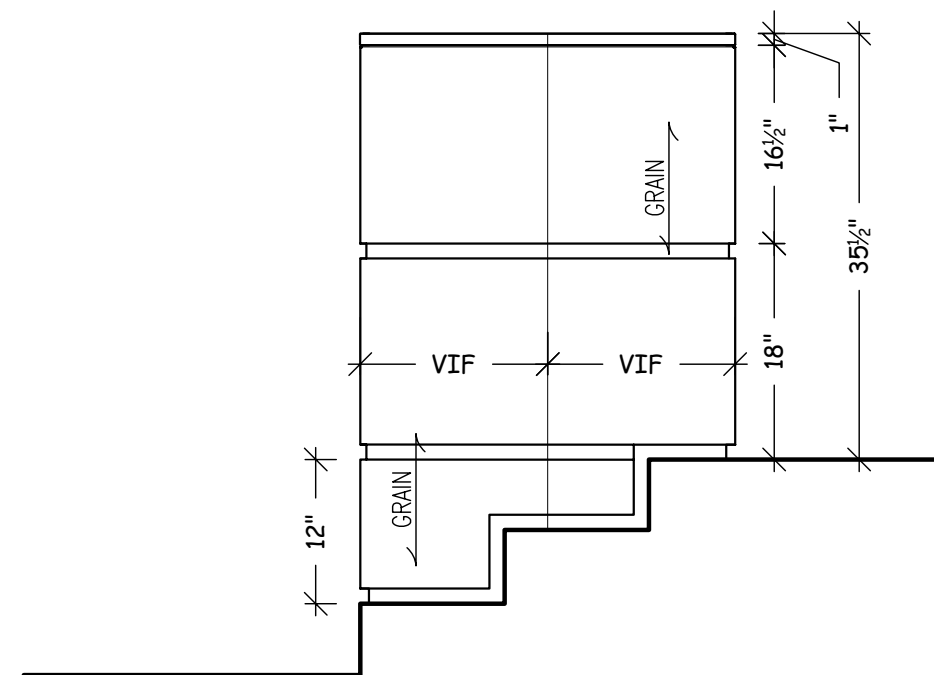

D ELEVATION- KNEE WALL SIDE VIEW
SCALE: 3/4" = 1'-0"

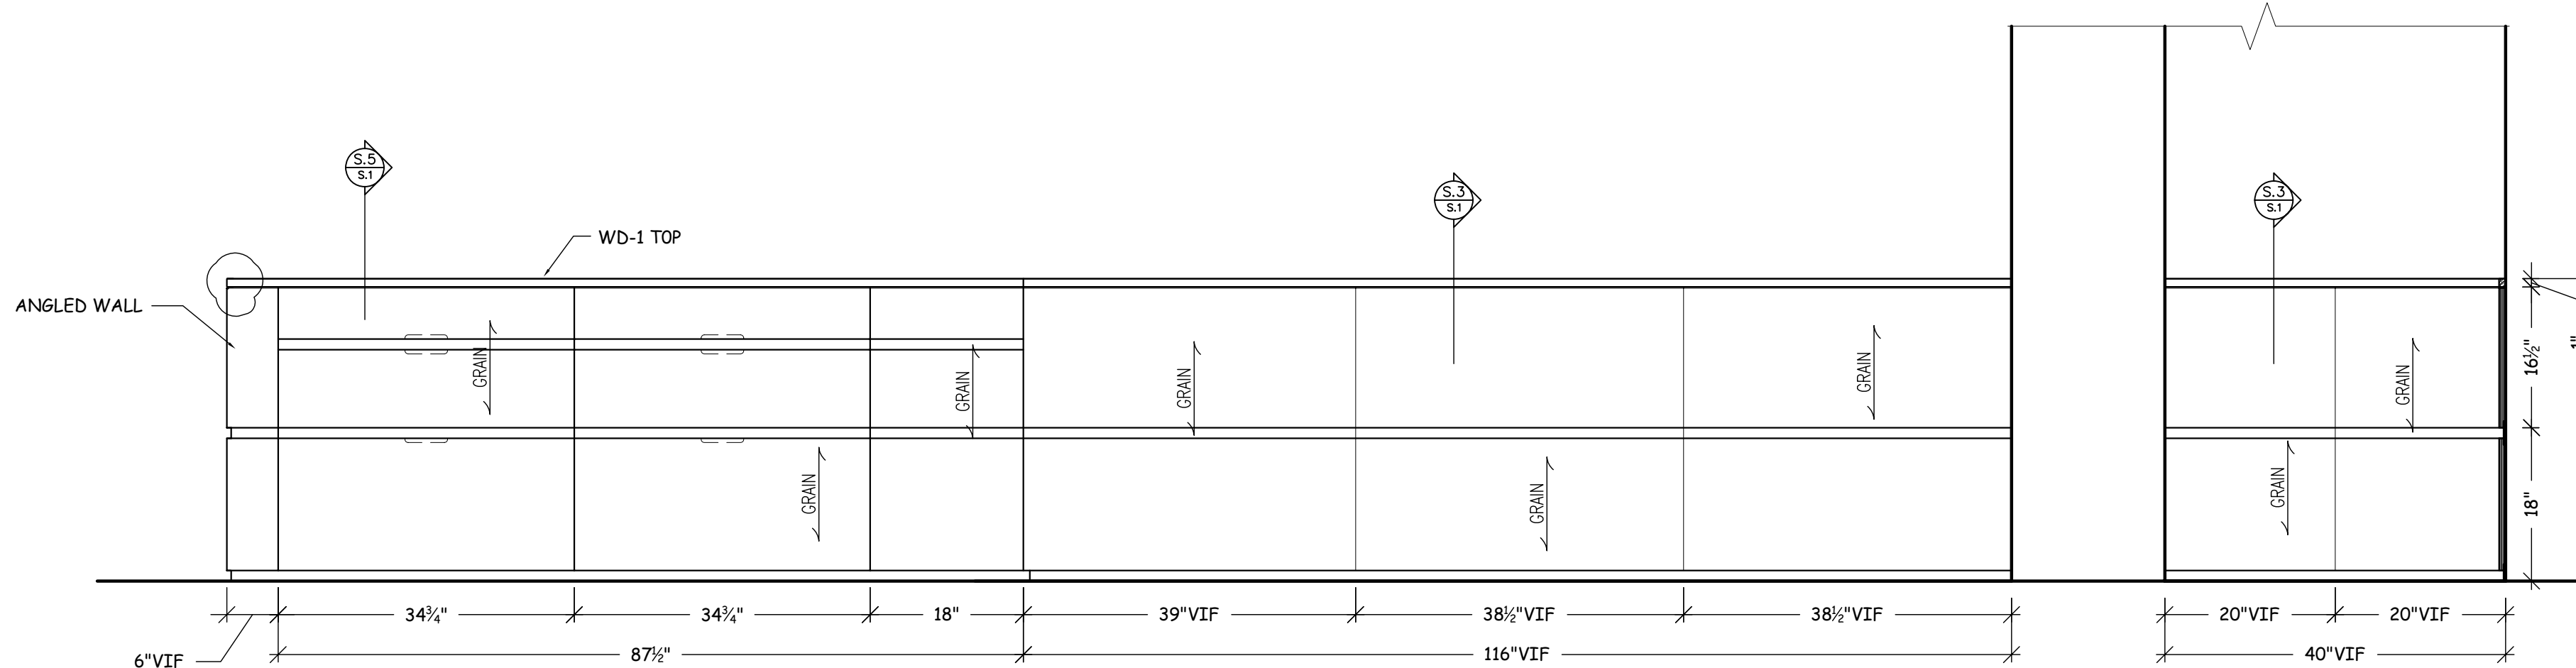

C ELEVATION- DINING RM. KNEE WALL BUFFET
SCALE: 3/4" = 1'-0"

General Notes
SHOP NOTES:

N&N Architectural Drafting Service
Computer Aided Design & Drafting/ CNC Programming


LEGEND:
VIEW
SHEET NO.
DIRECTION OF VIEW

Drawn by Neno K.

No.	Revision/Issue	Date
1	MARKUP PER OWNER/ARCH.	2-27

DRAWING RECORD

ARCHITECT:	
CONTRACTOR:	
Project Name and Address:	
Project: DINING ROOM	Sheet: A-1
Date: 2-05-07	
JOB # : *	

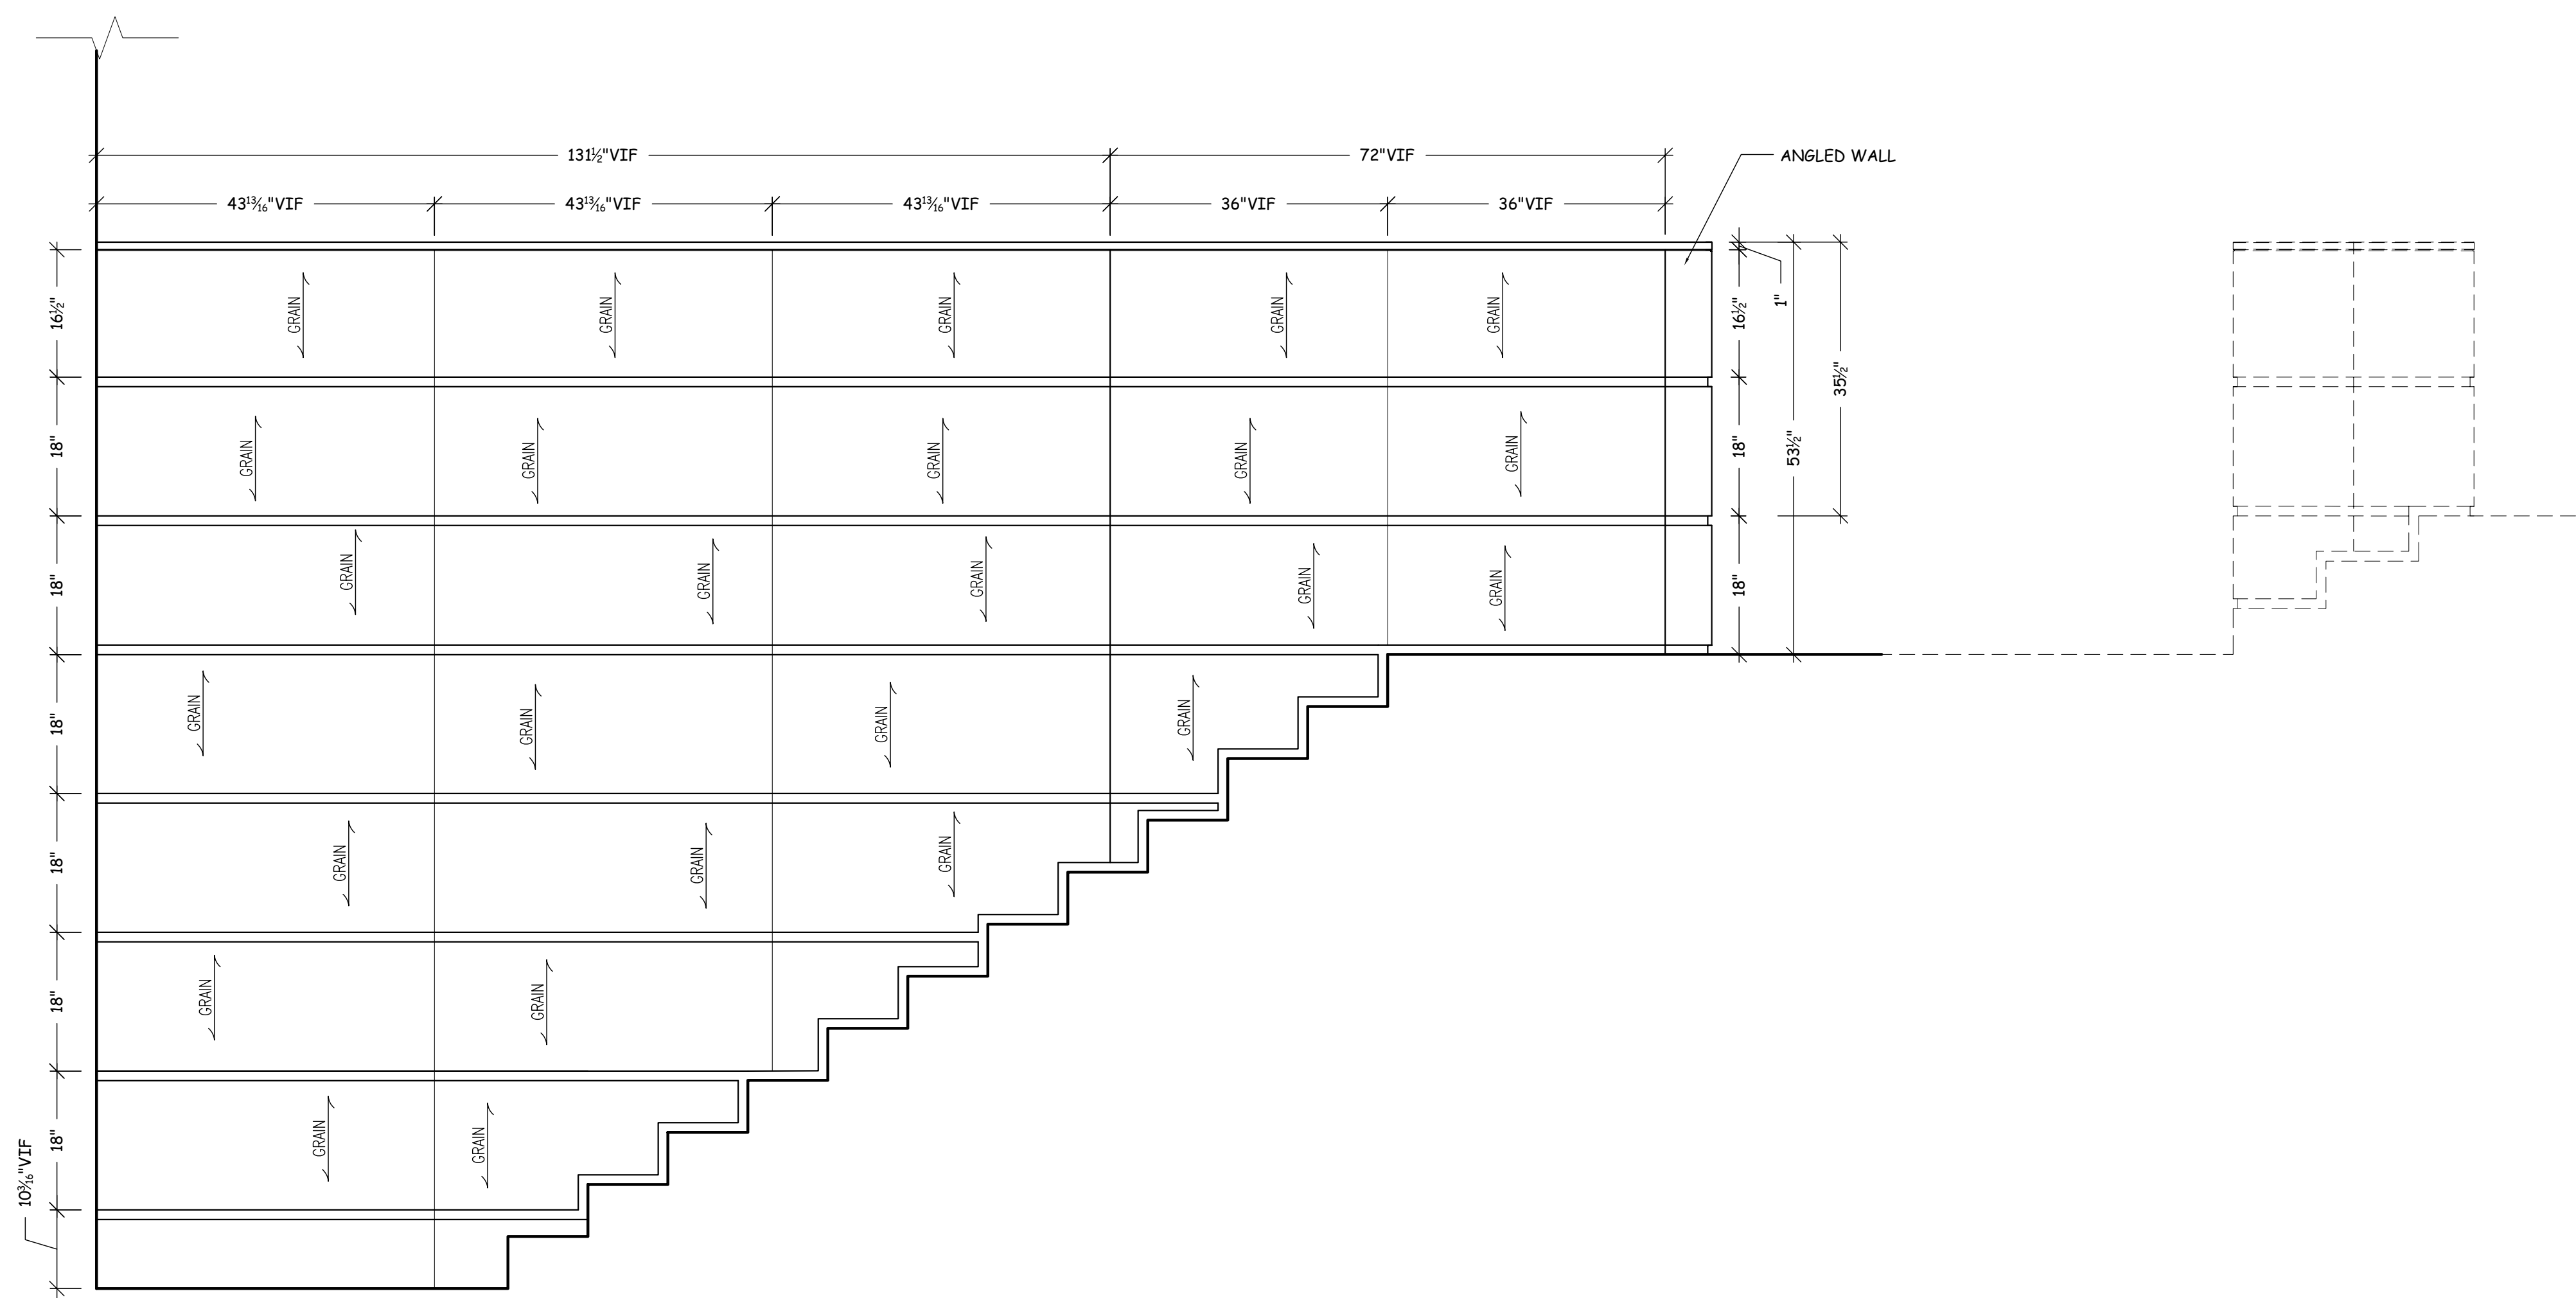


E ELEVATION-STAIRWAY
SCALE: 3/4" = 1'-0"

General Notes

SHOP NOTES:

N&N Architectural Drafting Service
Computer Aided Design & Drafting/ CNC Programming

LEGEND:

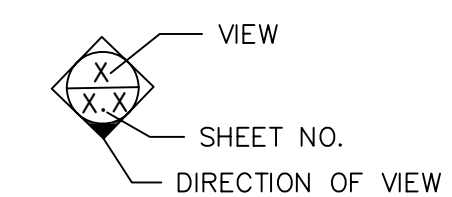

Drawn by Neno K.

No.	Revision/Issue	Date
1	MARKUP PER OWNER/ARCH.	2-27

DRAWING RECORD

ARCHITECT:

CONTRACTOR:



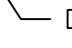
Project Name and Address:

Project:	STAIRWAY	Sheet:	A-2
Date:	2-05-07		
JOB # :	*		

General Notes

SHOP NOTES:

N&N Architectural Drafting Service
 Computer Aided Design & Drafting/ CNC Programming

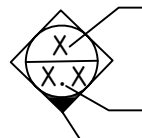LEGEND:
 VIEW
 SHEET NO.
 DIRECTION OF VIEW


Drawn by Nono K.

No.	Revision/Issue	Date
1	MARKUP PER OWNER/ARCH.	2-27


DRAWING RECORD

ARCHITECT:
 CONTRACTOR:
 Project Name and Address:


Project: **DINING/ KITCHEN** Sheet:
 Date: **2-05-07** **A-3**
 JOB # : *

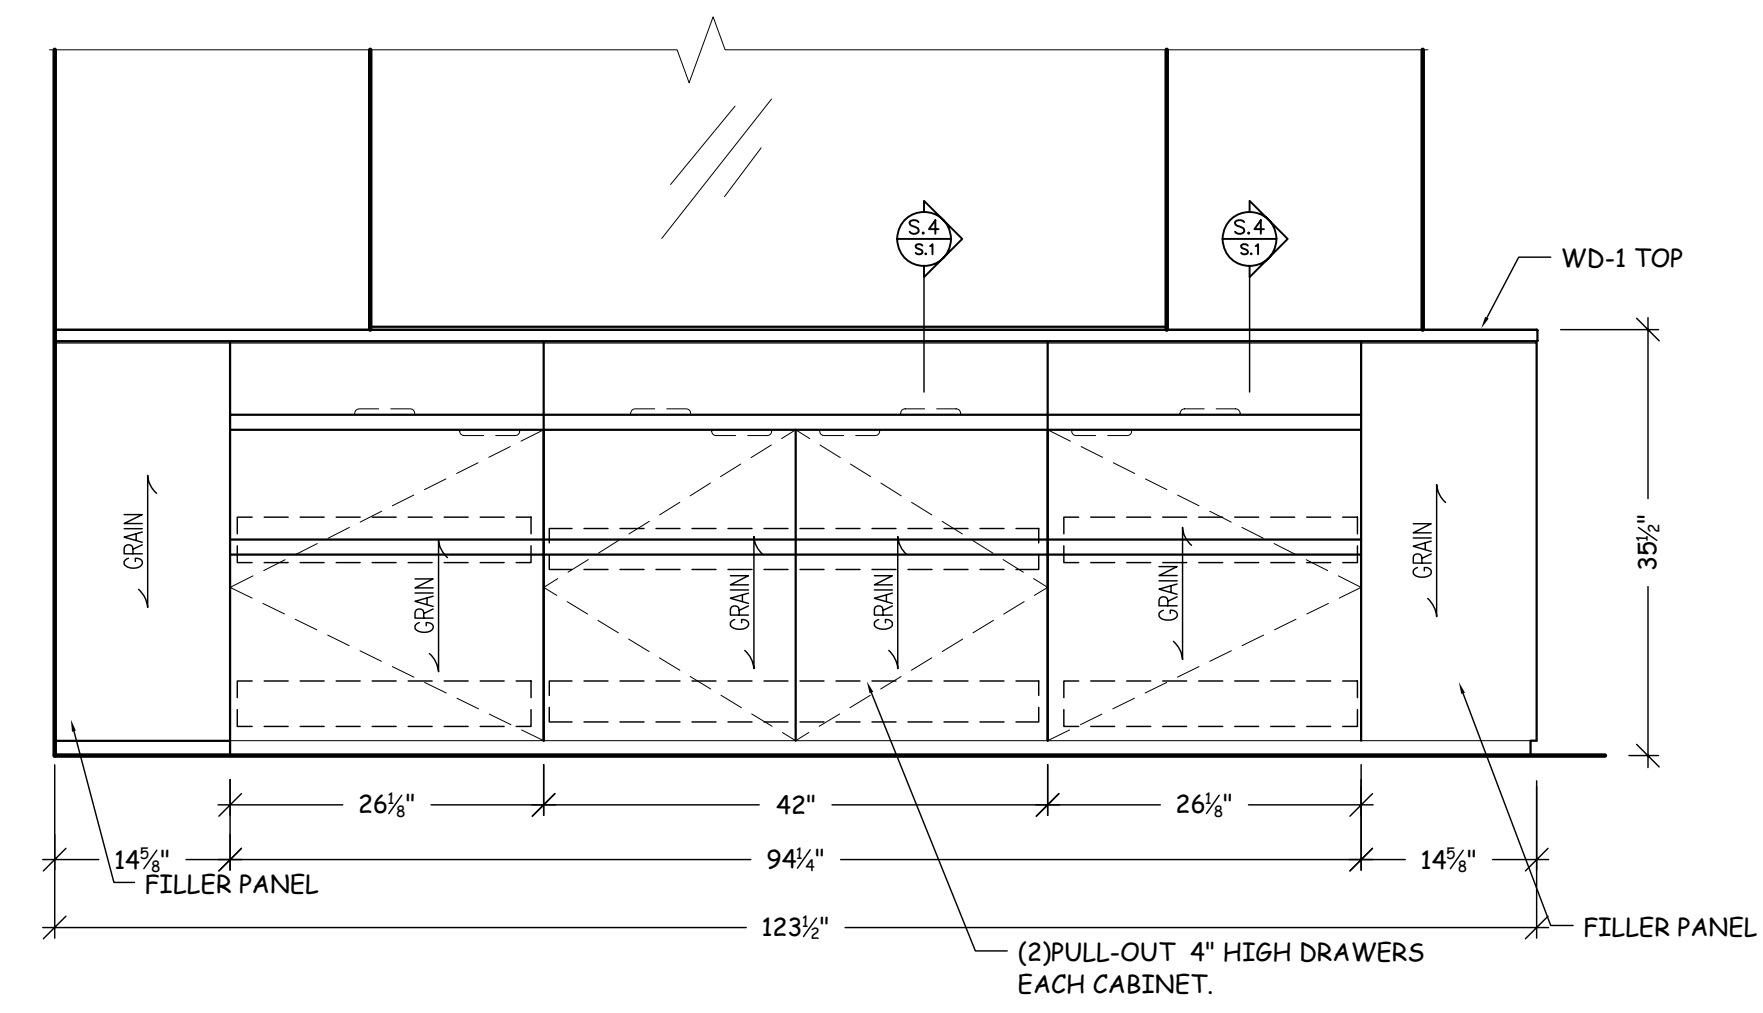






F ELEVATION-BUFFET DINING RM.
 SCALE: 3/4" = 1'-0"

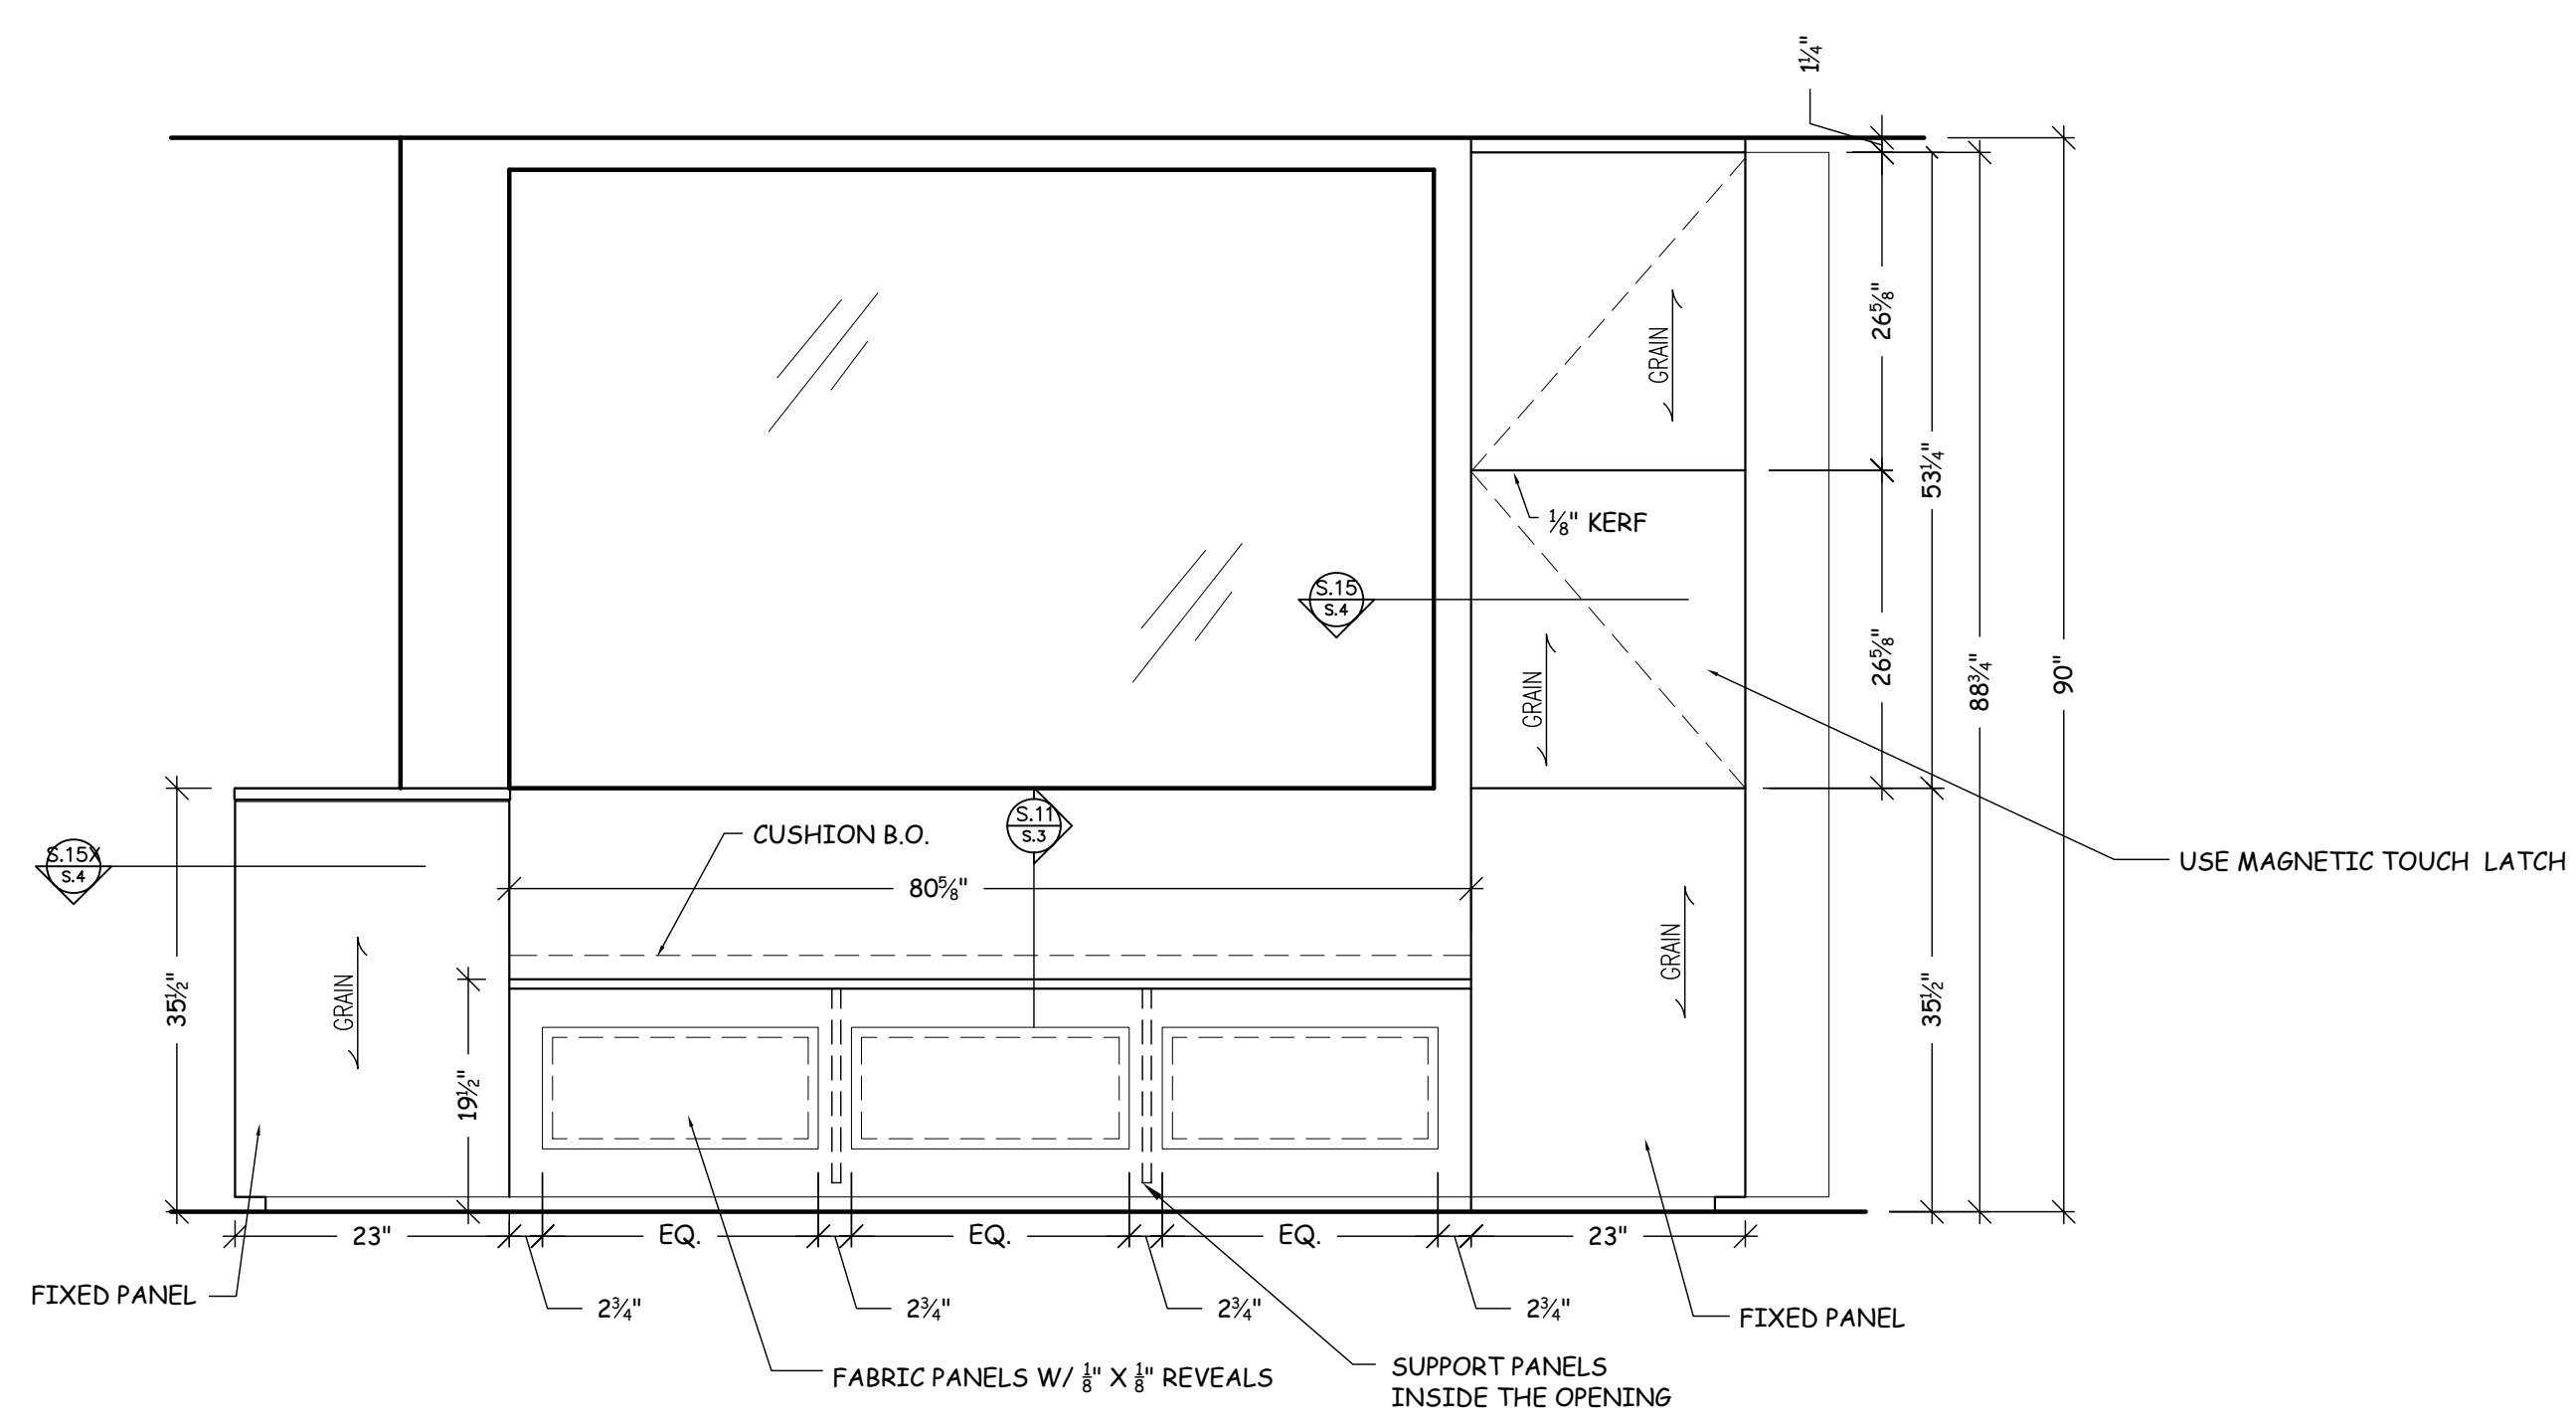

G ELEVATION-BENCH SEAT (KITCHEN)
 SCALE: 3/4" = 1'-0"

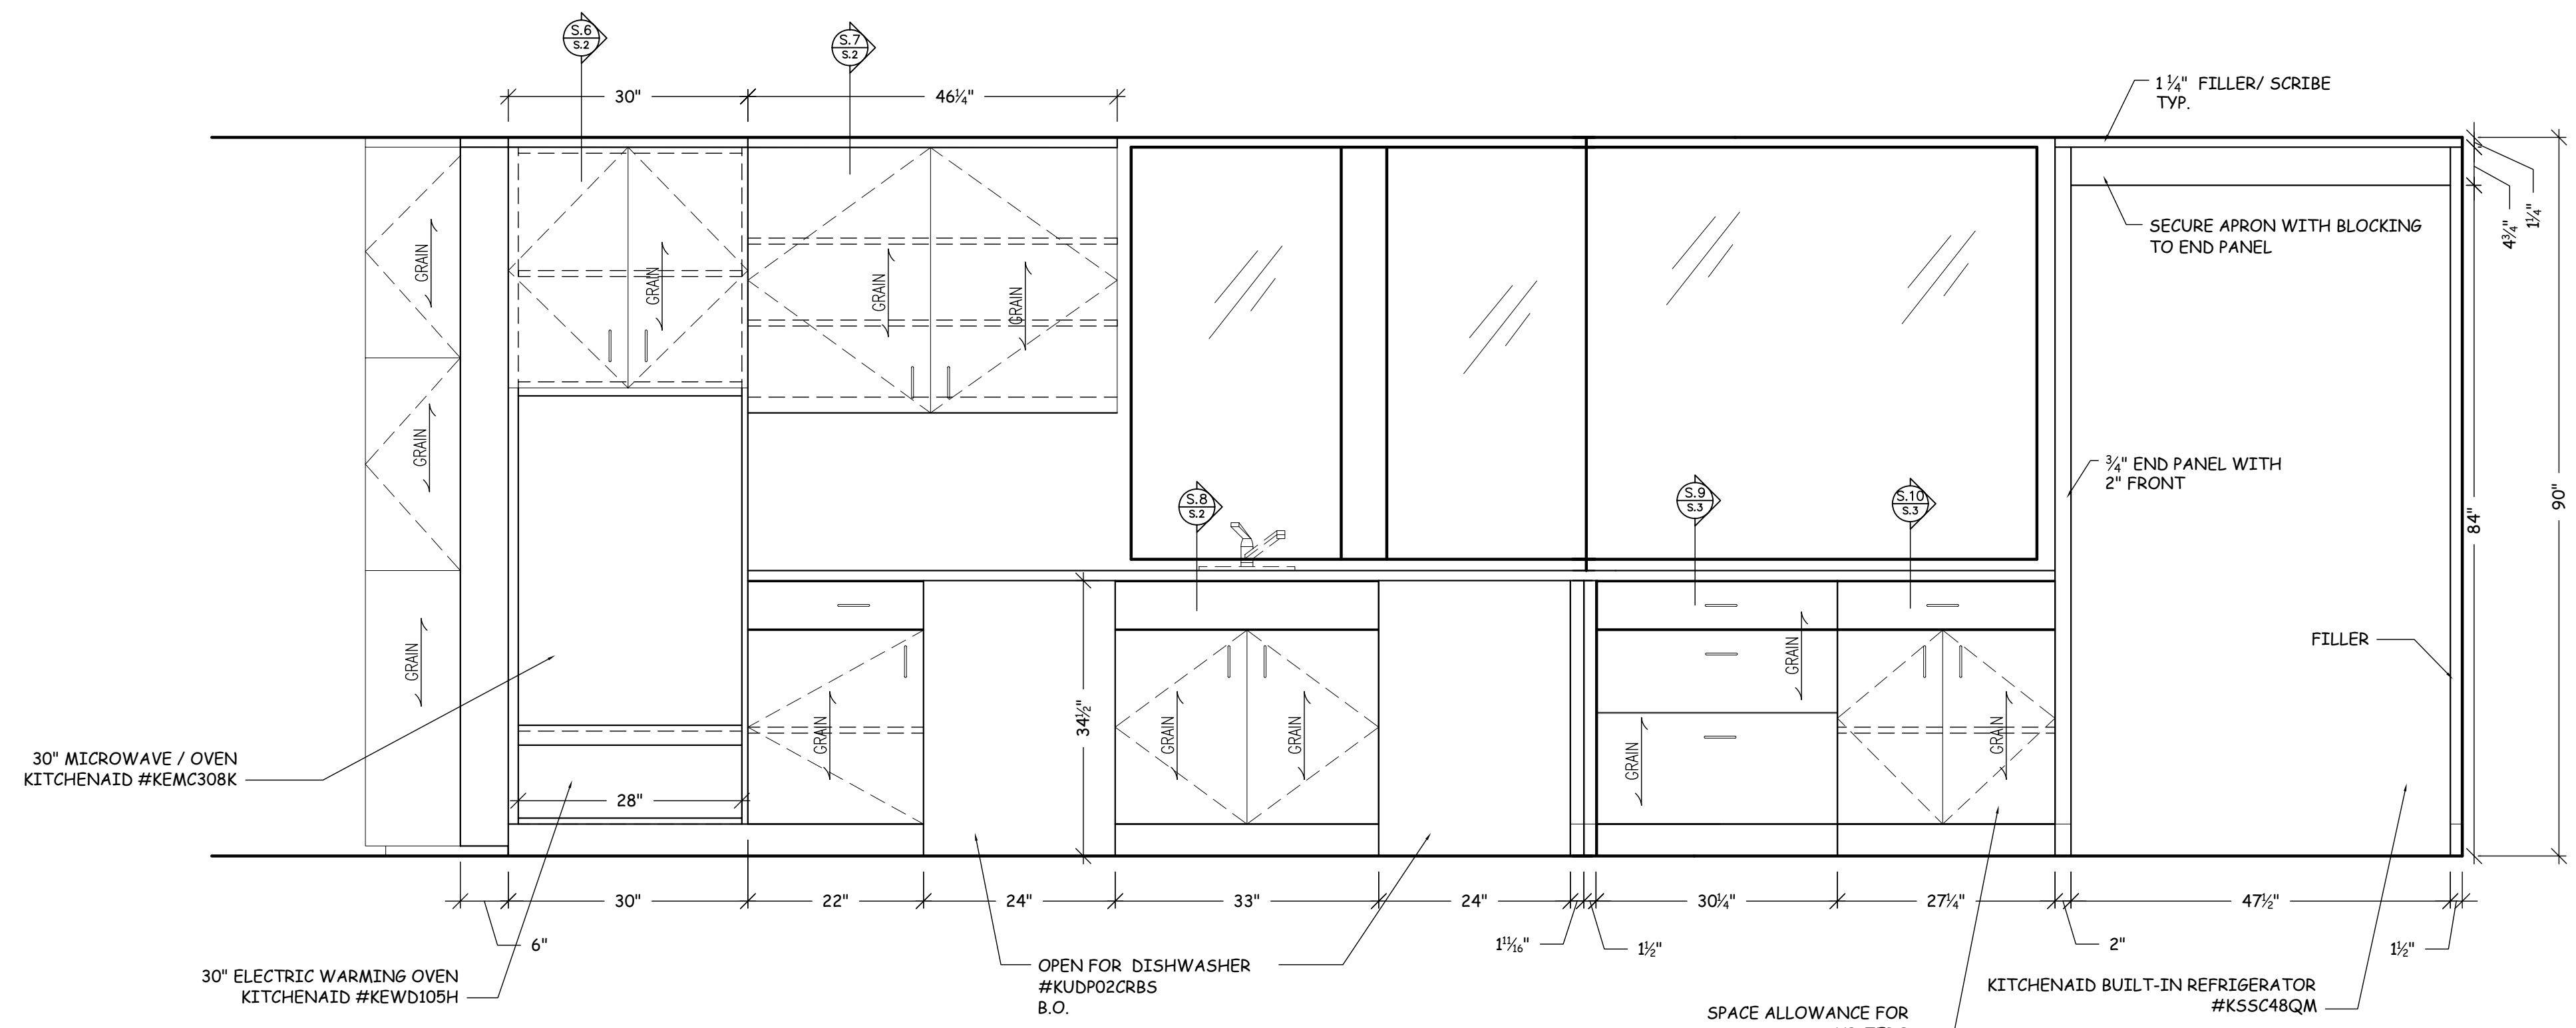

H ELEVATION-KITCHEN
 SCALE: 3/4" = 1'-0"

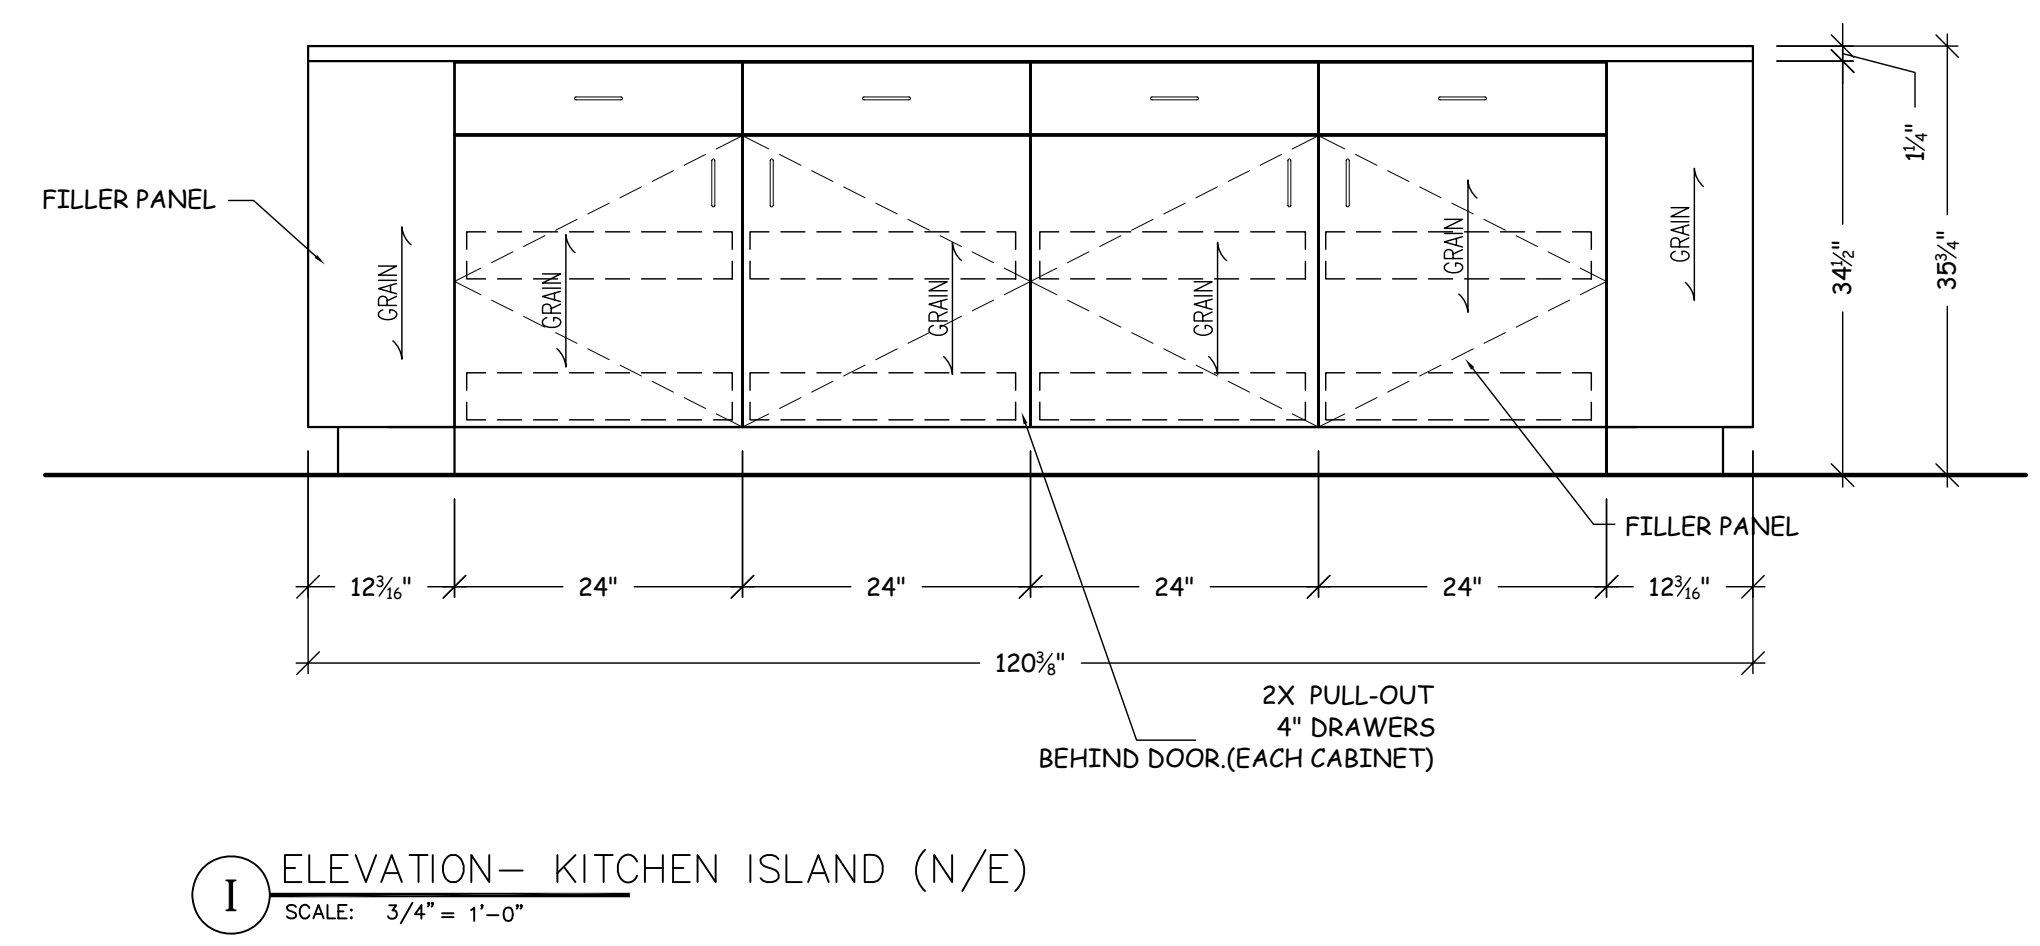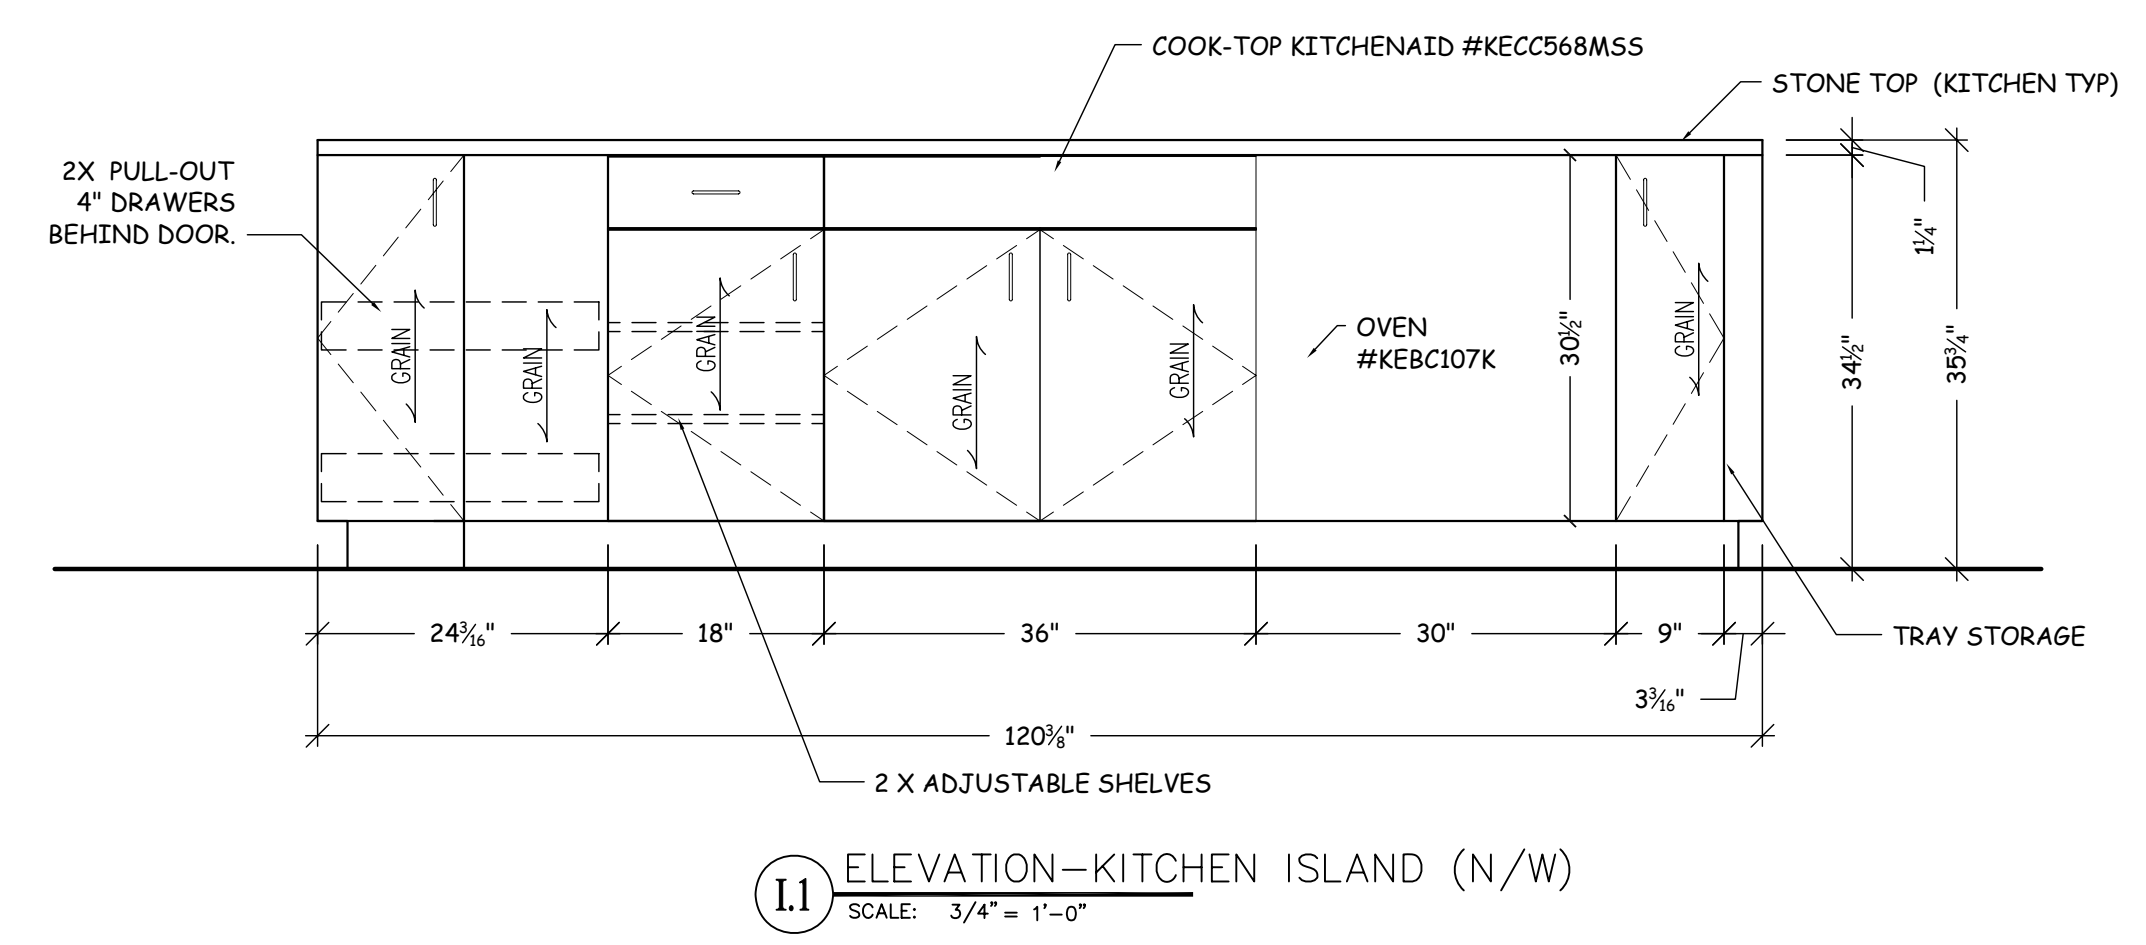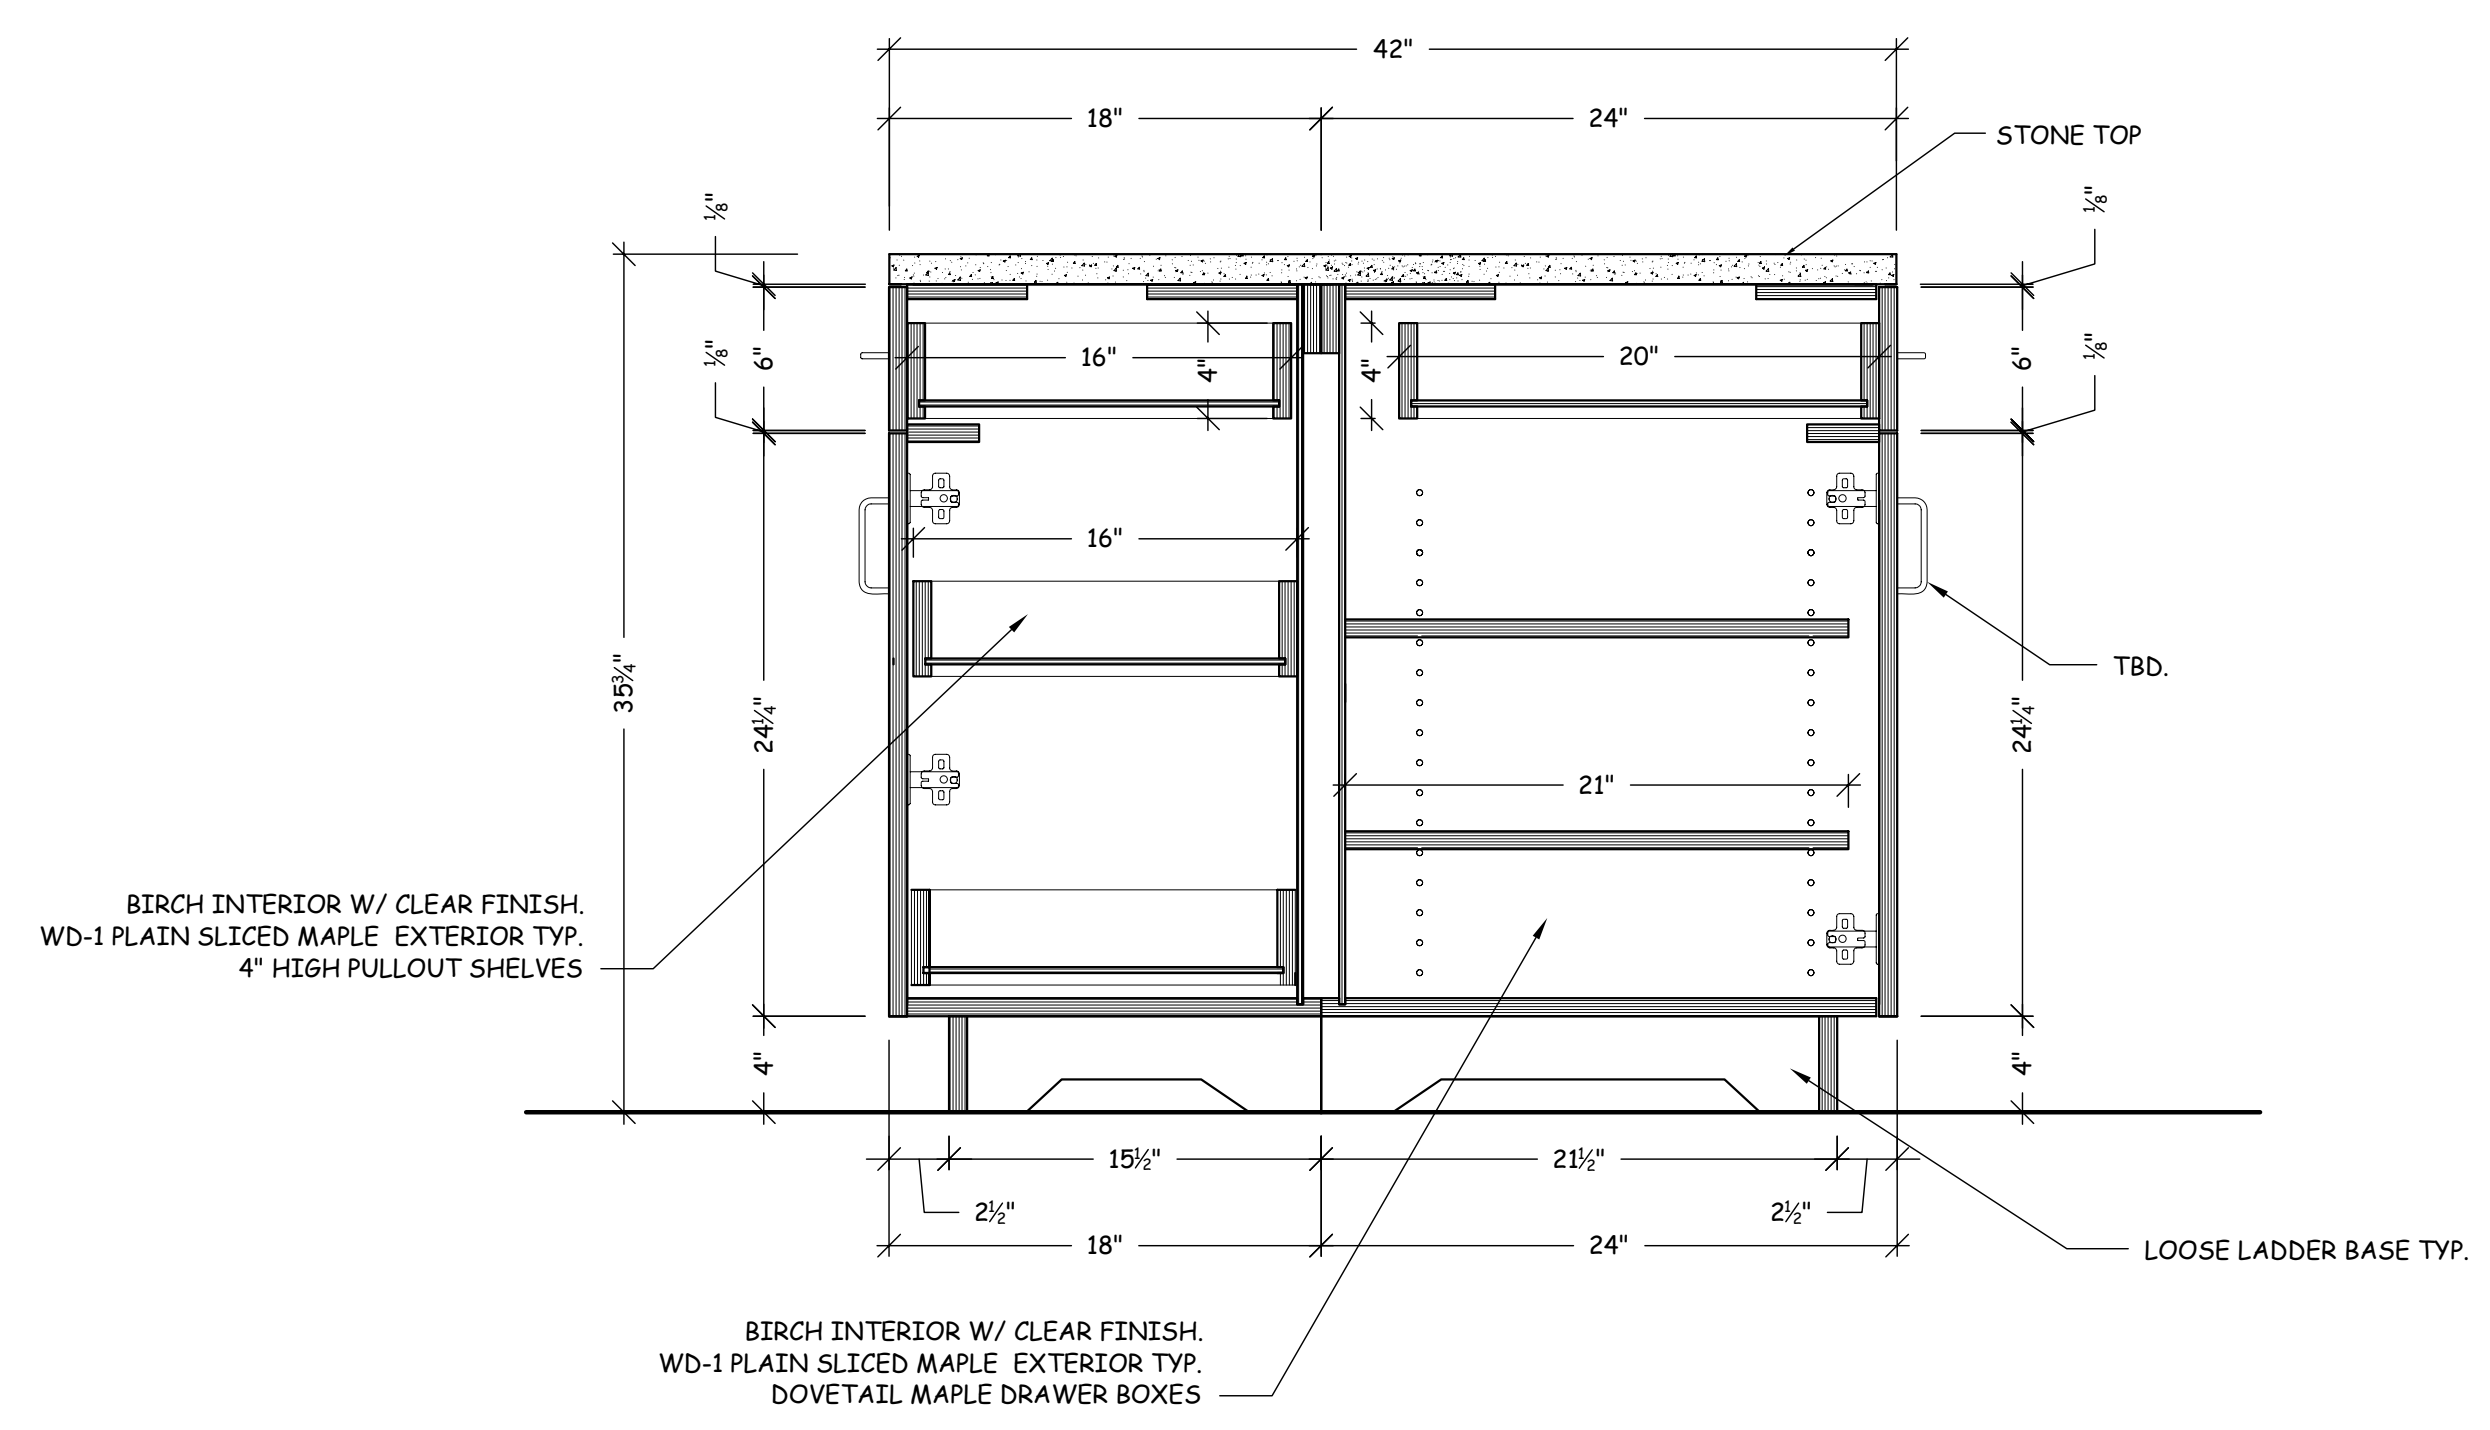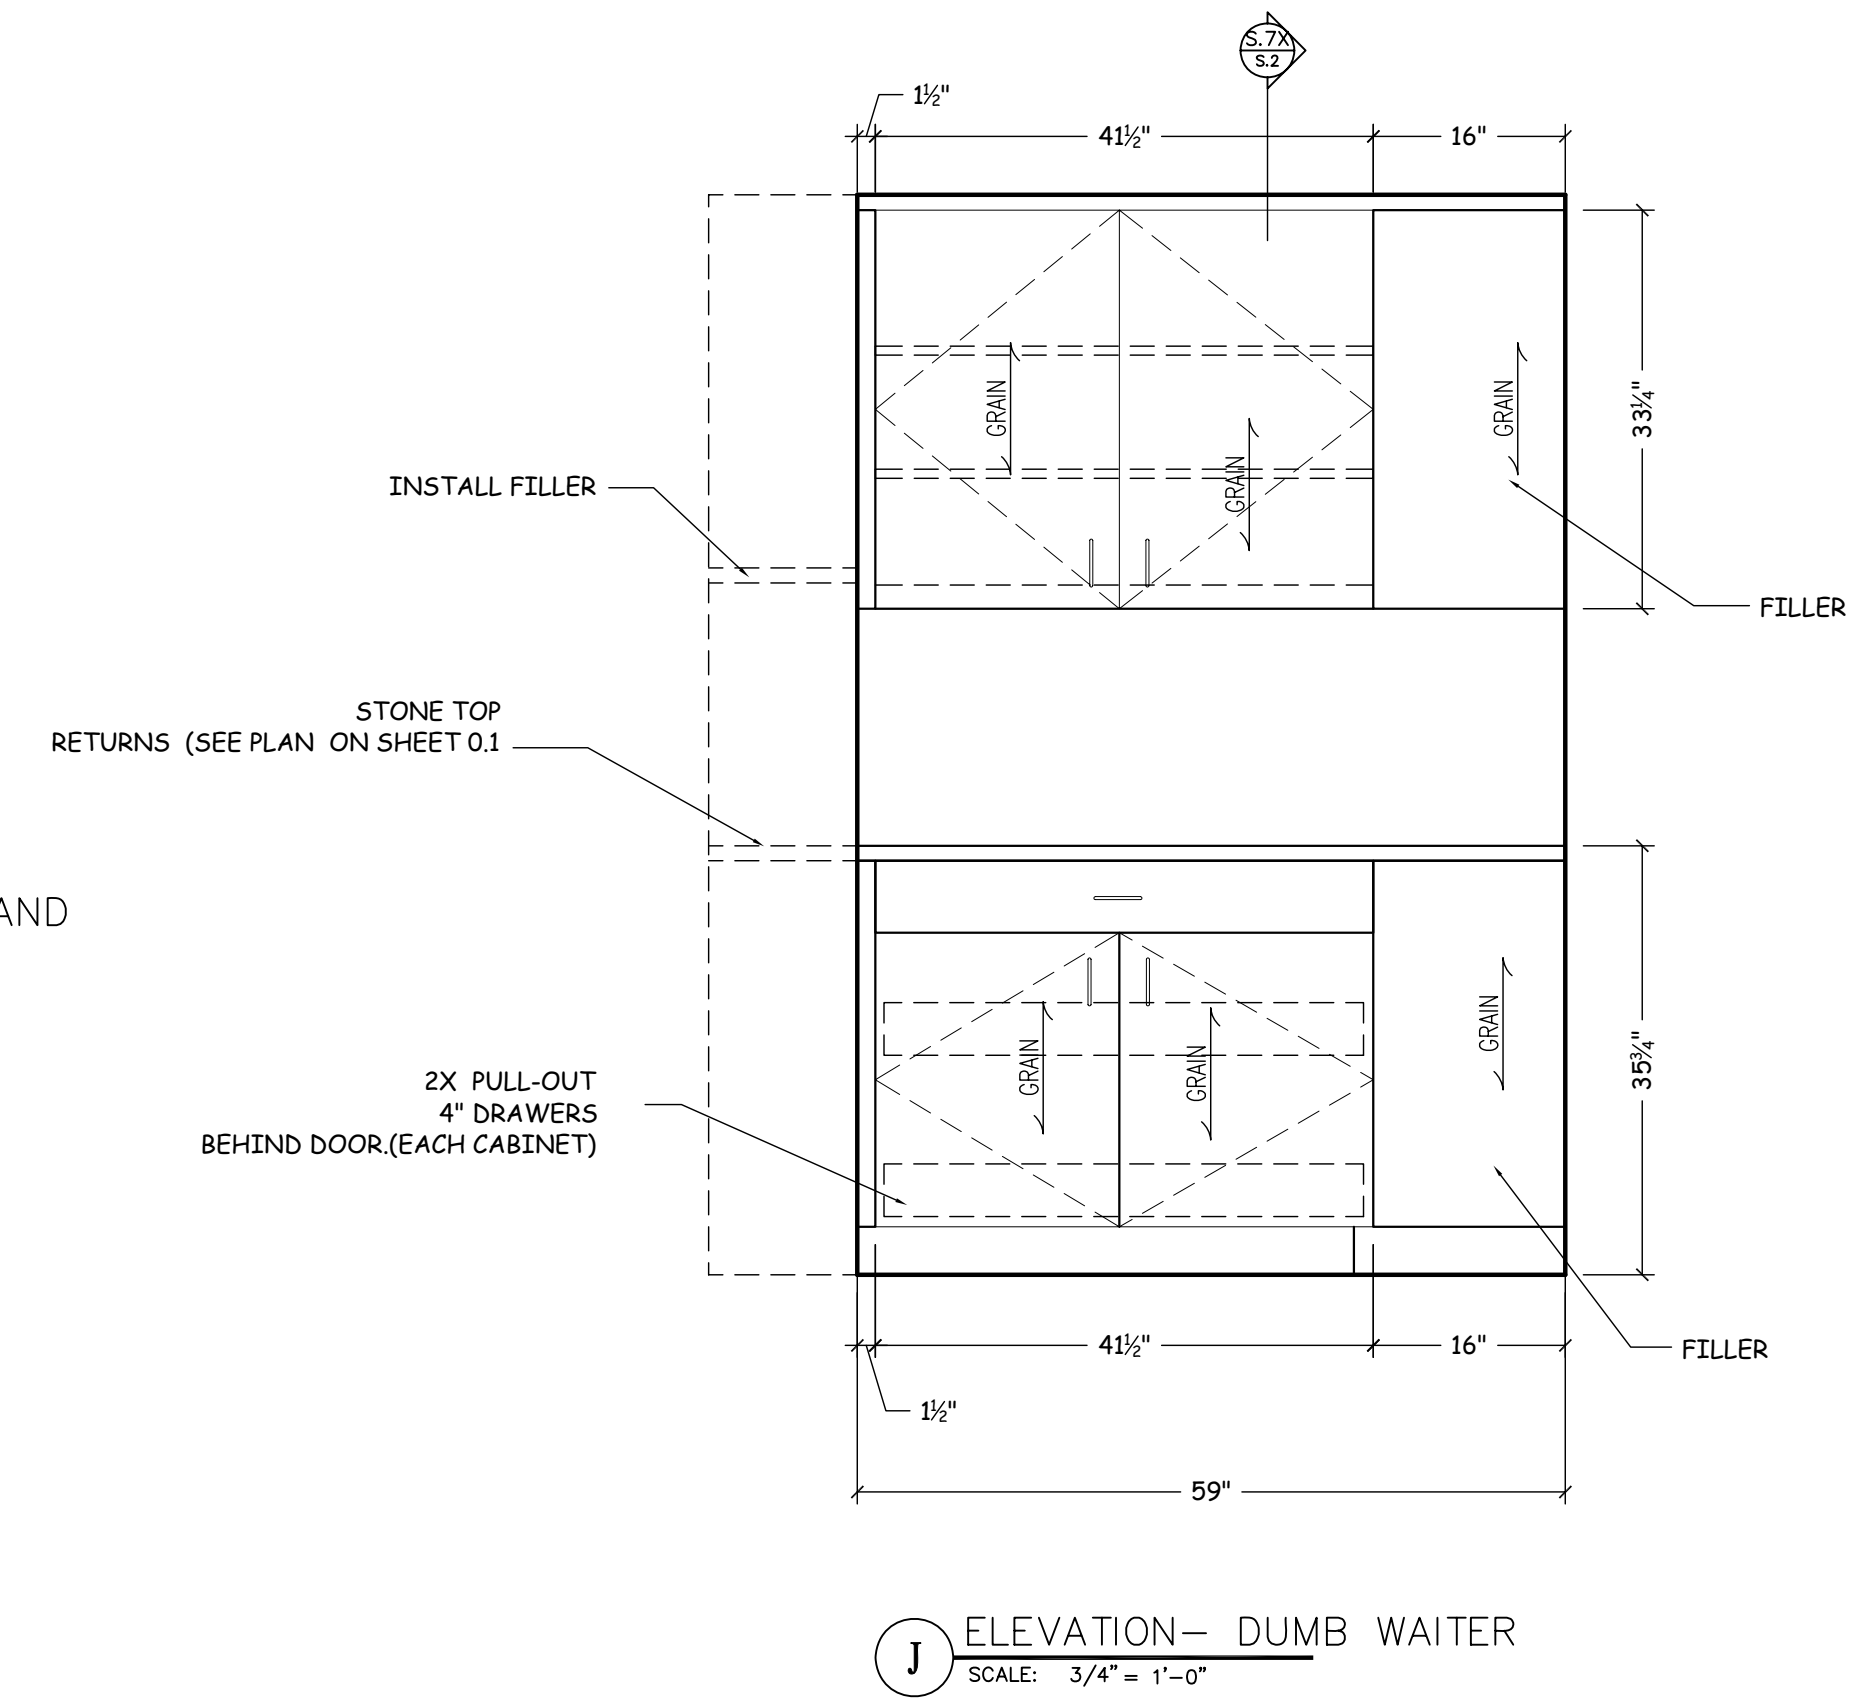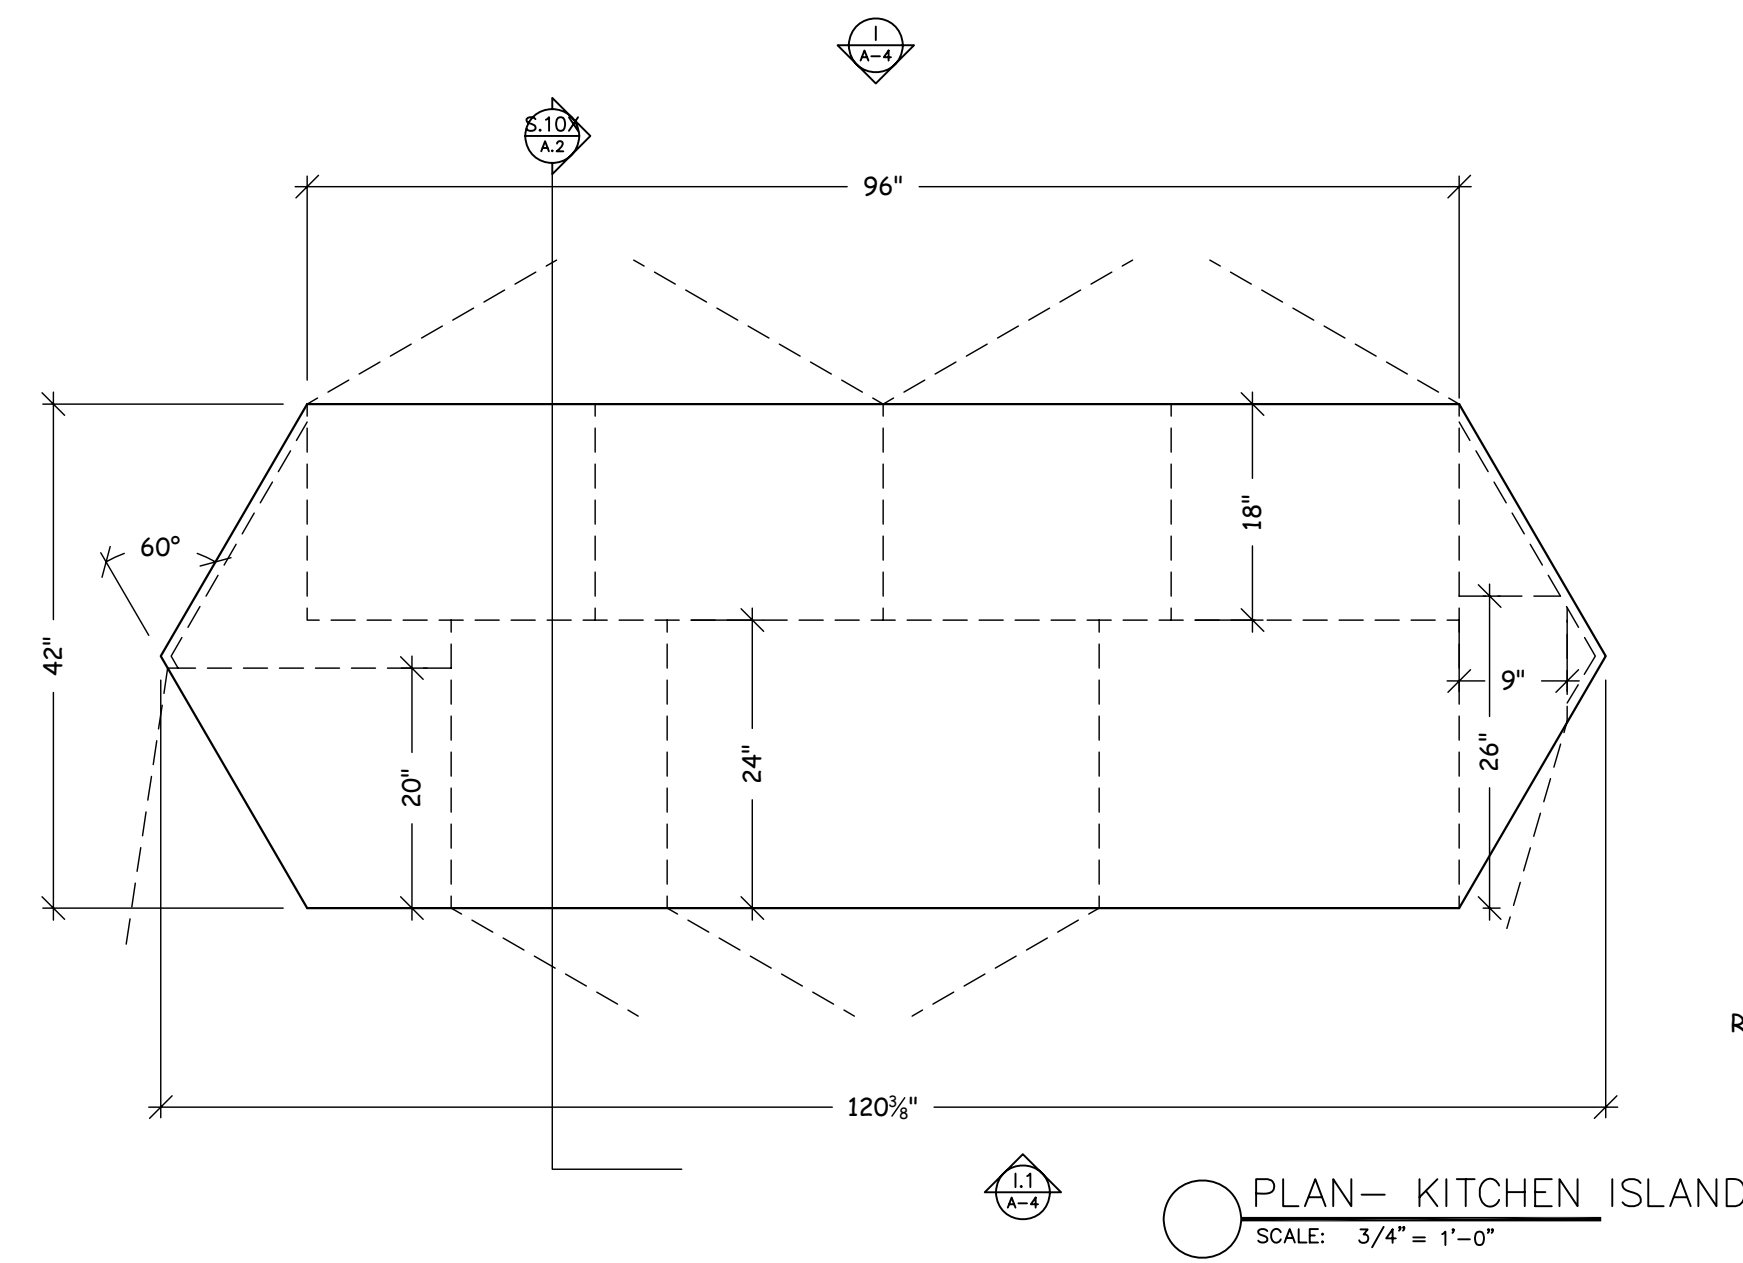

General Notes
SHOP NOTES:

N&N Architectural Drafting Service
Computer Aided Design & Drafting/ CNC Programming

LEGEND:


VIEW
 SHEET NO.
 DIRECTION OF VIEW

Drawn by Nono K.


No.	Revision/Issue	Date
1	MARKUP PER OWNER/ARCH.	2-27

DRAWING RECORD


ARCHITECT:	
CONTRACTOR:	
Project Name and Address:	
Project: KITCHEN	Sheet: A-4
Date: 2-05-07	
JOB # : *	

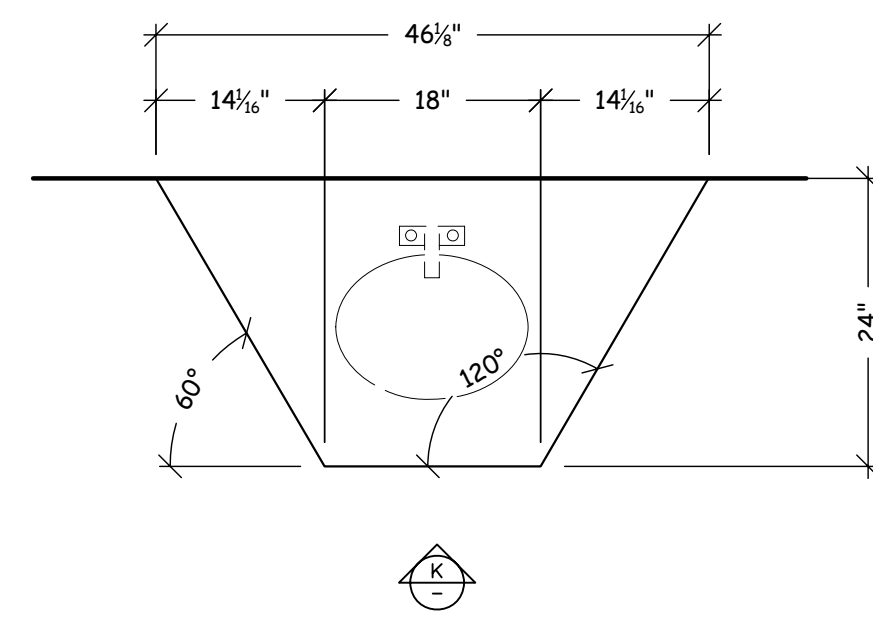


K PLAN- GUEST BATH
SCALE: 3/4" = 1'-0"

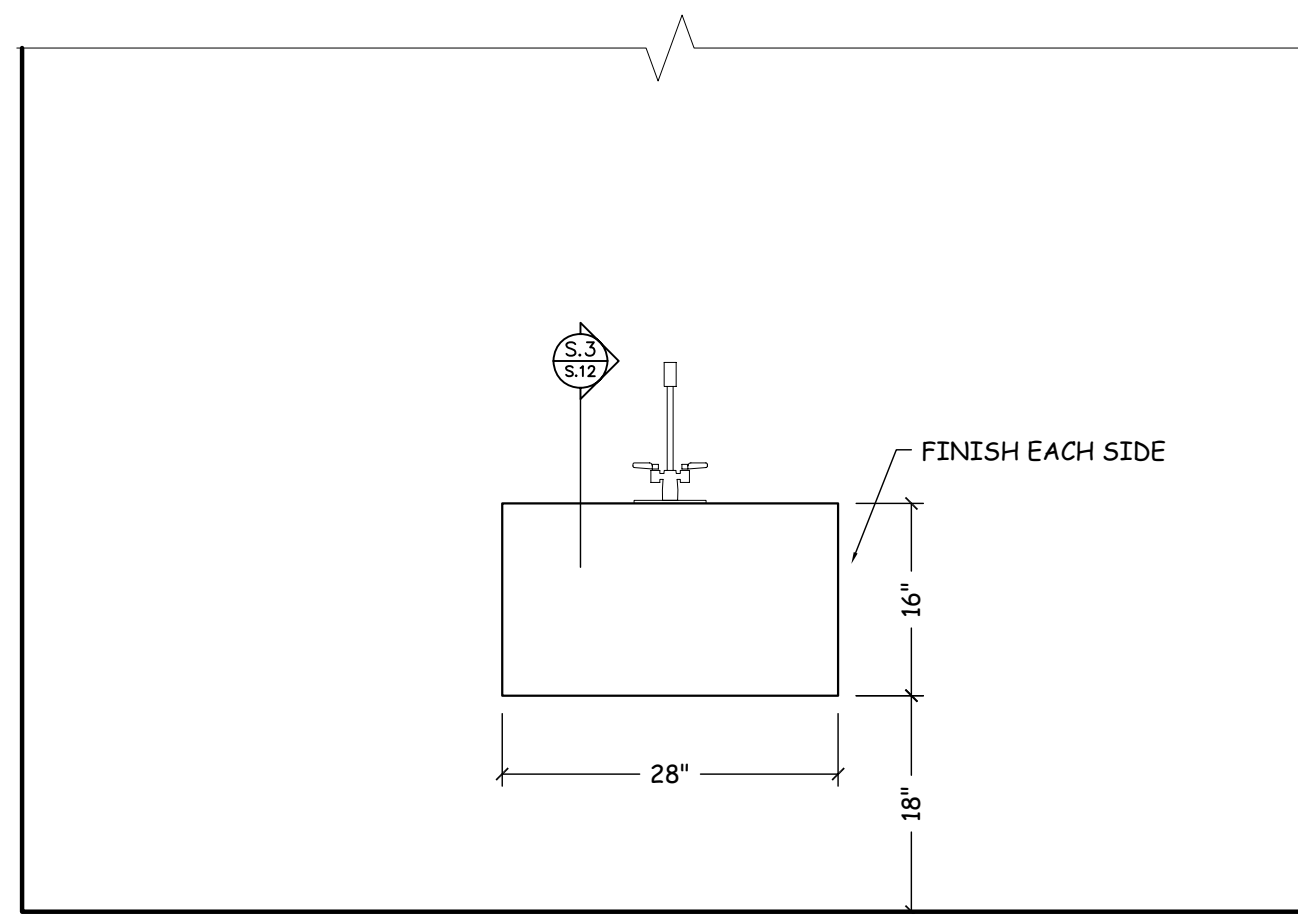

L ELEVATION-BATH #3
SCALE: 3/4" = 1'-0"

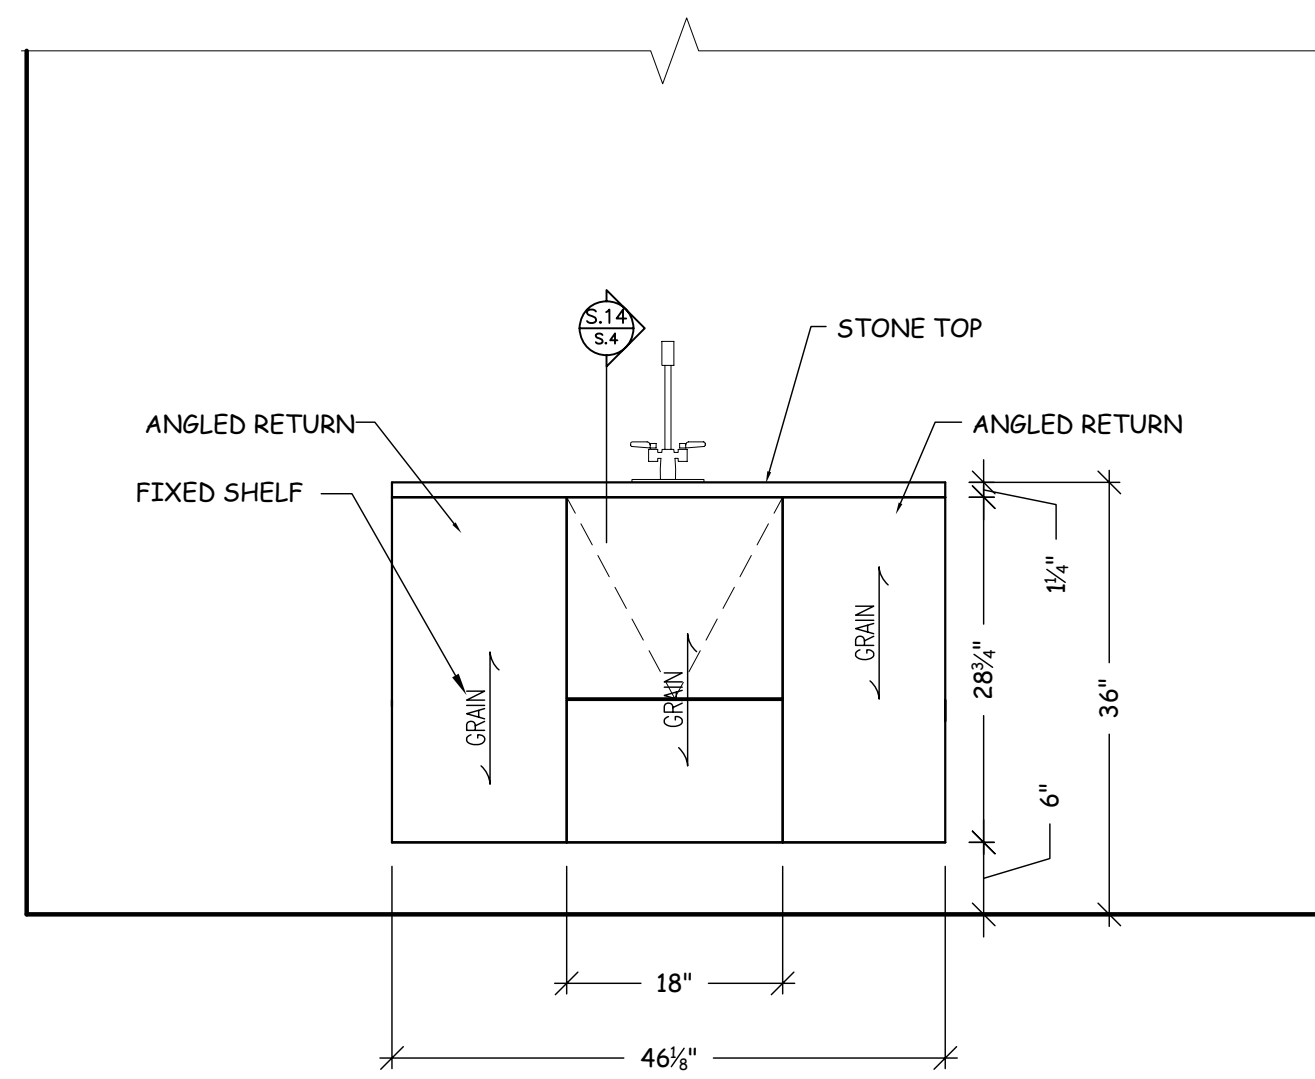

K ELEVATION- GUEST BATH
SCALE: 3/4" = 1'-0"

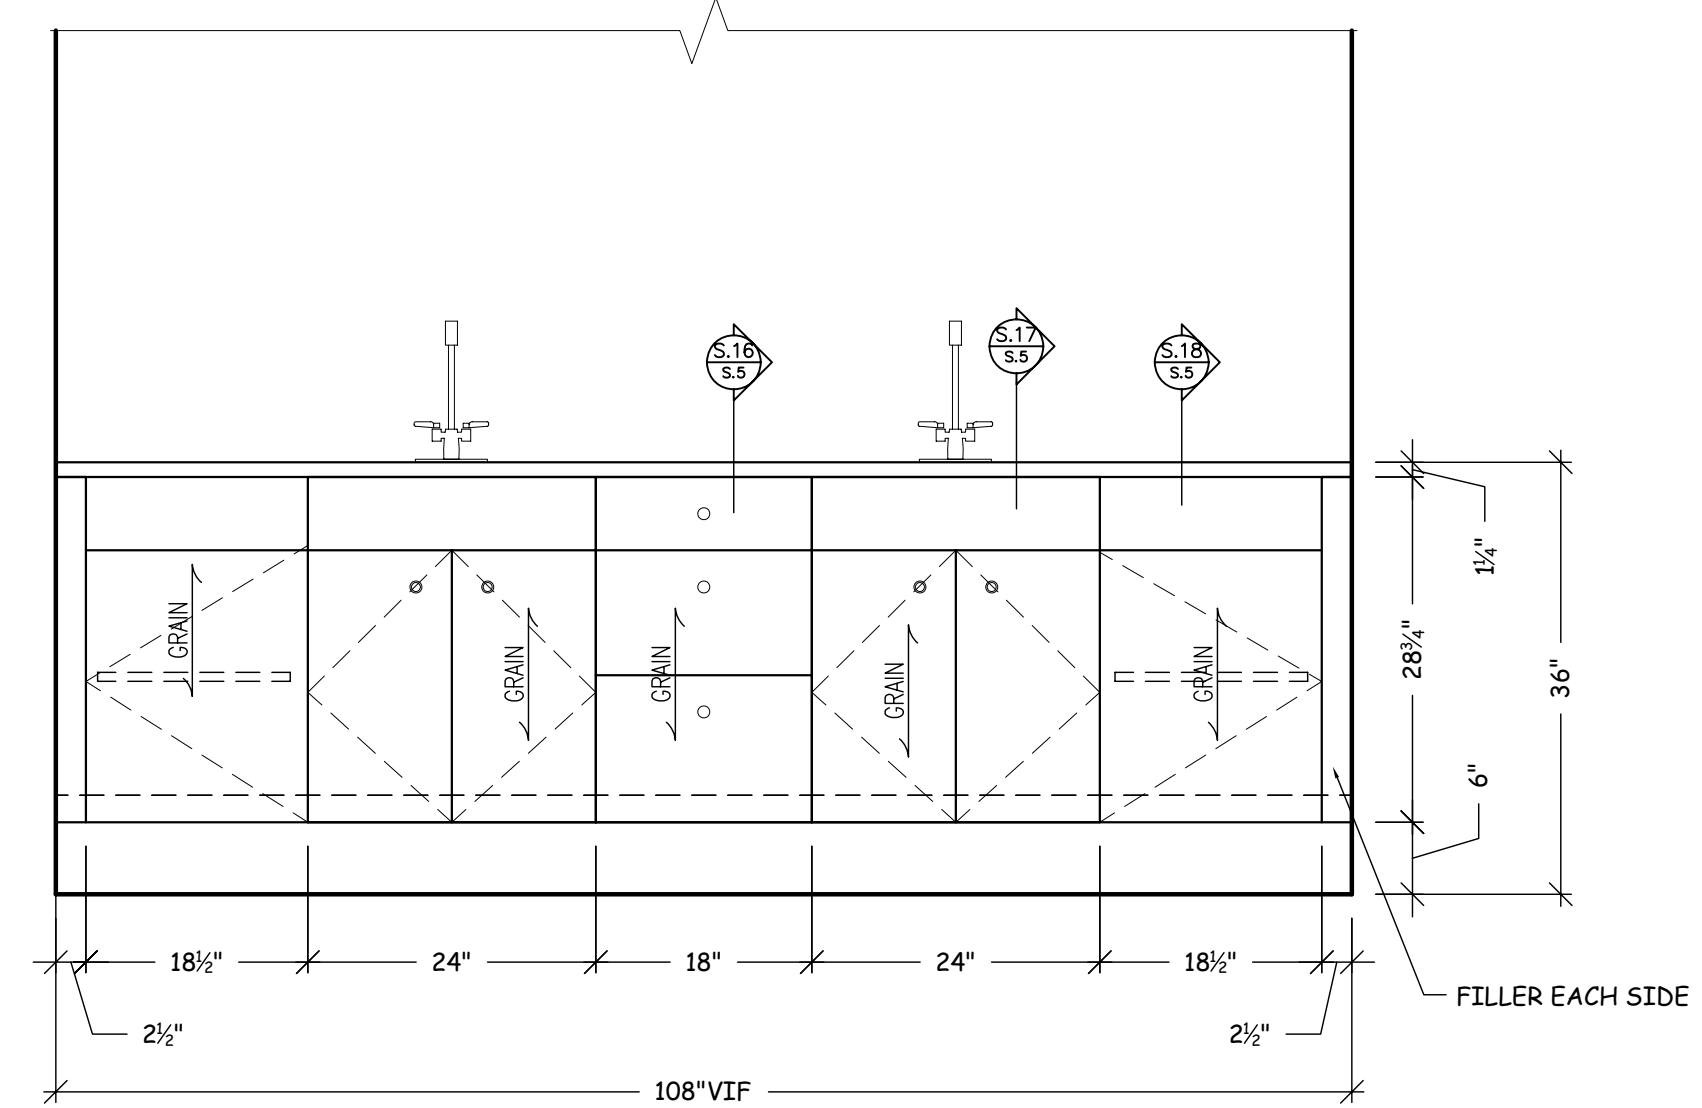


M ELEVATION-MBATH
SCALE: 3/4" = 1'-0"

General Notes

SHOP NOTES:

N&N Architectural Drafting Service
Computer Aided Design & Drafting/ CNC Programming

LEGEND:

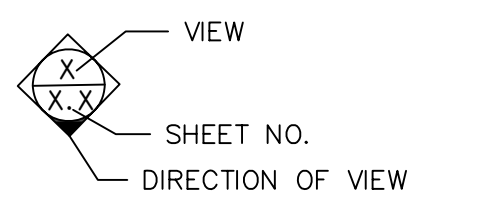

Drawn by Nono K.

No.	Revision/Issue	Date
1	MARKUP PER OWNER/ARCH.	2-27

DRAWING RECORD

ARCHITECT:

CONTRACTOR:

Project Name and Address:


Project: BATH'S

Date: 2-05-07

JOB # : *

Sheet:

A-5

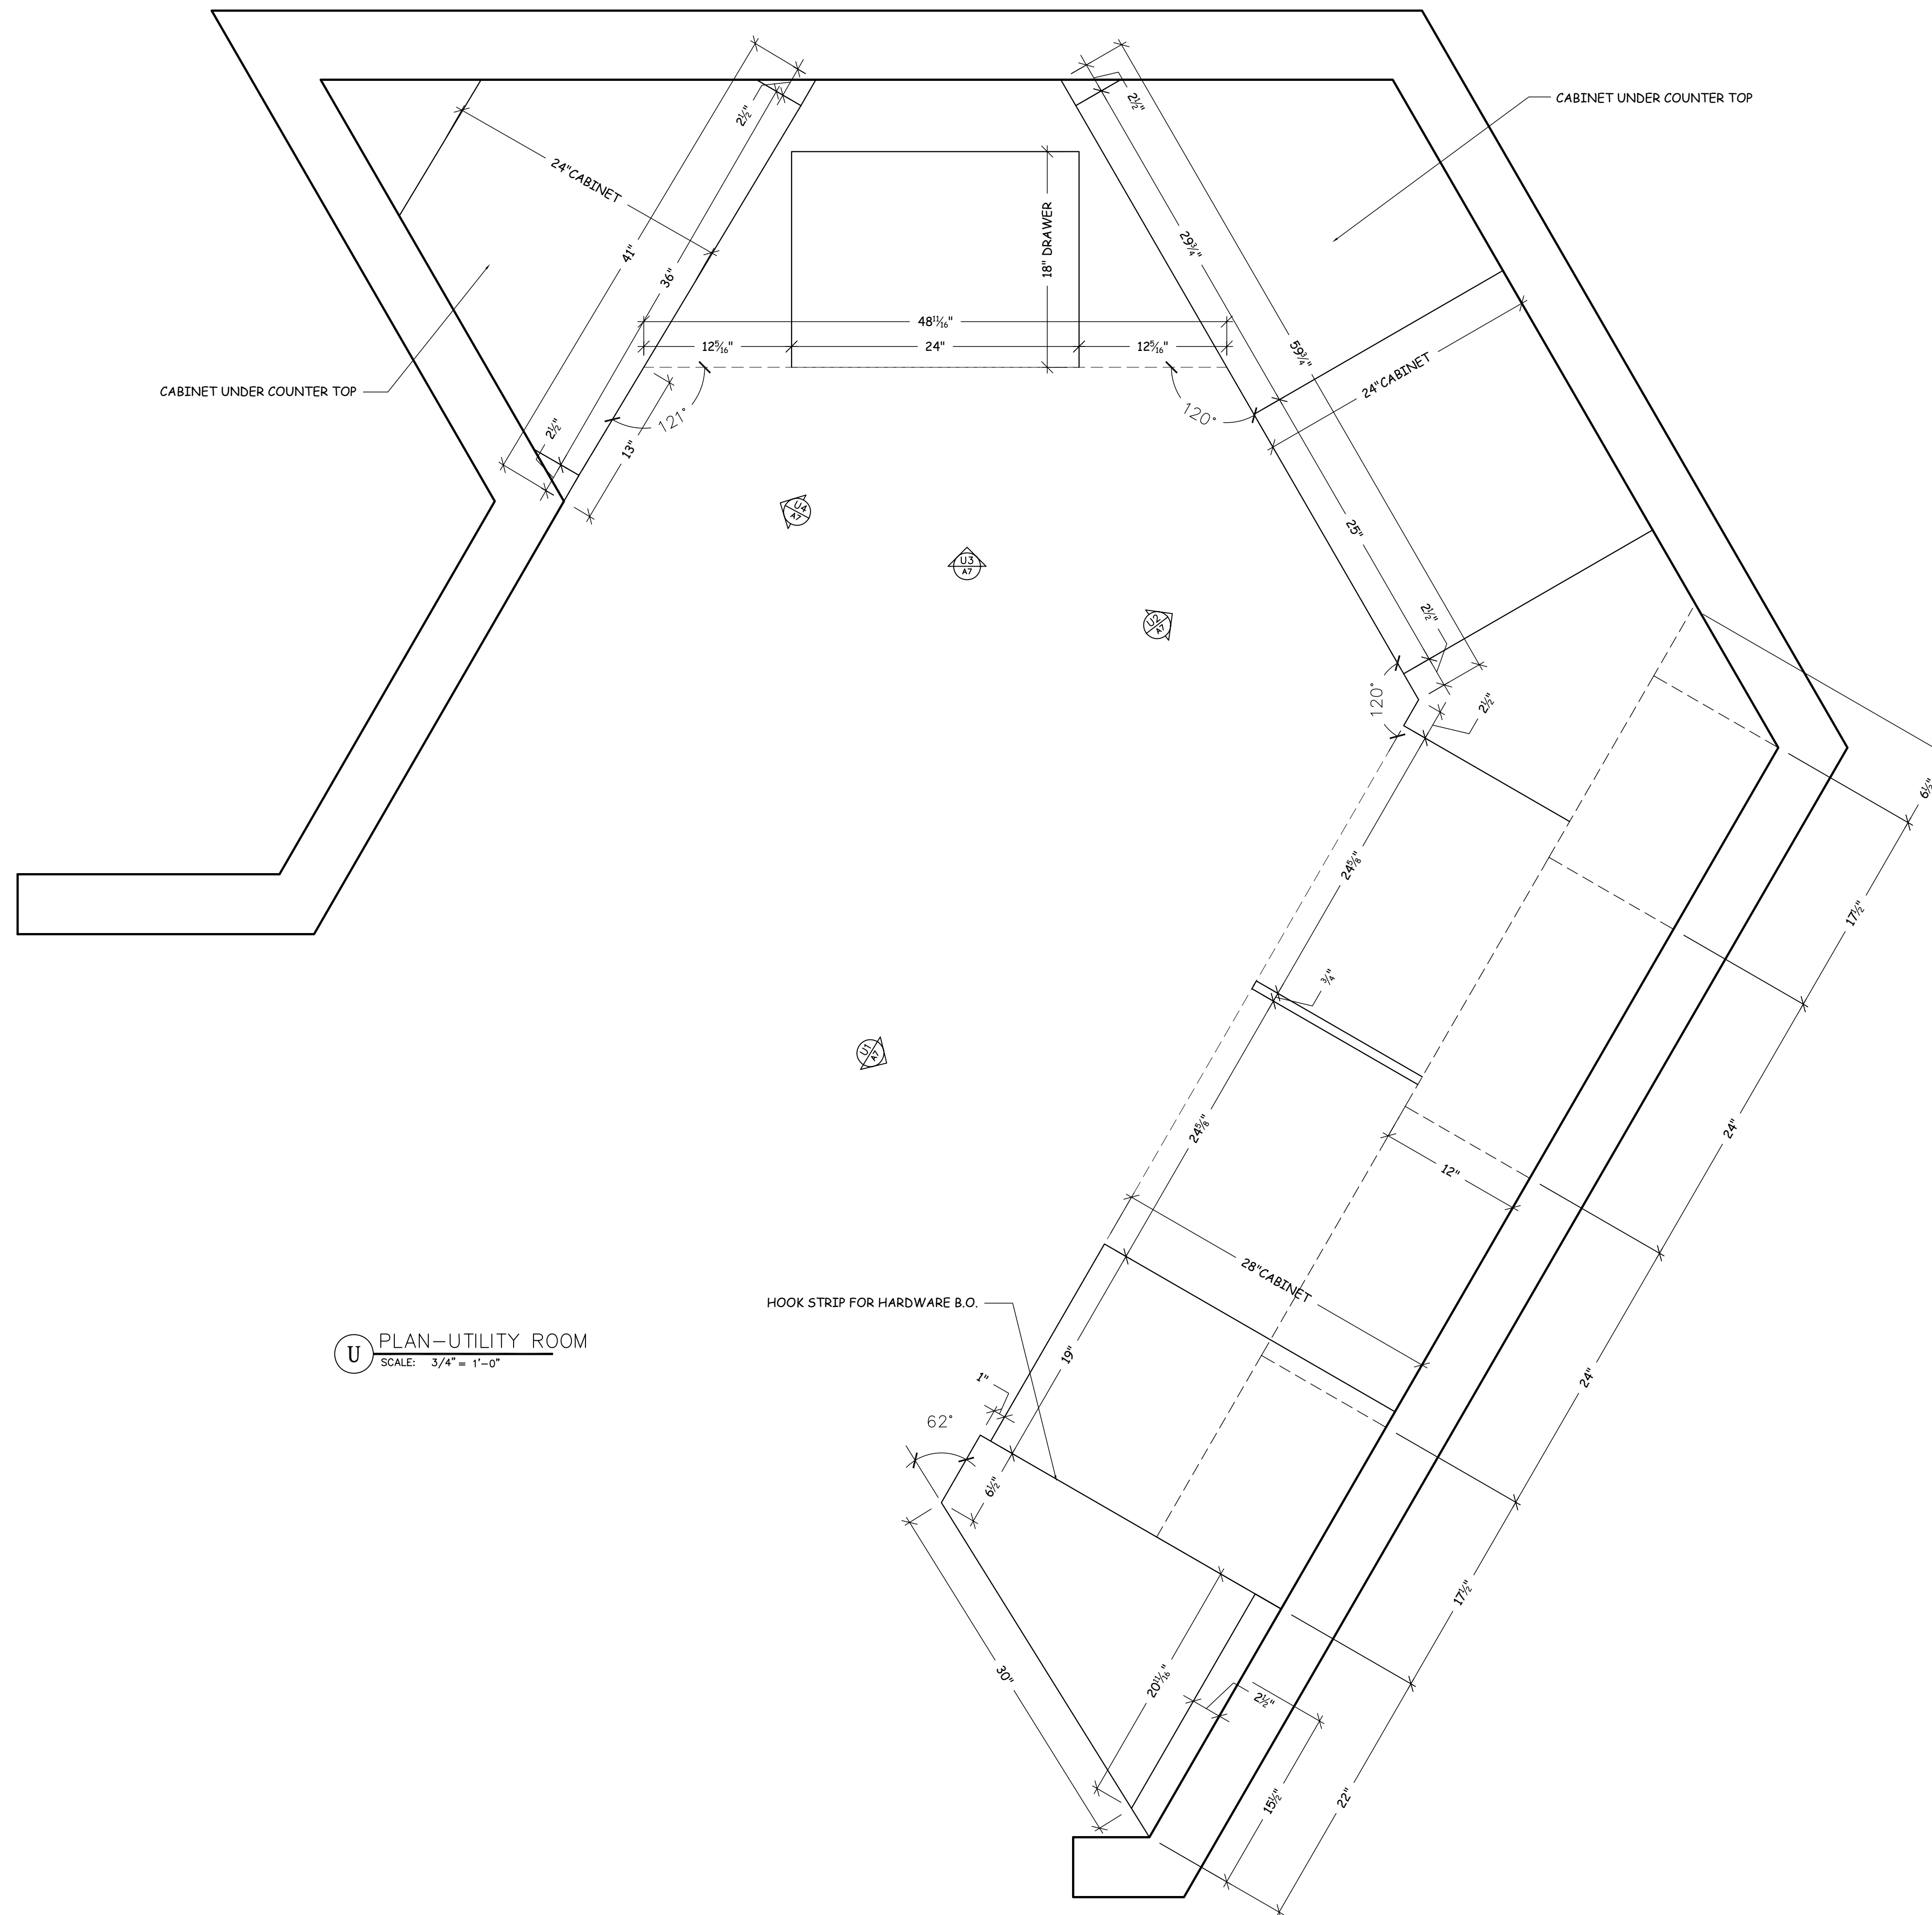

U PLAN-UTILITY ROOM
SCALE: 3/4" = 1'-0"

General Notes

SHOP NOTES:

N&N Architectural Drafting Service
Computer Aided Design & Drafting/ CNC Programming

LEGEND:

VIEW
 SHEET NO.
 DIRECTION OF VIEW

Drawn by Neno K.

No.	Revision/Issue	Date
1	MARKUP PER OWNER/ARCH.	2-27


DRAWING RECORD

ARCHITECT:


CONTRACTOR:

Project Name and Address:


Project:	UTILITY ROOM	Sheet:	A-6
Date:	3-23-07		
JOB # :	*		

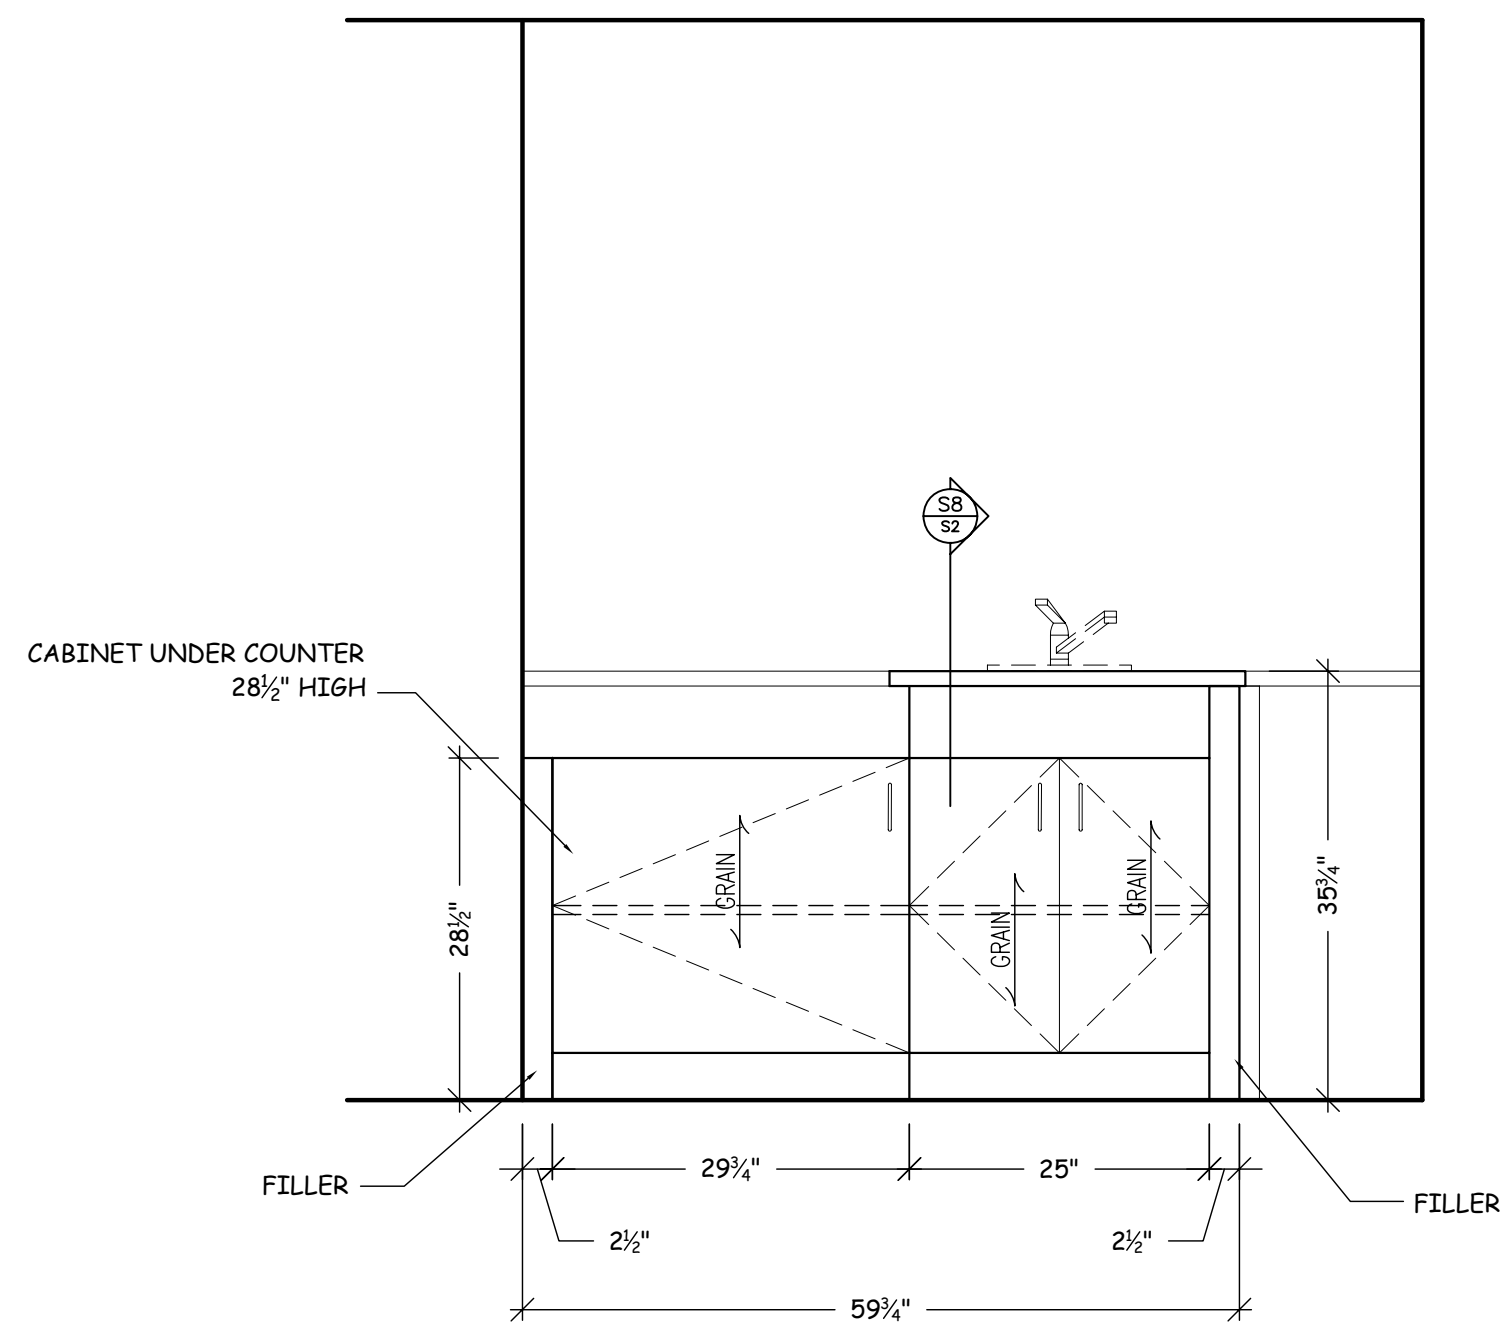


U2 ELEVATION
SCALE: 3/4" = 1'-0"

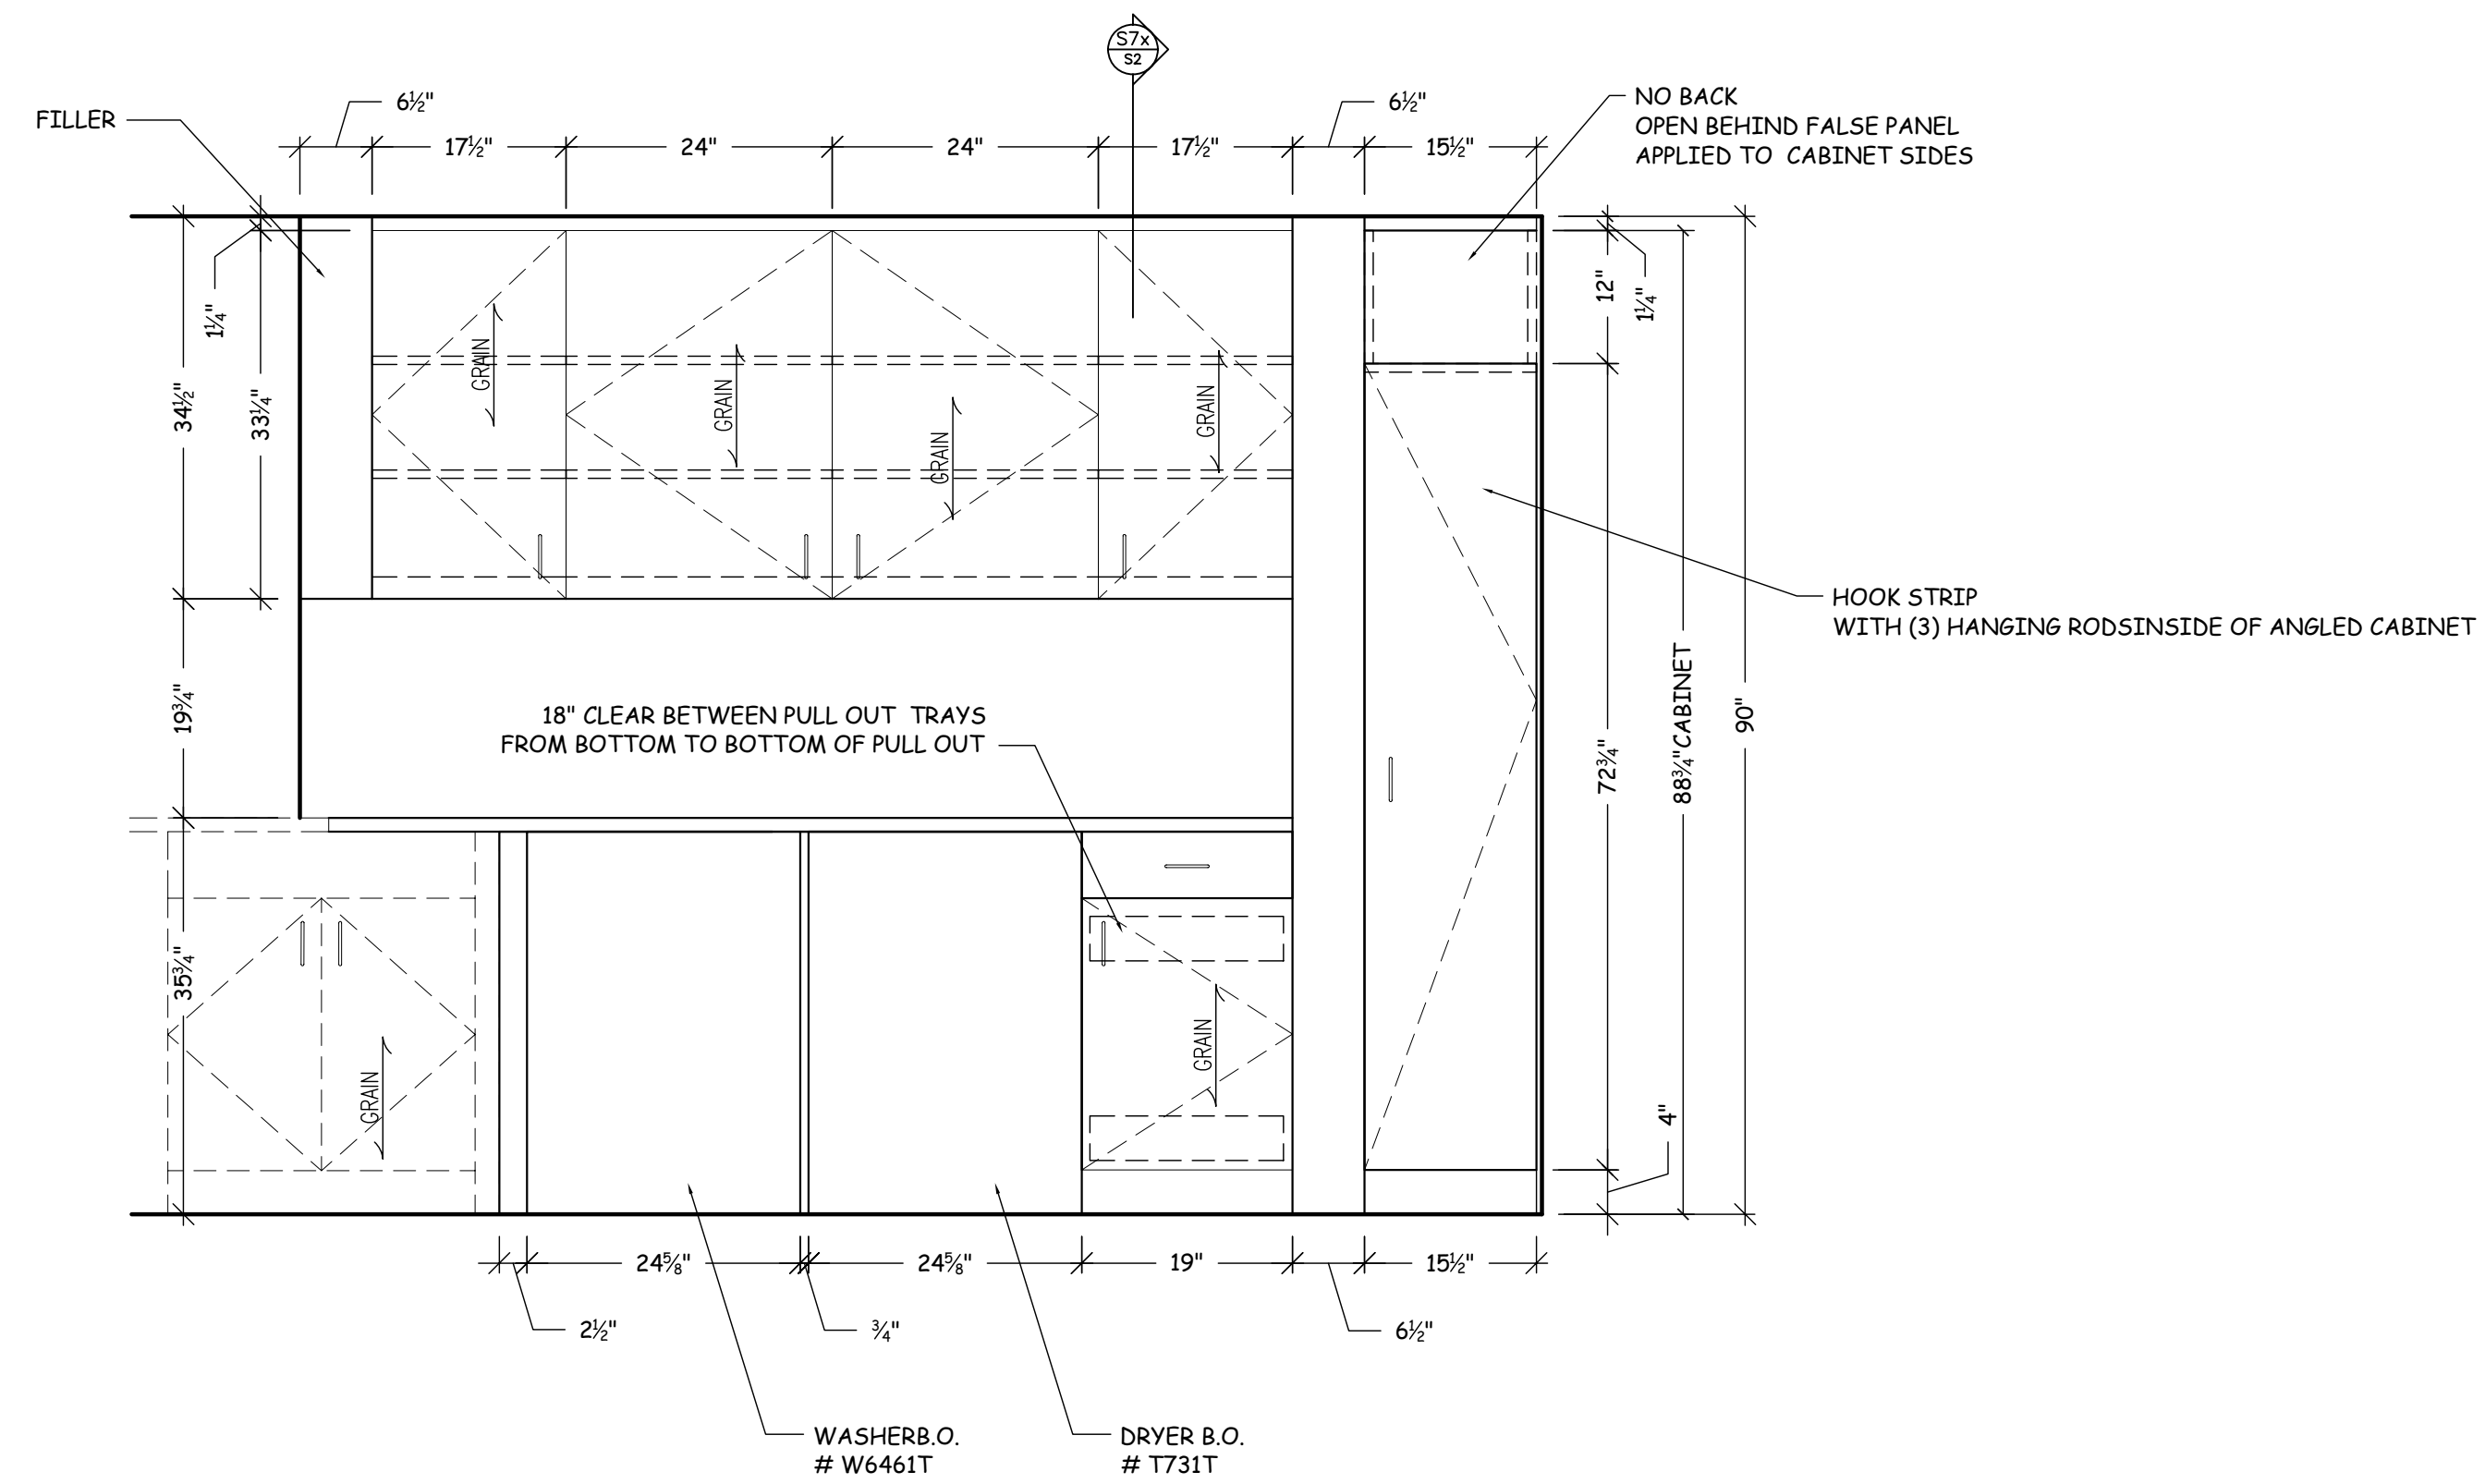

U1 ELEVATION
SCALE: 3/4" = 1'-0"

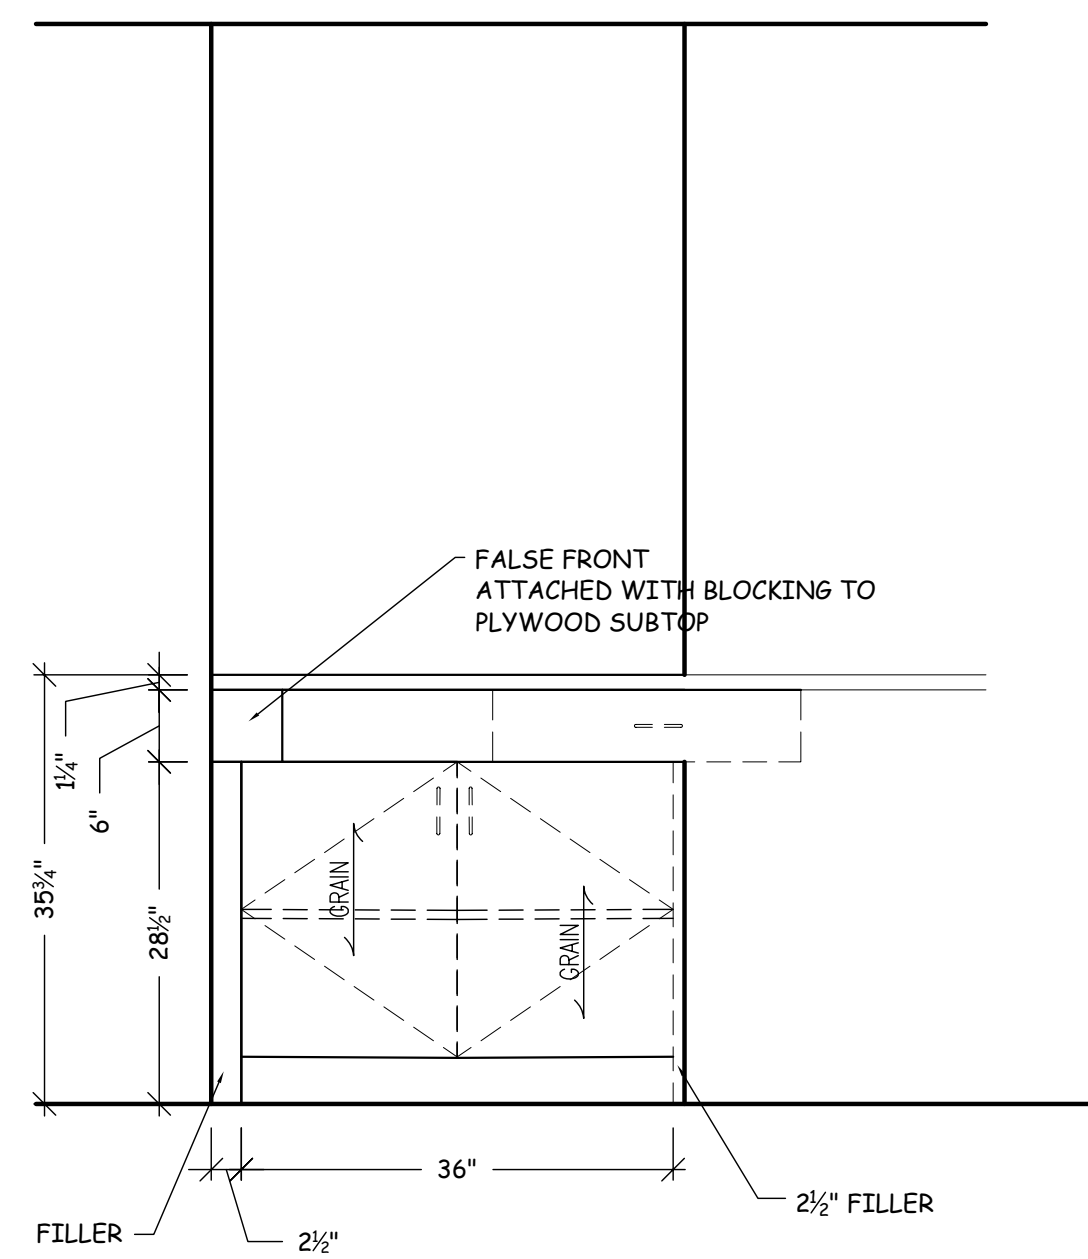

U4 ELEVATION
SCALE: 3/4" = 1'-0"

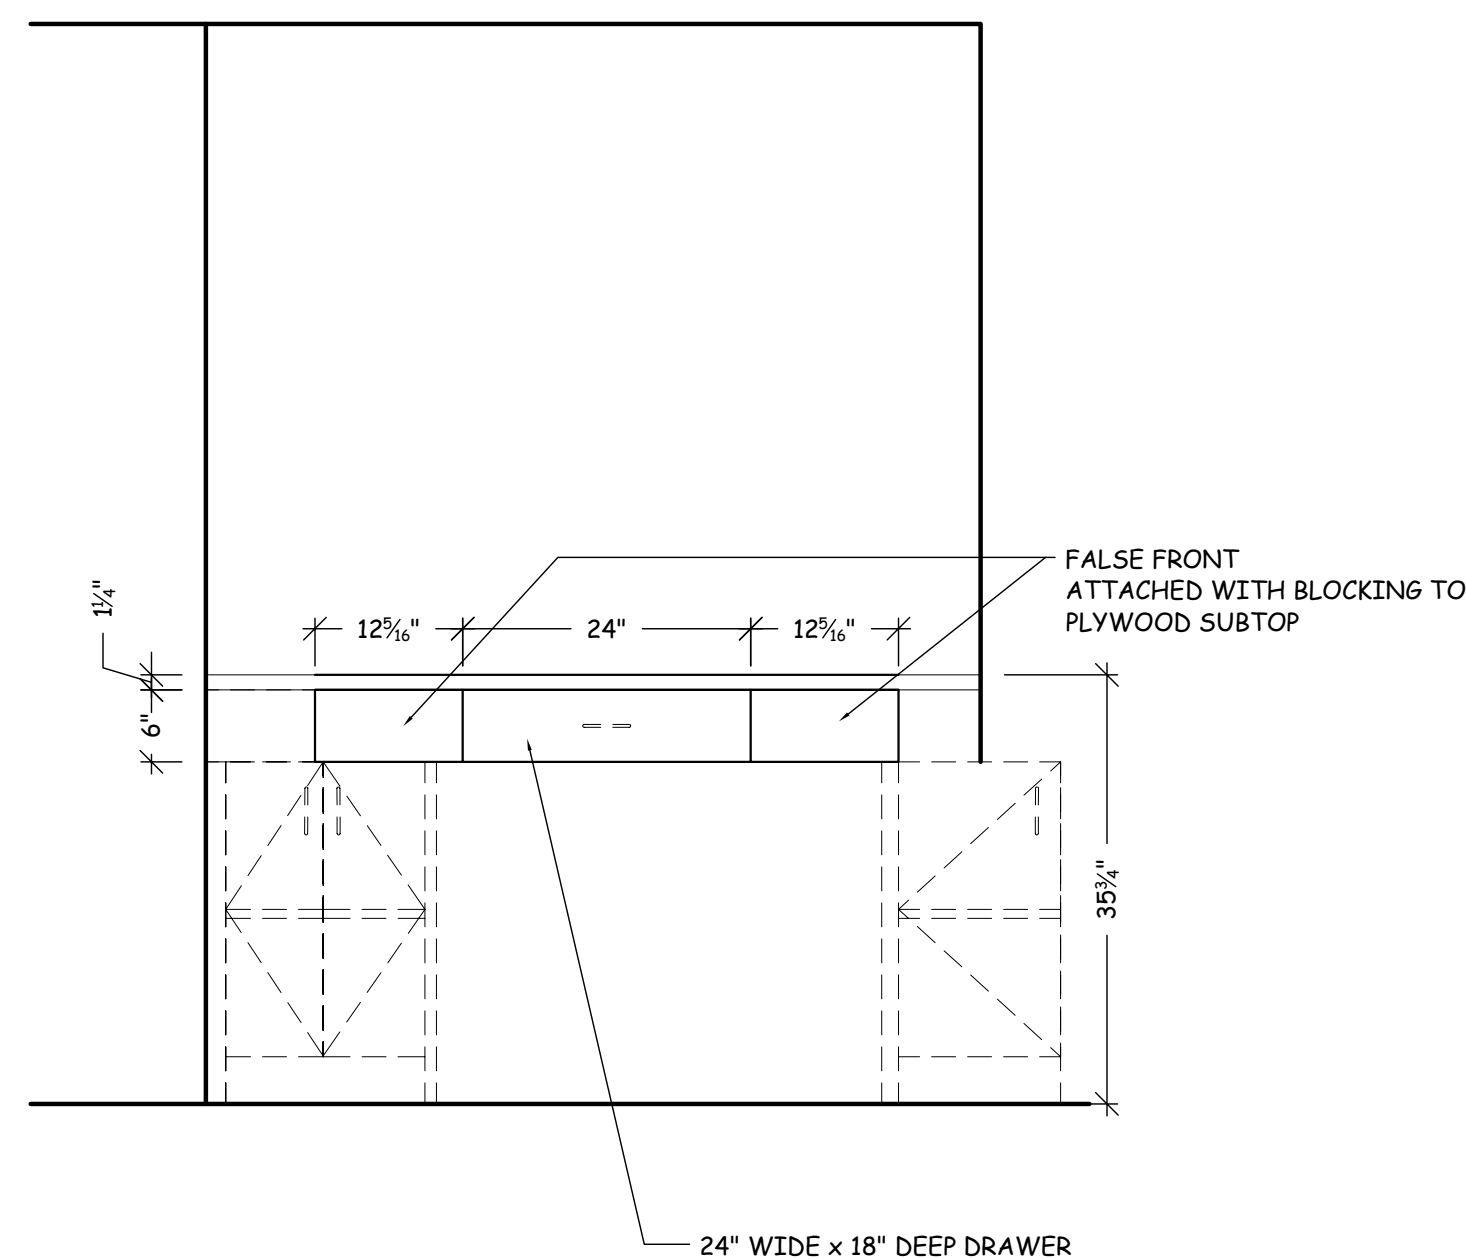

U3 ELEVATION
SCALE: 3/4" = 1'-0"

General Notes
SHOP NOTES:

N&N Architectural Drafting Service
Computer Aided Design & Drafting/ CNC Programming

LEGEND:

 VIEW
 SHEET NO.
 DIRECTION OF VIEW


Drawn by Nono K.

No.	Revision/Issue	Date
1	MARKUP PER OWNER/ARCH.	2-27

DRAWING RECORD

ARCHITECT:
 CONTRACTOR:
 Project Name and Address:

Project: UTILITY ROOM Sheet:
 Date: 3-23-07 A-7
 JOB # : *

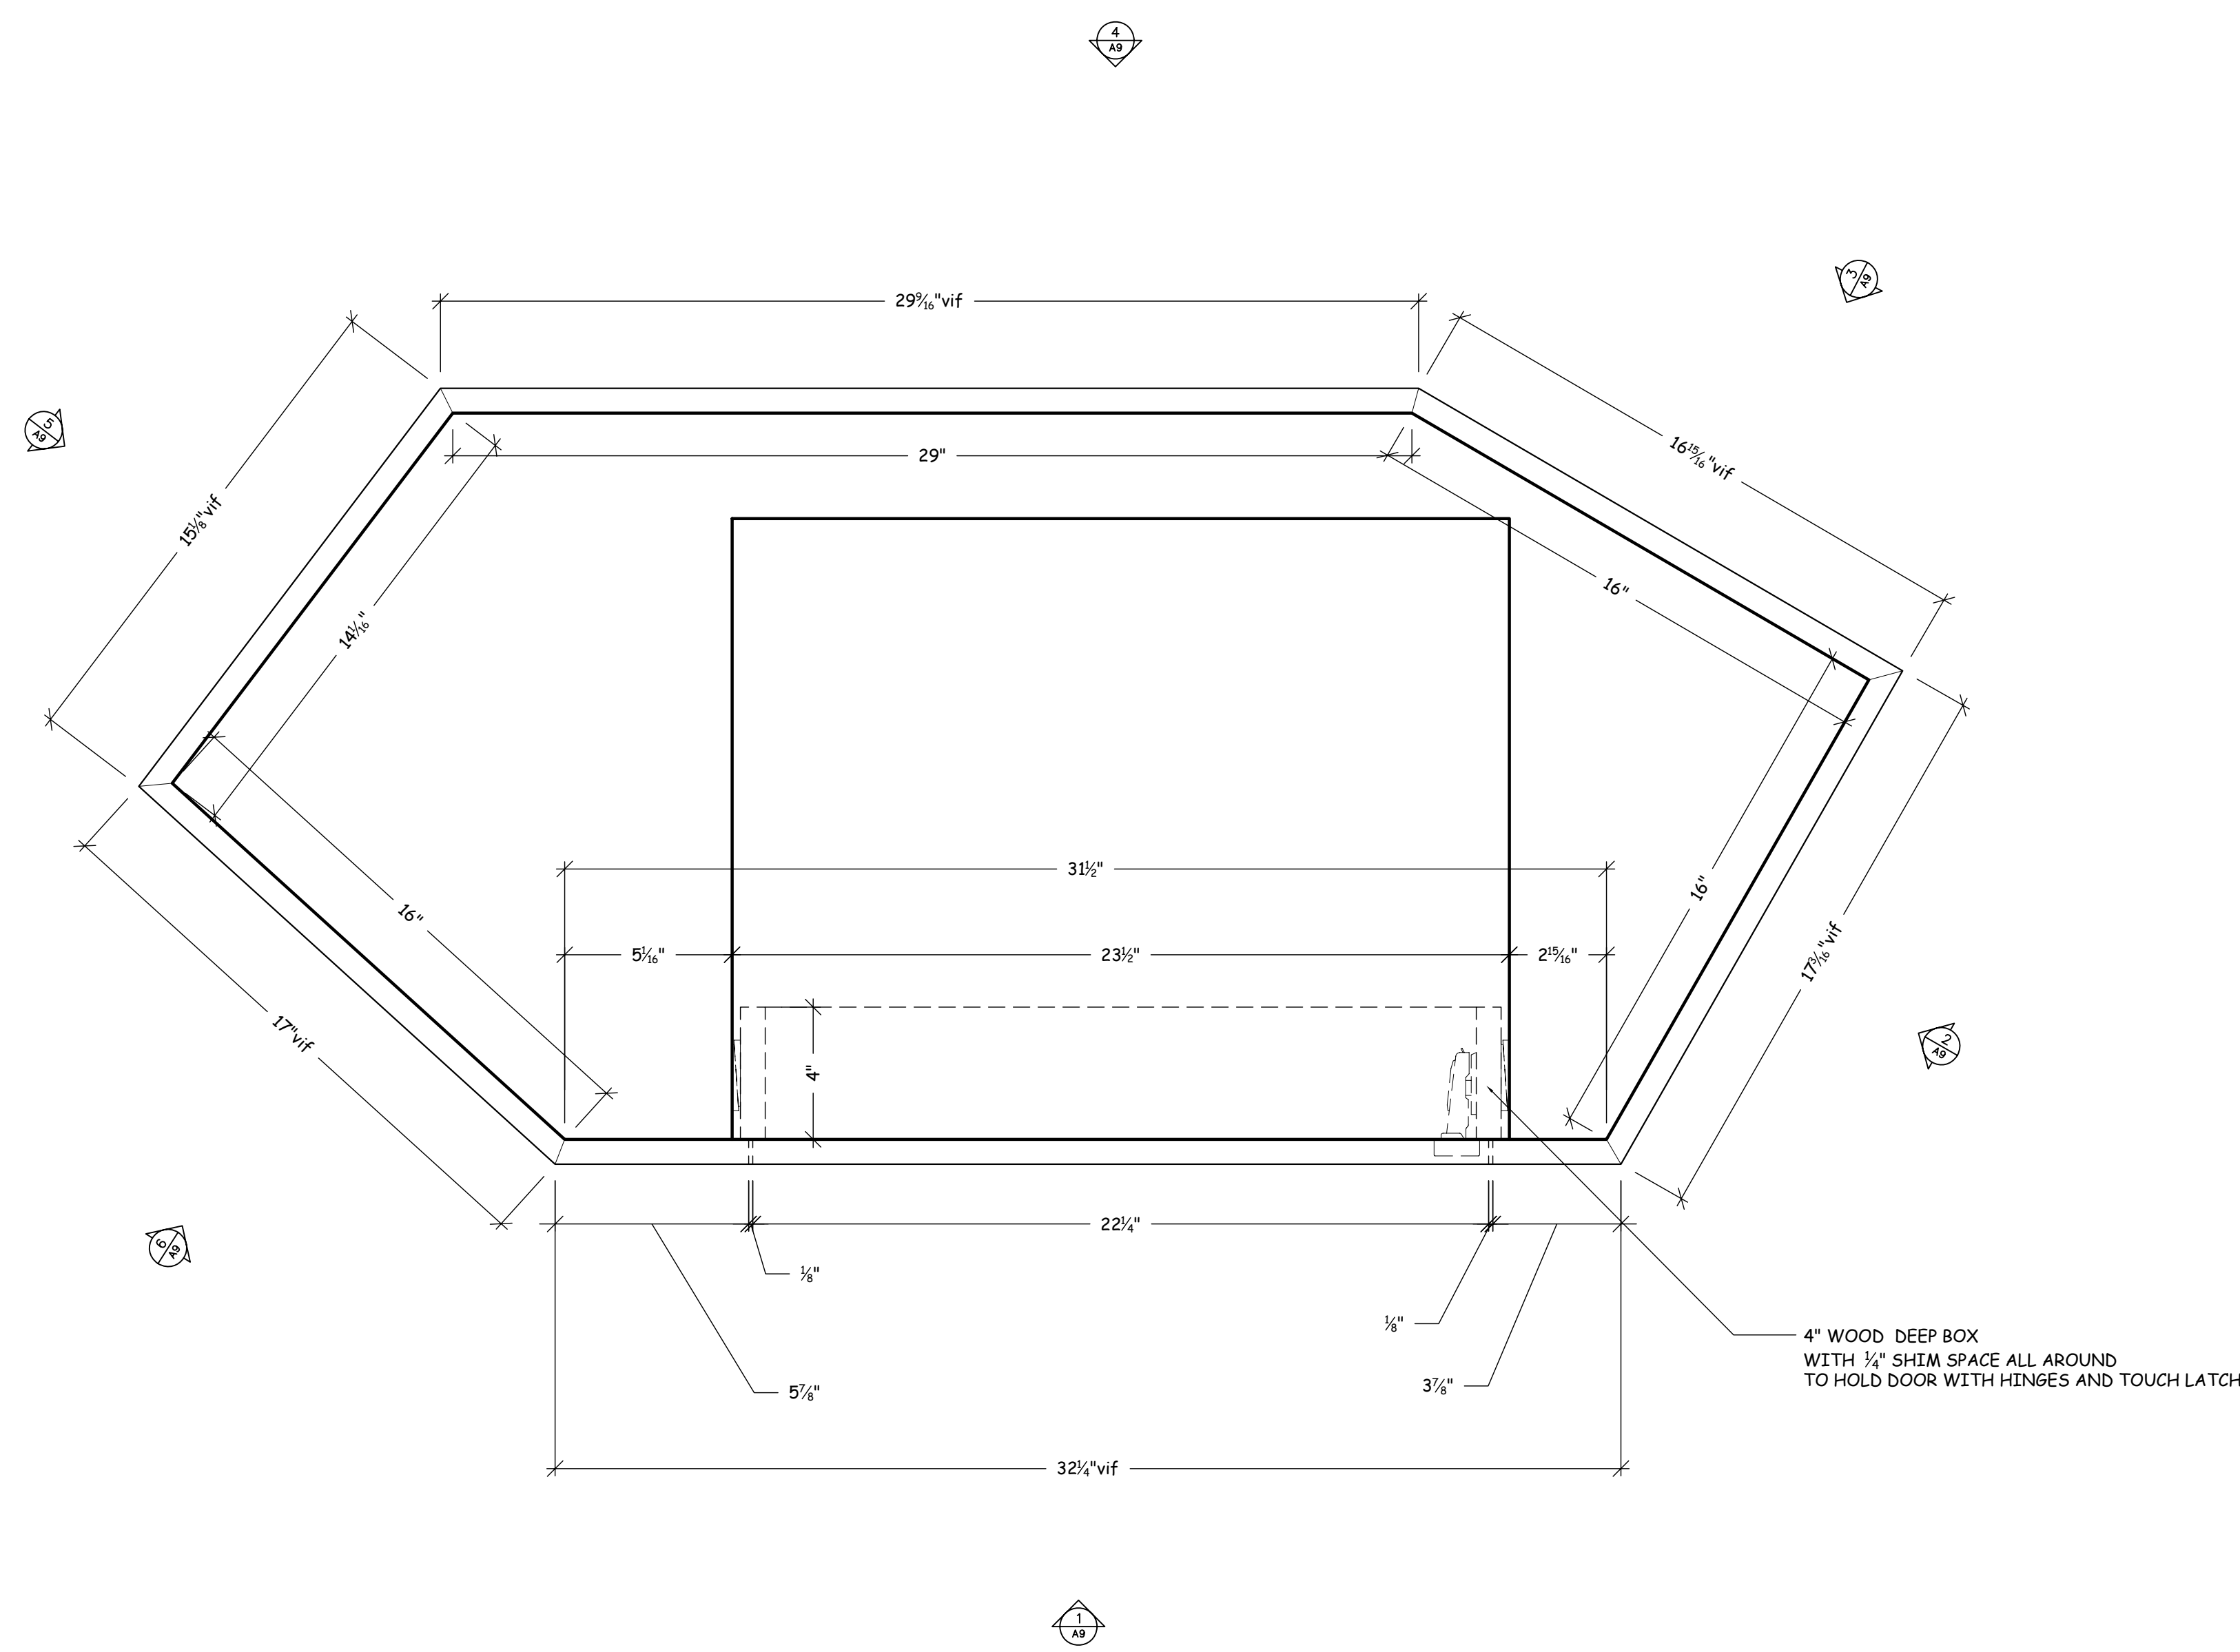

PLAN- DUMB WAITER
SCALE: 3/4" = 1'-0"

General Notes

SHOP NOTES:

N&N Architectural Drafting Service
Computer Aided Design & Drafting/ CNC Programming

LEGEND:

 VIEW
 SHEET NO.
 DIRECTION OF VIEW


Drawn by Neno K.

No.	Revision/Issue	Date
1	MARKUP PER OWNER/ARCH.	2-27


DRAWING RECORD

ARCHITECT:
 CONTRACTOR:
 Project Name and Address:


Project: **DUMB WAITER** Sheet:
 Date: **3-23-07** **A-8**
 JOB # : *

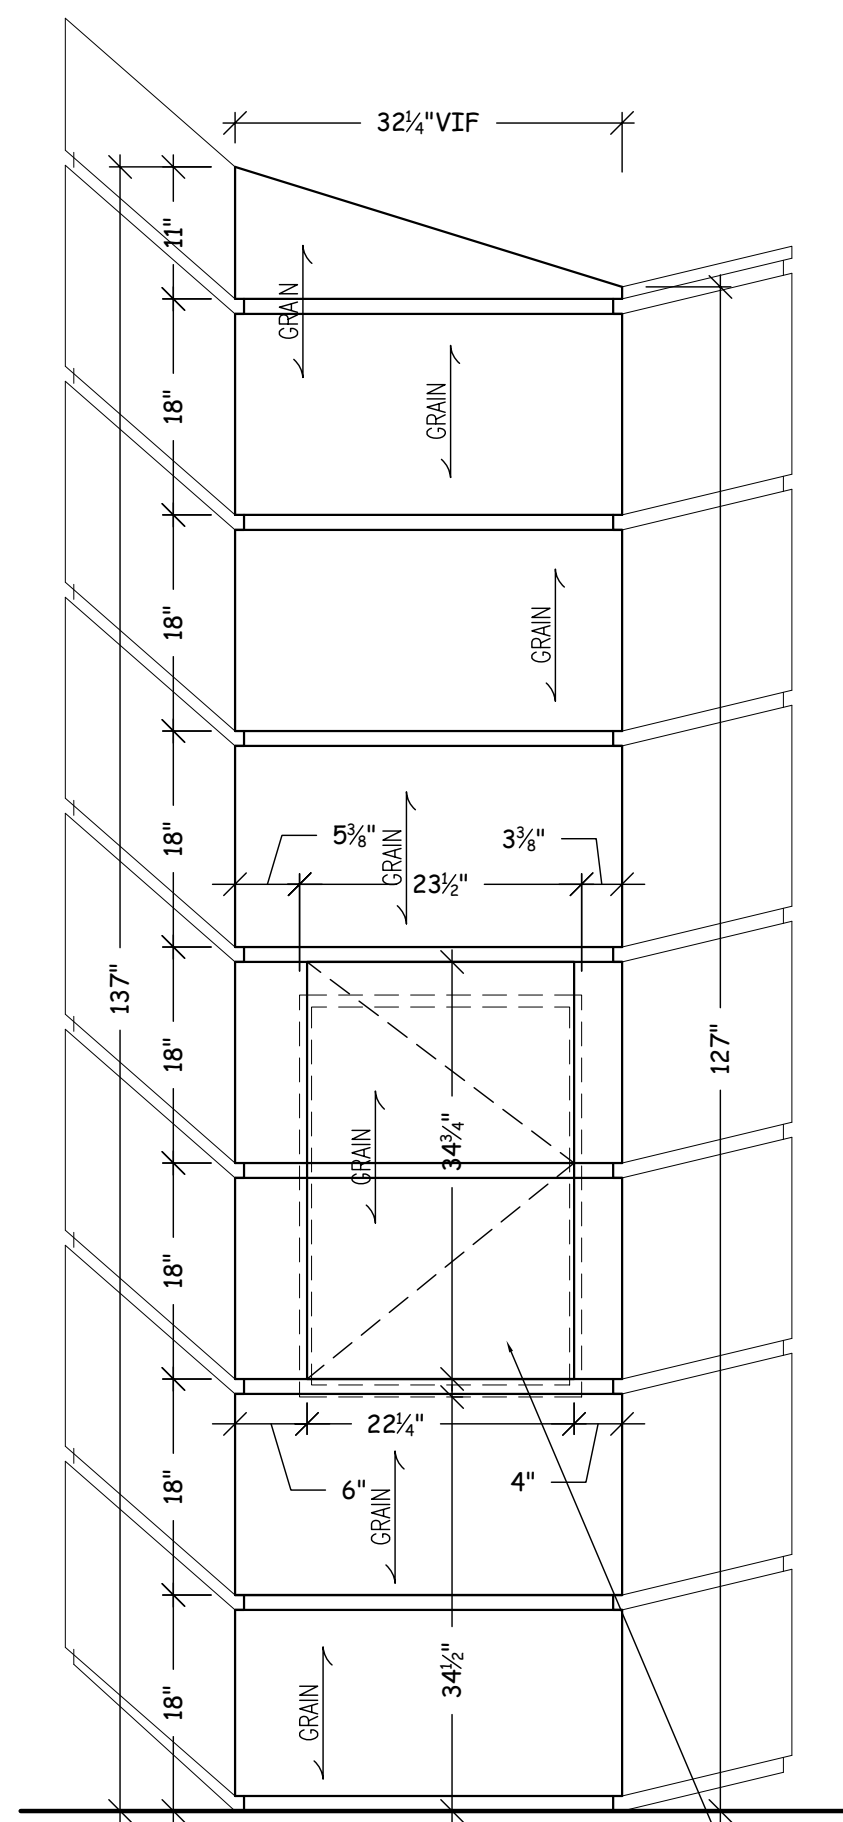


1 ELEVATION
SCALE: 3/4" = 1'-0"

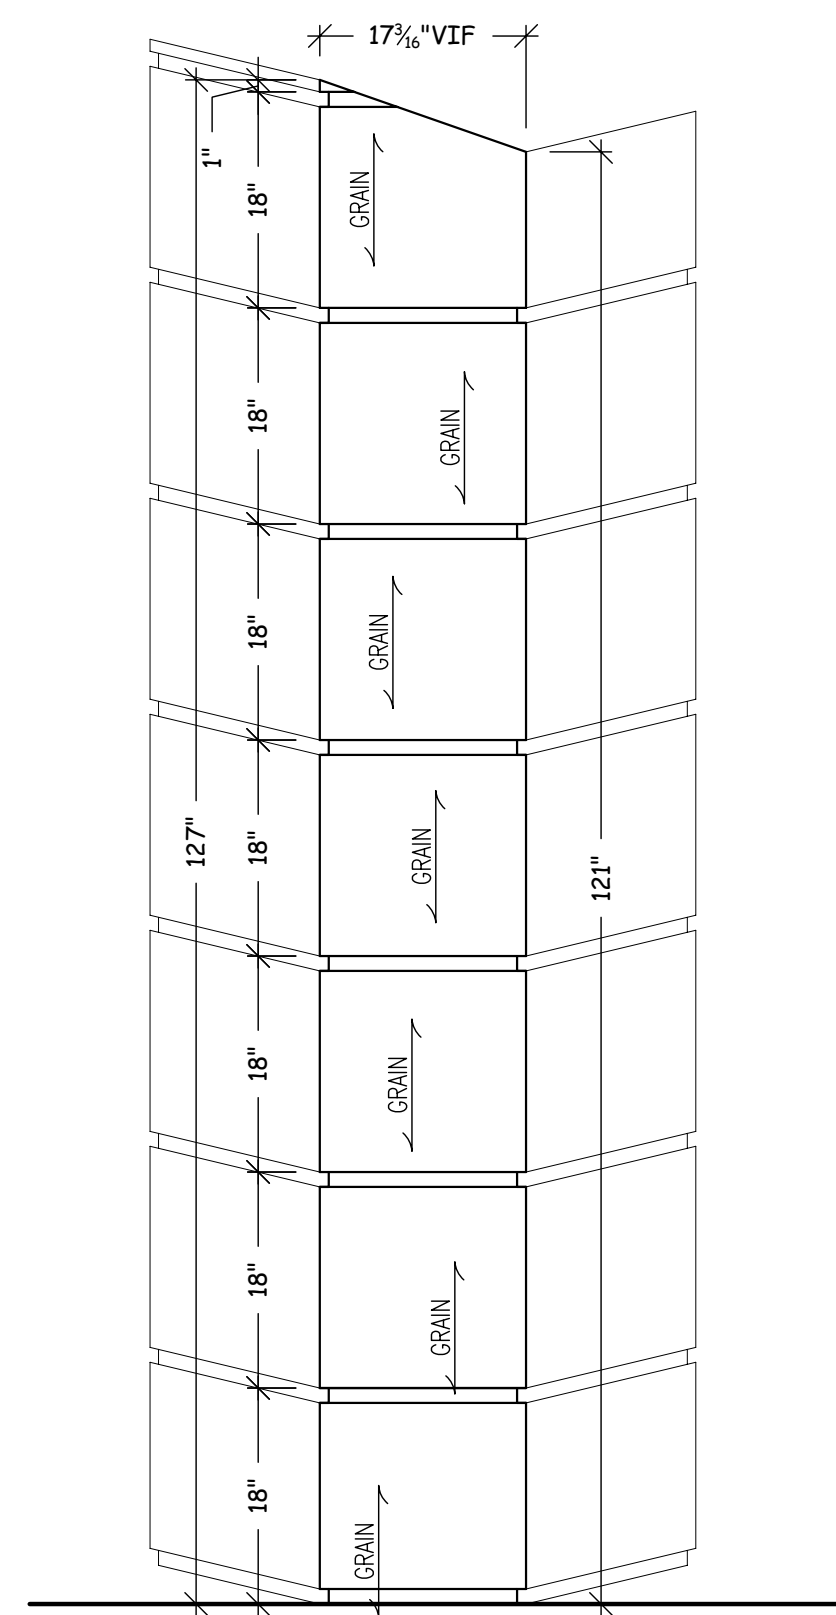


2 ELEVATION
SCALE: 3/4" = 1'-0"

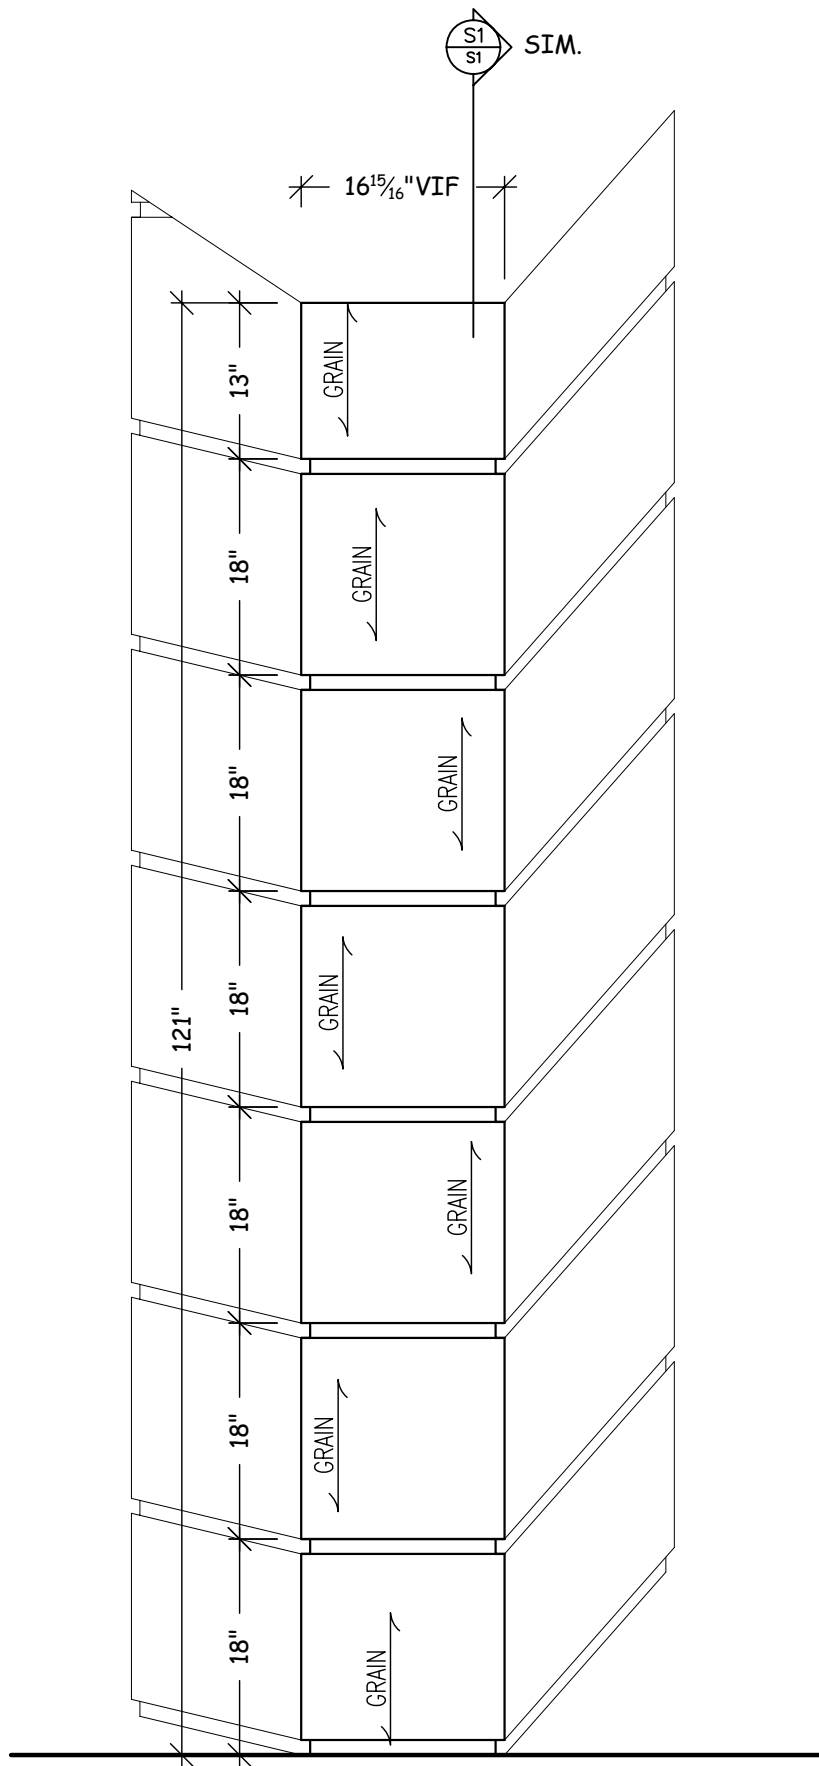


3 ELEVATION
SCALE: 3/4" = 1'-0"

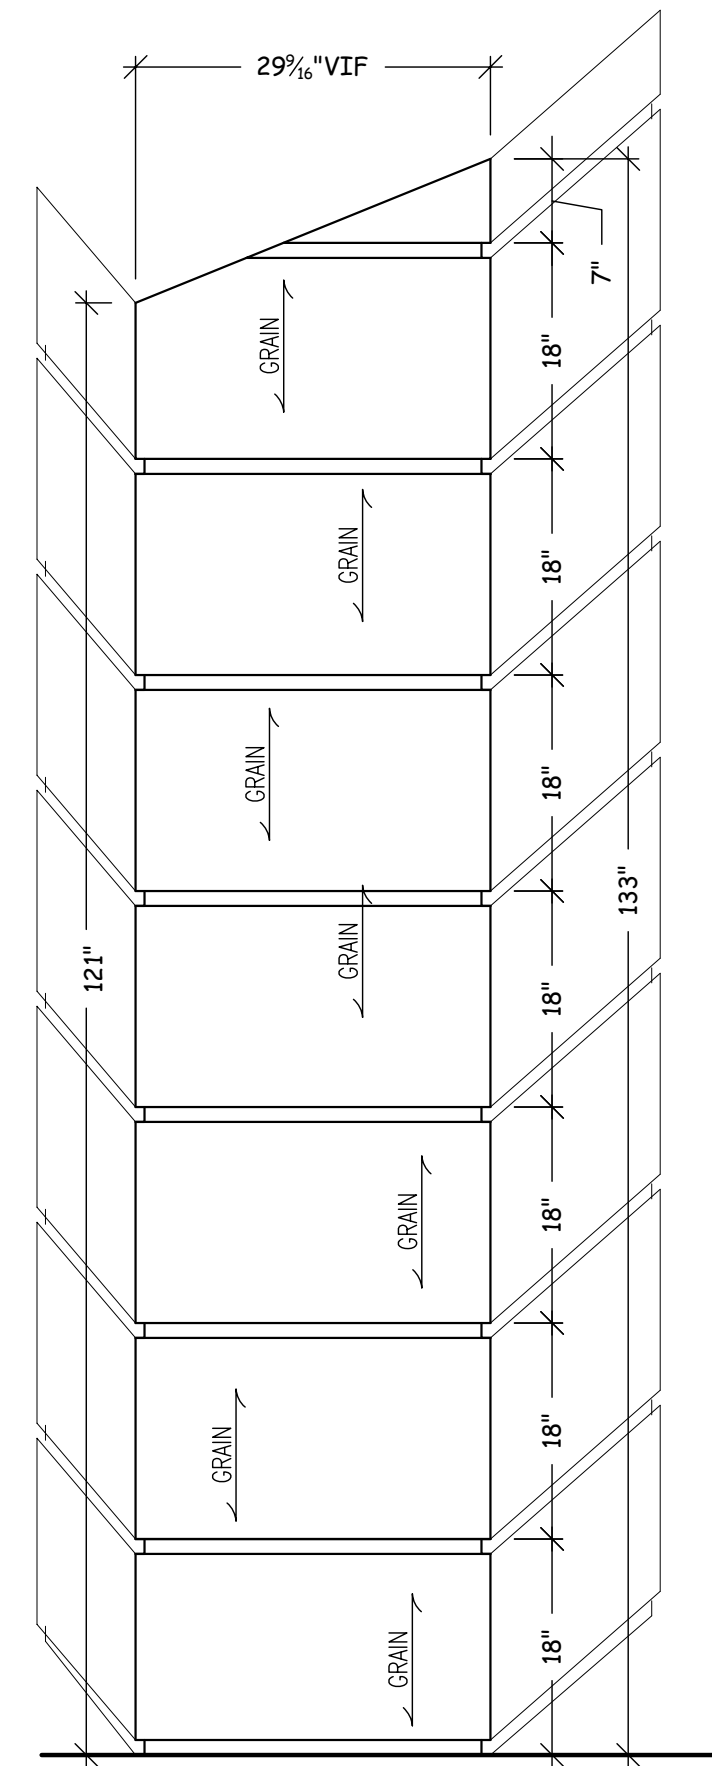

4 ELEVATION
SCALE: 3/4" = 1'-0"

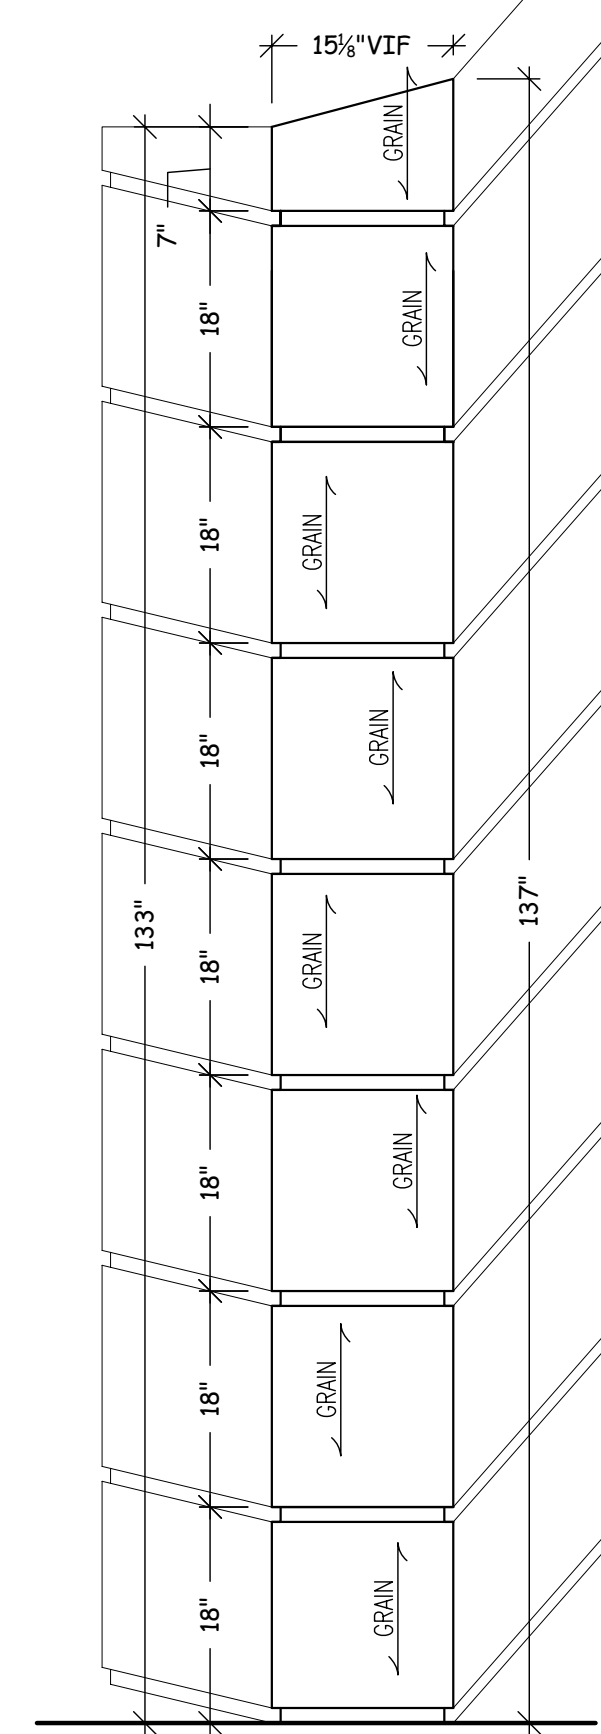

5 ELEVATION
SCALE: 3/4" = 1'-0"

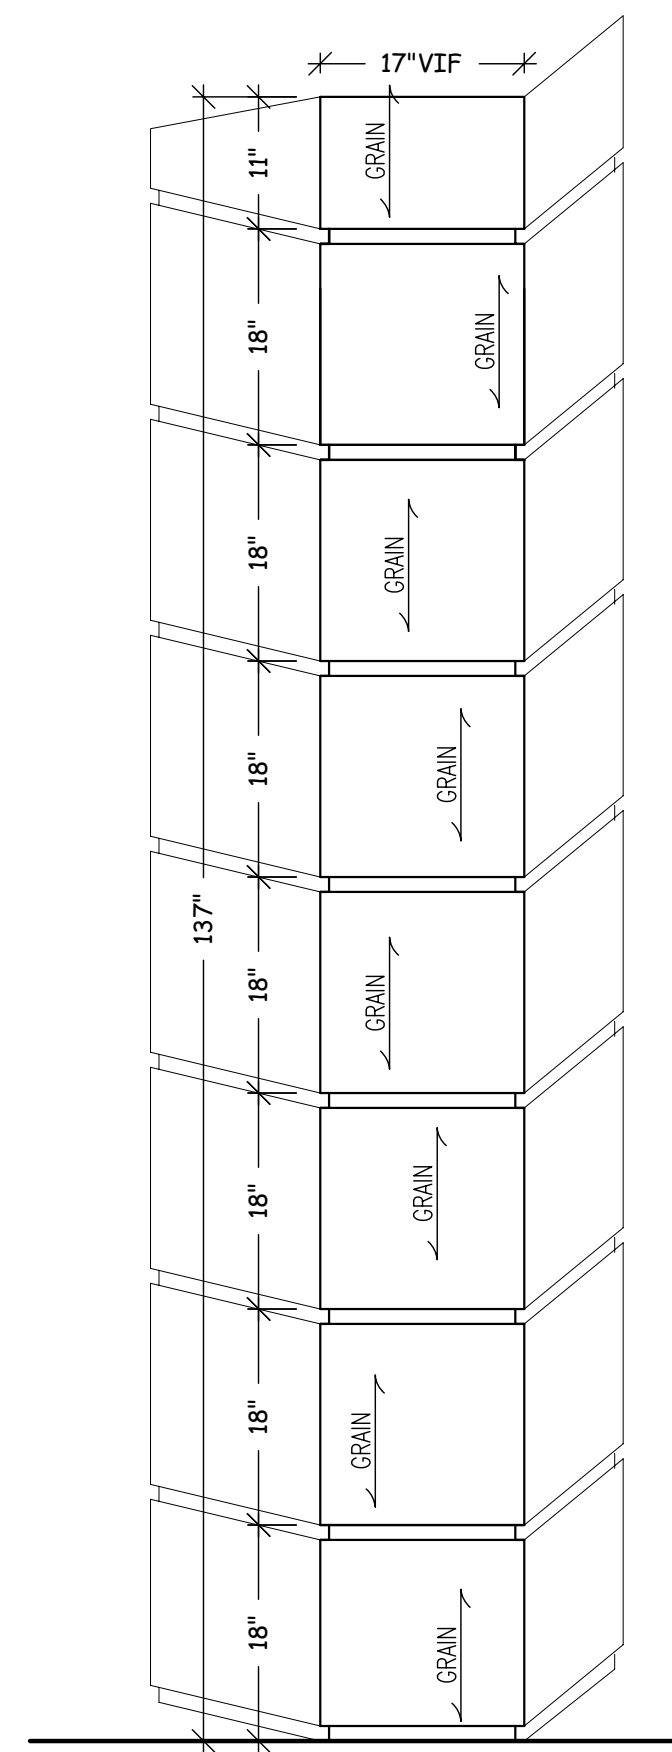

6 ELEVATION
SCALE: 3/4" = 1'-0"

TOUCH LATCH WITH EURO HINGES

SIM.

General Notes
SHOP NOTES:

N&N Architectural Drafting Service
Computer Aided Design & Drafting/ CNC Programming

LEGEND:

 VIEW
 SHEET NO.
 DIRECTION OF VIEW


Drawn by Neno K.

No.	Revision/Issue	Date
1	MARKUP PER OWNER/ARCH.	2-27


DRAWING RECORD

ARCHITECT:
 CONTRACTOR:
 Project Name and Address:


Project: **DUMB WAITER** Sheet:
 Date: **3-23-07** **A-9**
 JOB # : *

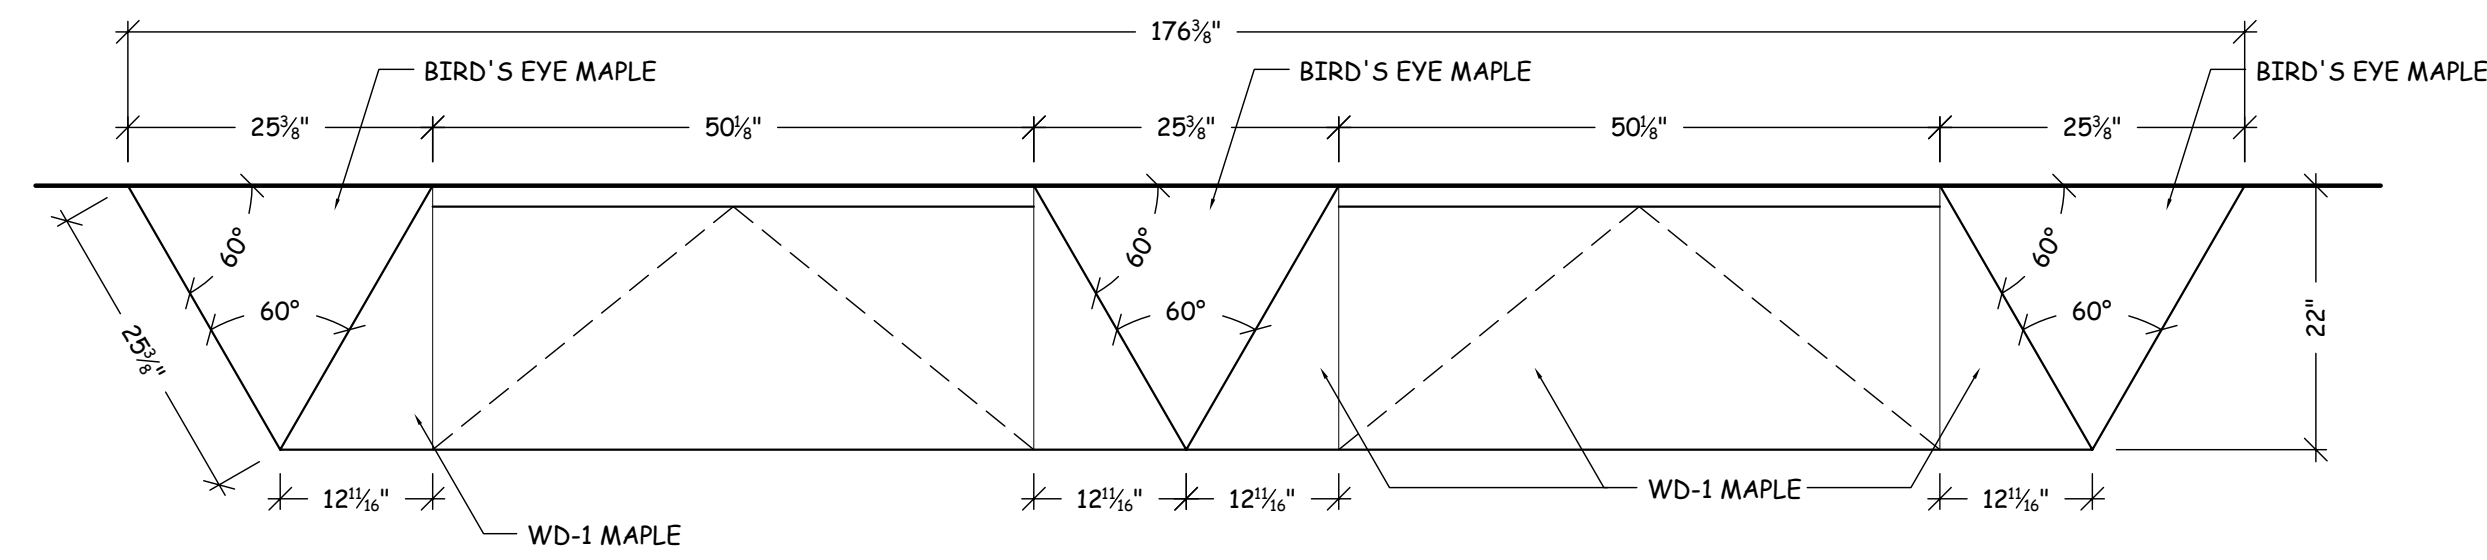


PLAN-BENCH SEAT @ LIVING ROOM
SCALE: 3/4" = 1'-0"

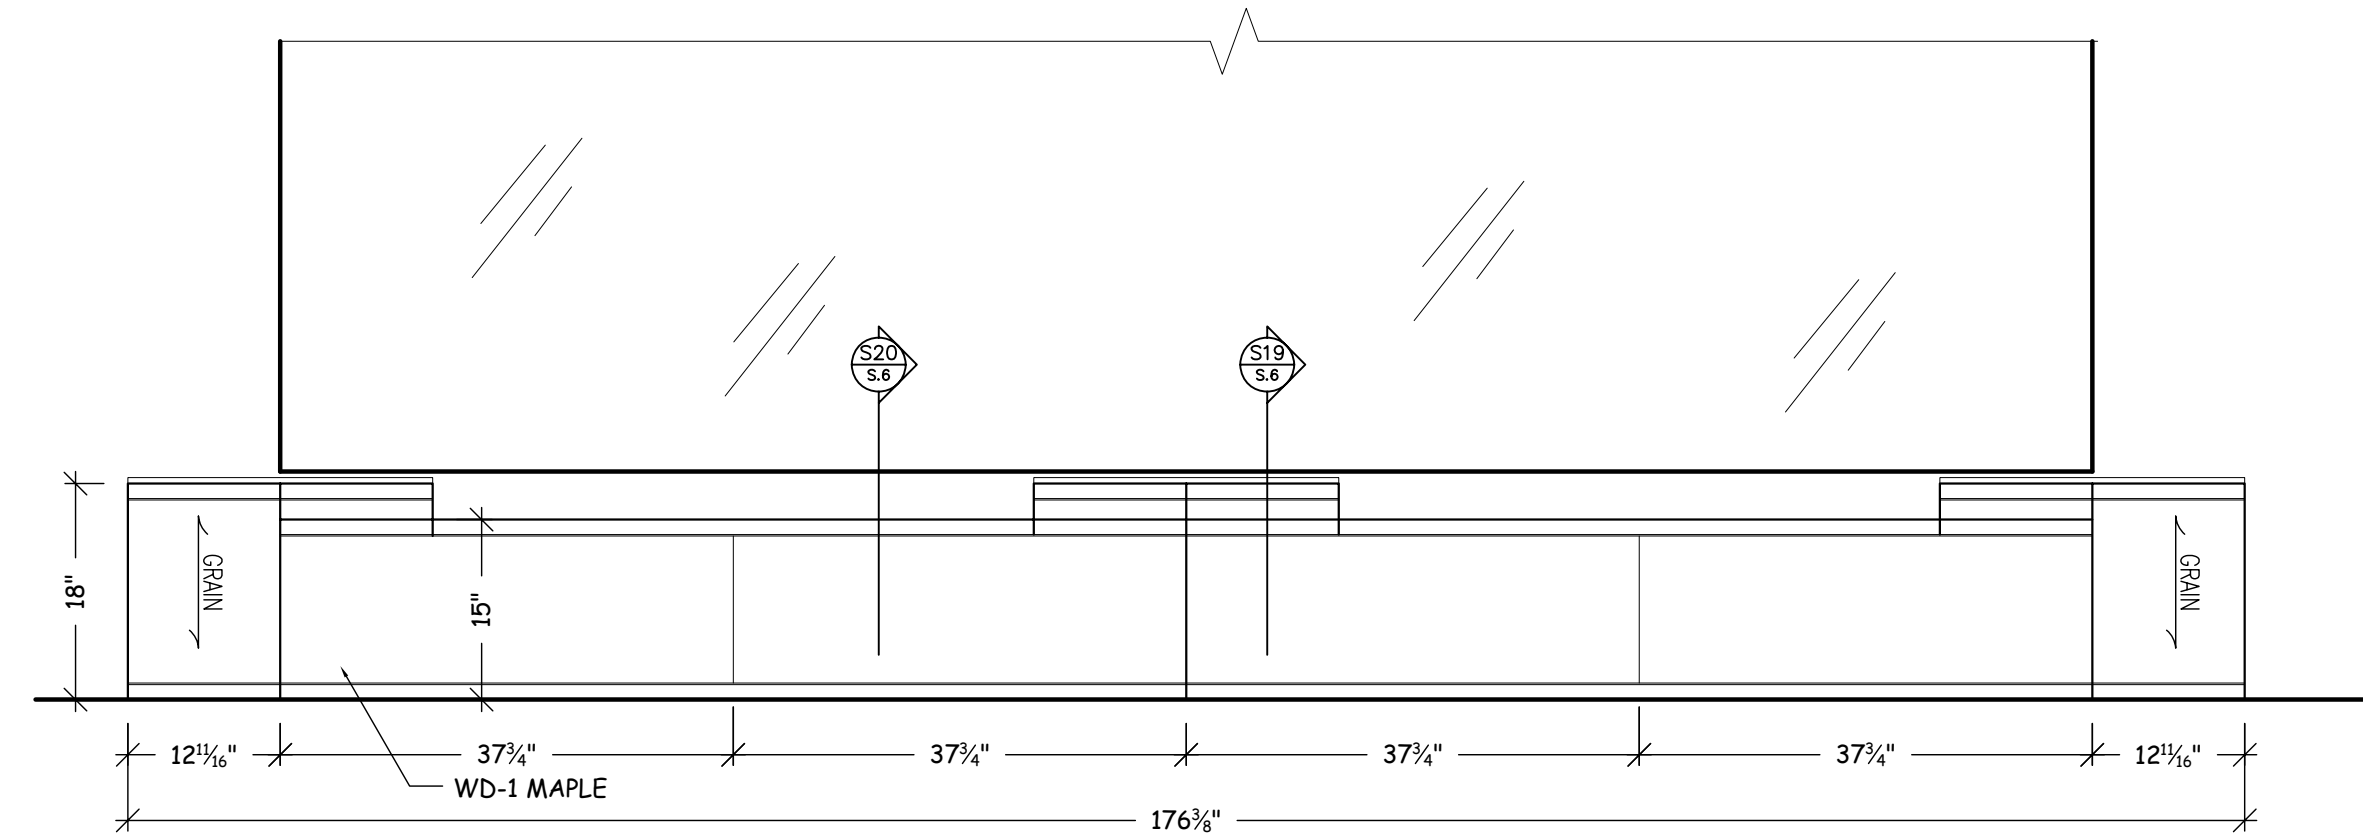

1 ELEVATION
SCALE: 3/4" = 1'-0"

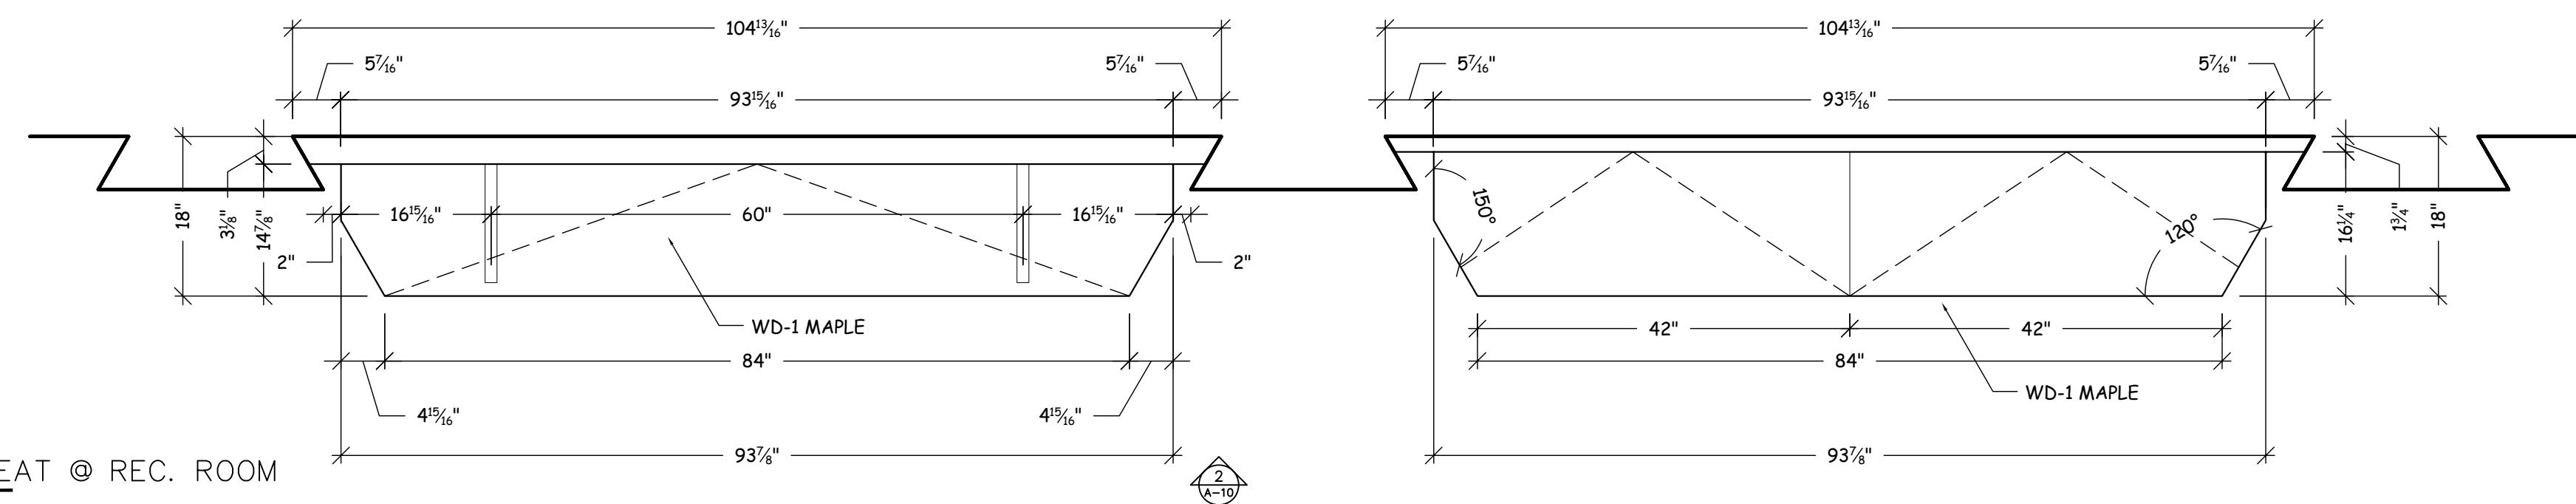

PLAN-BENCH SEAT @ REC. ROOM
SCALE: 3/4" = 1'-0"

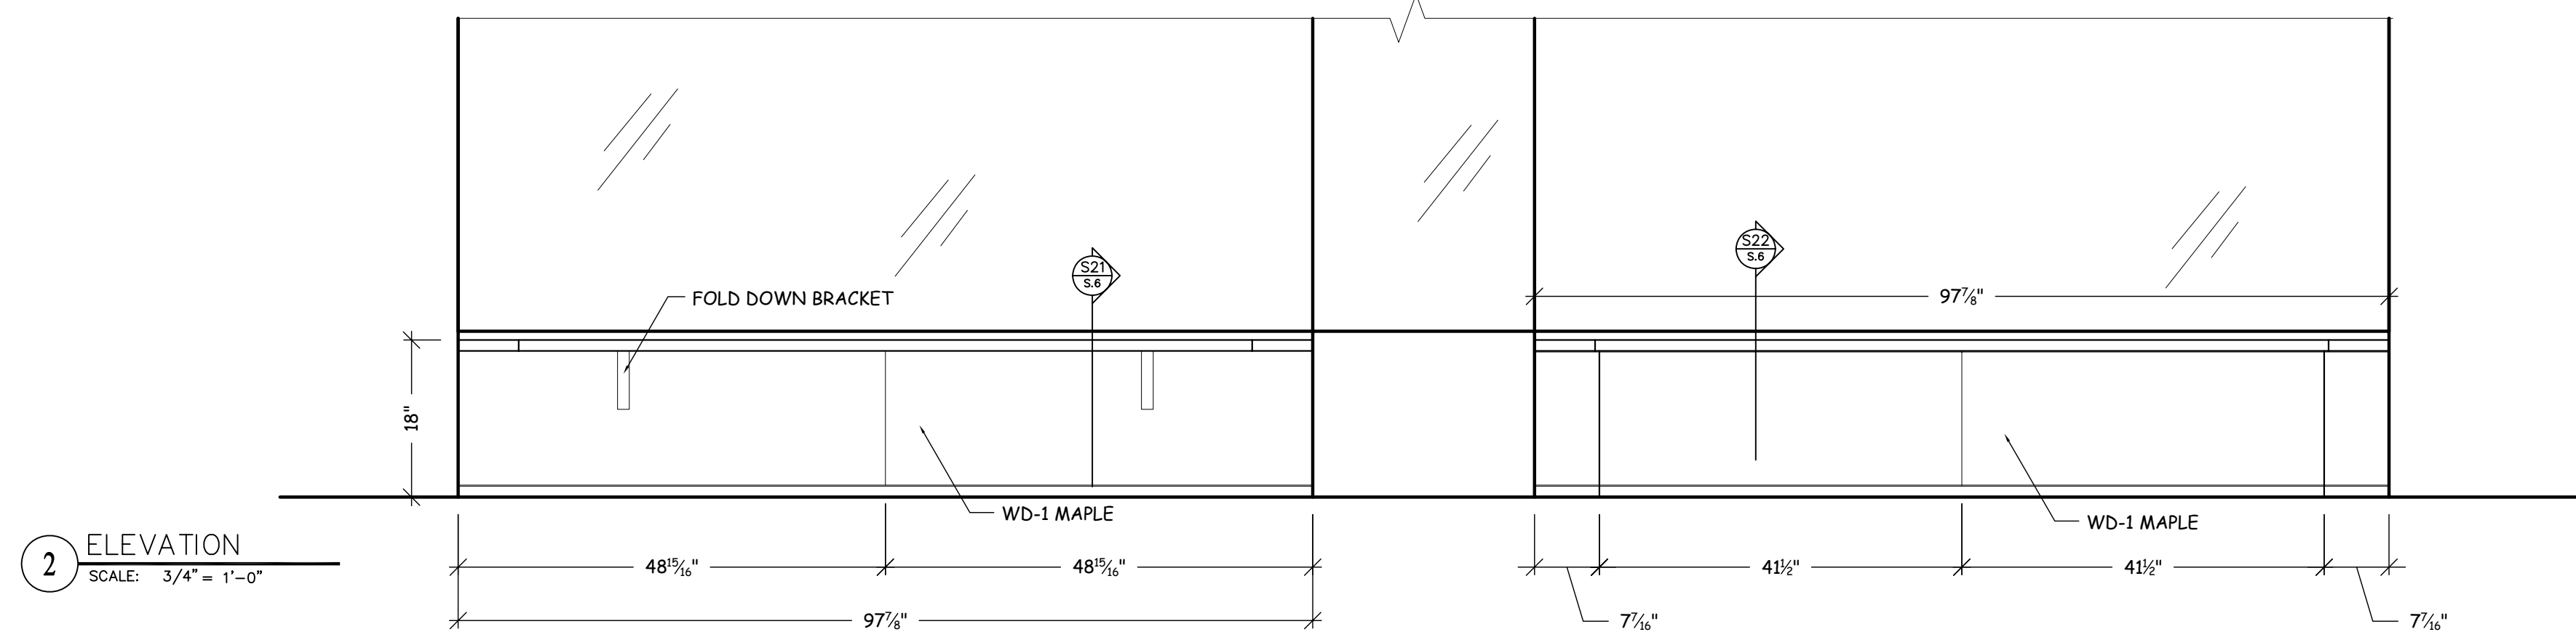

2 ELEVATION
SCALE: 3/4" = 1'-0"

General Notes

SHOP NOTES:

N&N Architectural Drafting Service
Computer Aided Design & Drafting/ CNC Programming


LEGEND:
VIEW
SHEET NO.
DIRECTION OF VIEW

Drawn by Neno K.

No.	Revision/Issue	Date
-	UPDATED	2-03
1	MARKUP PER OWNER/ARCH.	2-27
-	1ST PHASE ADDITION	3-21
-	1ST PHASE ADDITION PART II	5-11

DRAWING RECORD

ARCHITECT:	
CONTRACTOR:	
Project Name and Address:	
Project: *	Sheet:
Date: 5-11-07	A-10
JOB # : *	

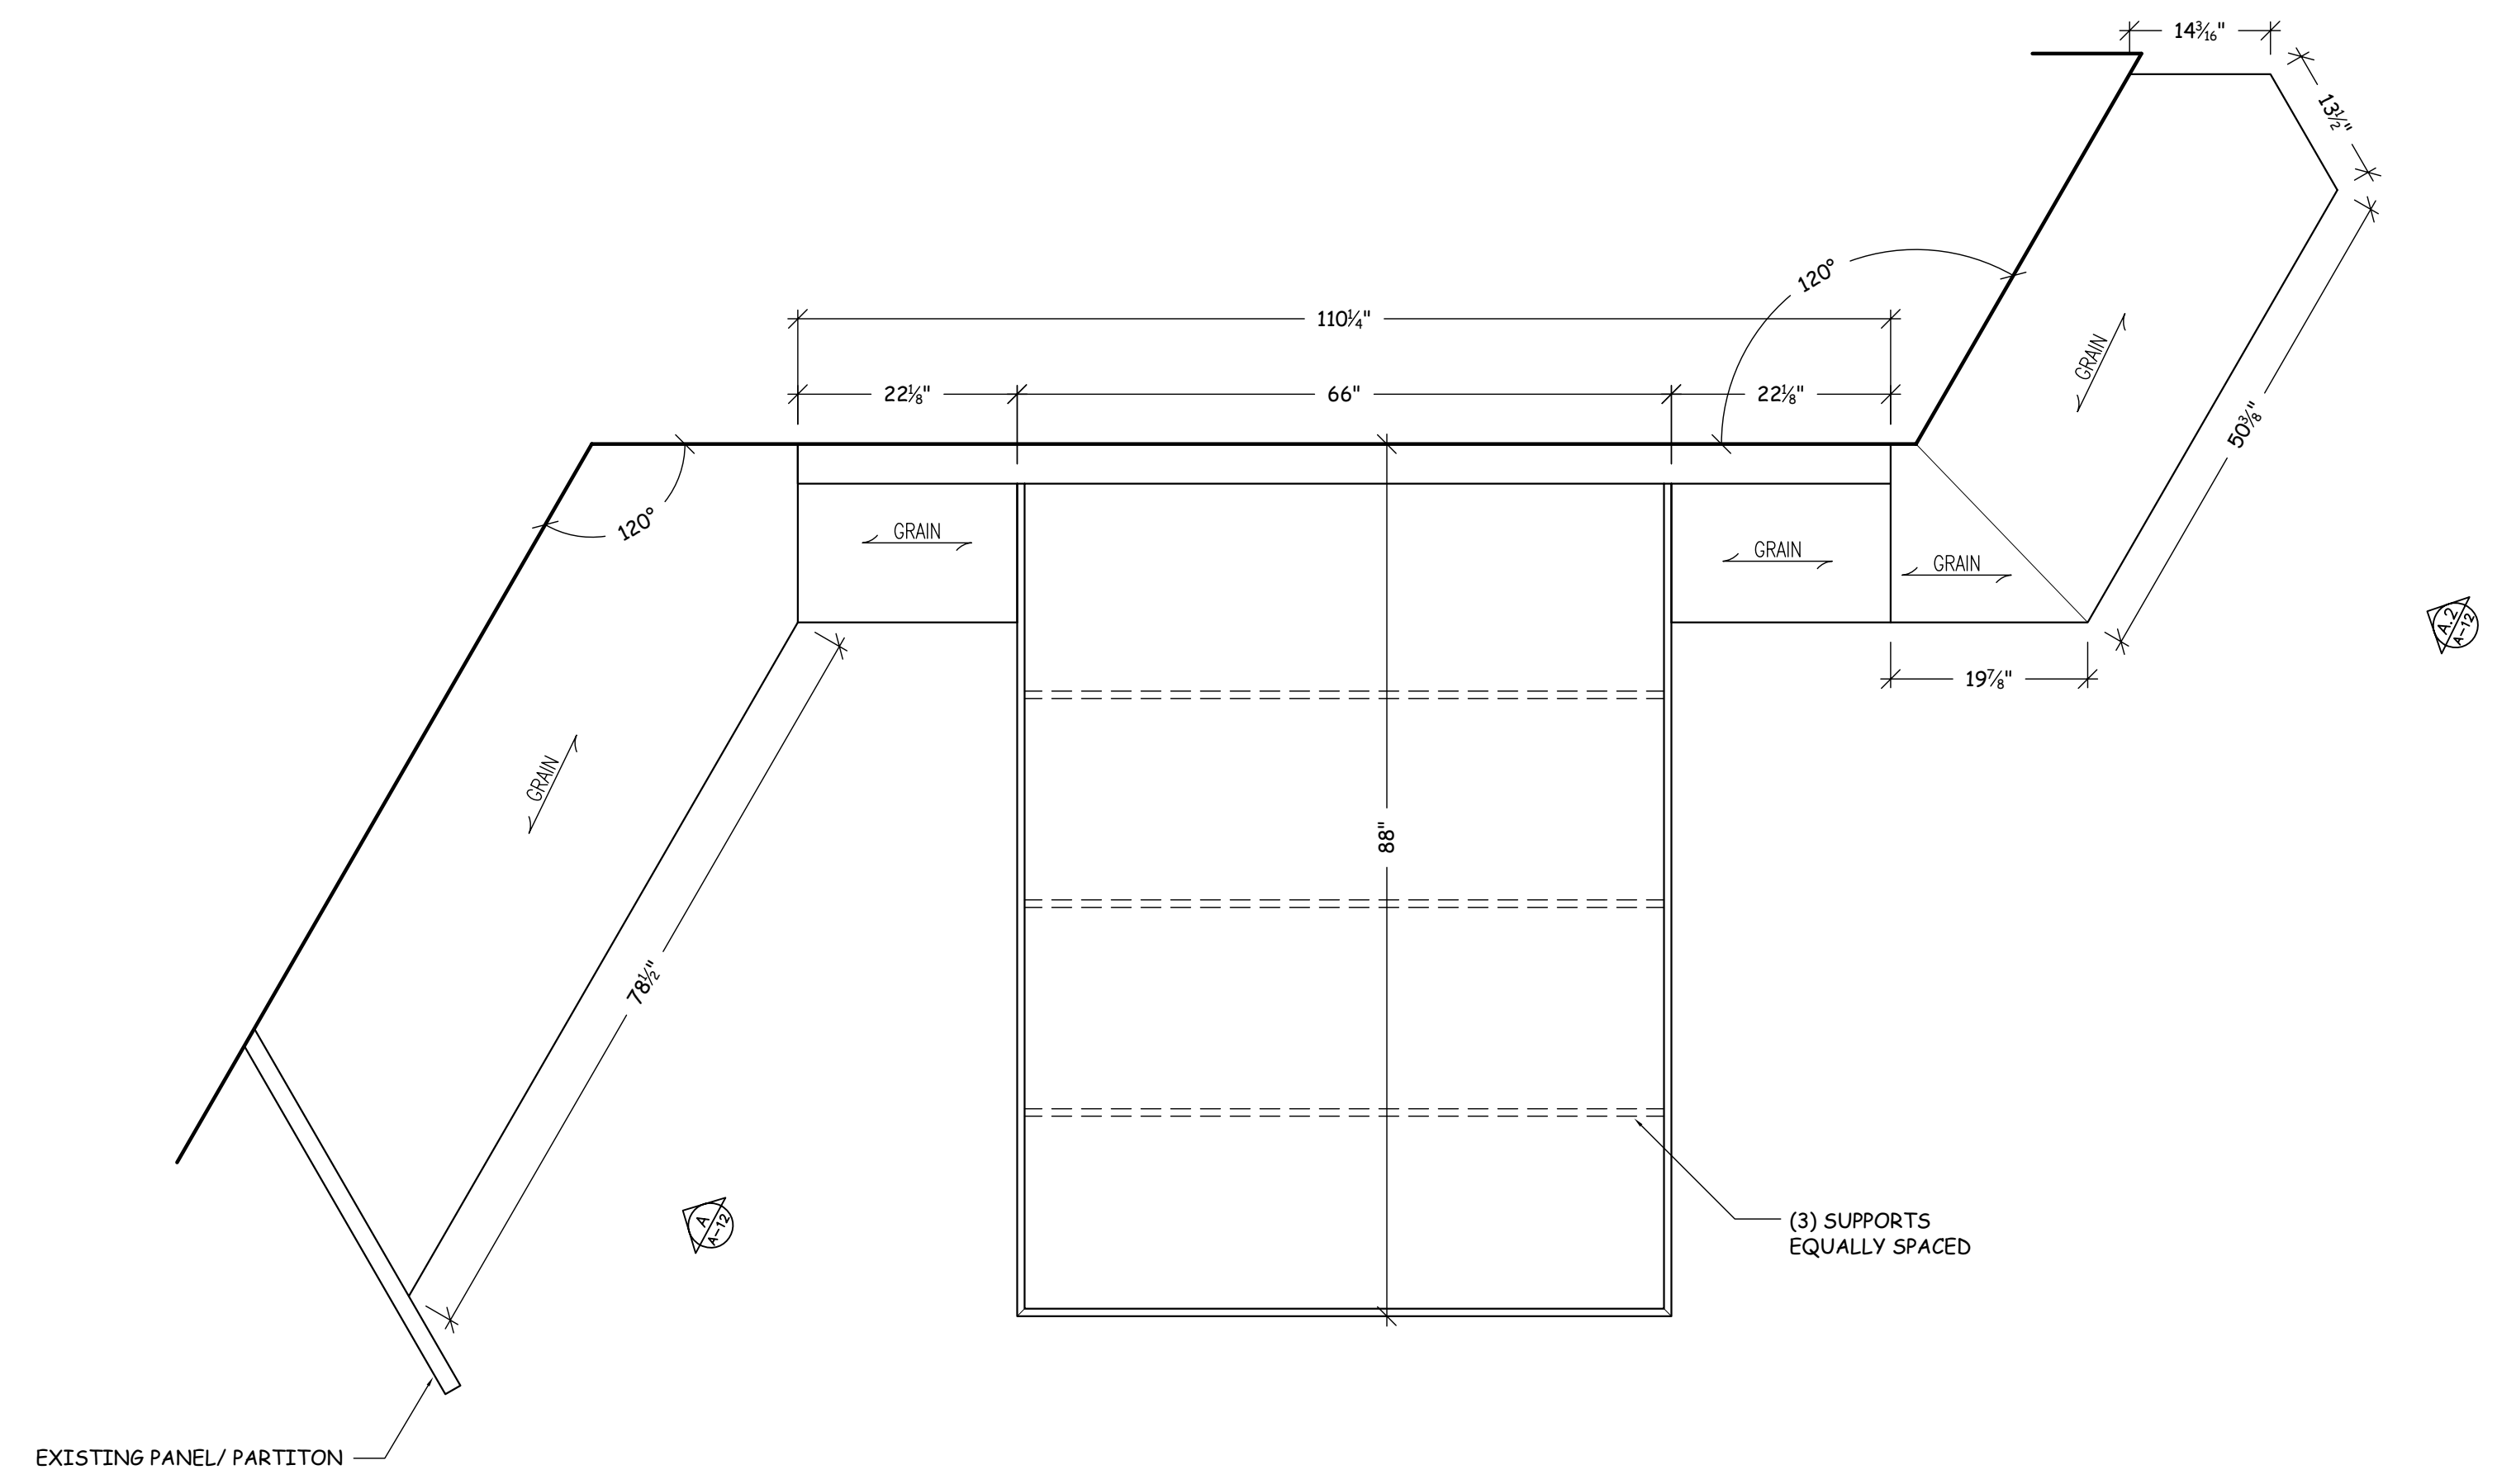

EXISTING PANEL / PARTITION

PLAN - MASTER BEDROOM
SCALE: 3/4" = 1'-0"

General Notes

SHOP NOTES:

N&N Architectural Drafting Service
Computer Aided Design & Drafting / CNC Programming

LEGEND:

 VIEW
 SHEET NO.
 DIRECTION OF VIEW


Drawn by Neno K.

No.	Revision/Issue	Date


DRAWING RECORD

ARCHITECT: GENESIS
 CONTRACTOR:
 Project Name and Address:


Project: - Sheet: A-II
 Date: 7-23-07
 JOB # : *

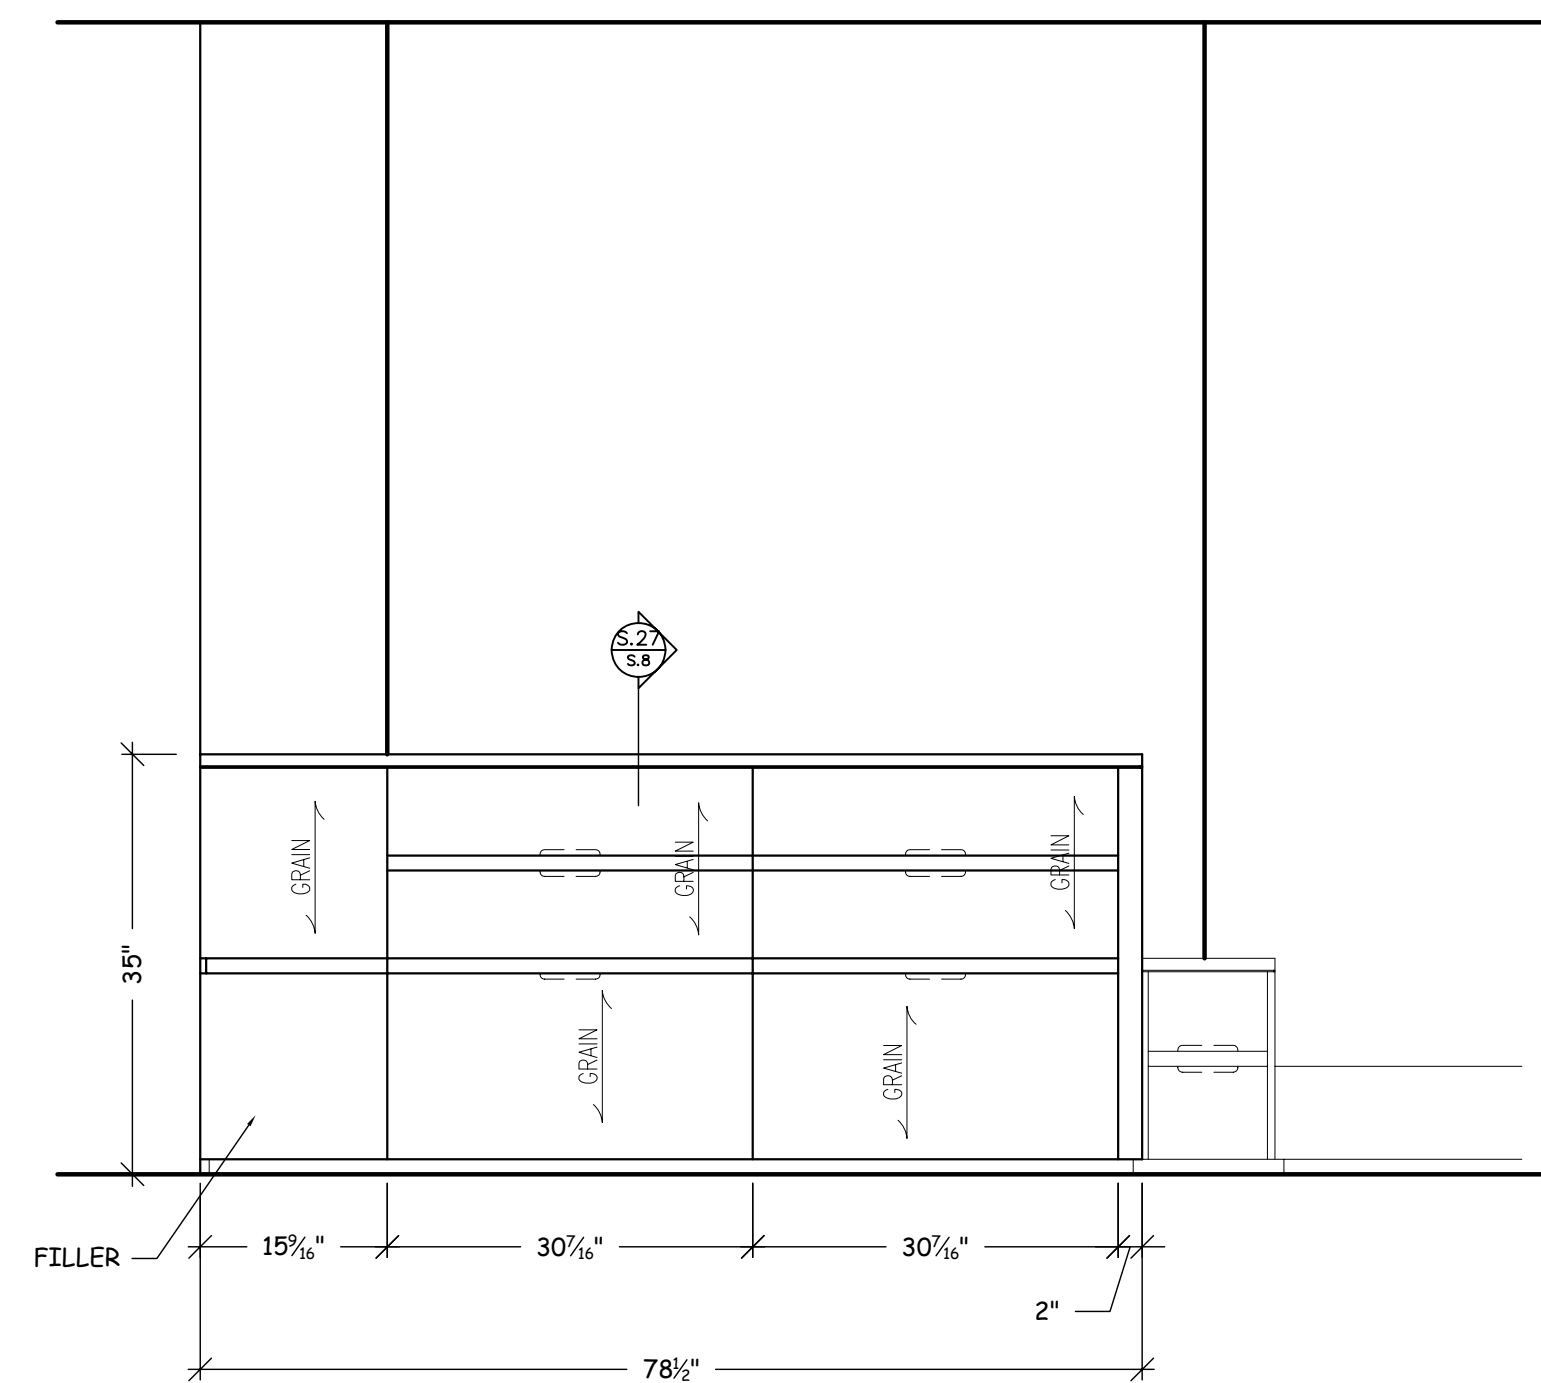


A ELEVATION
SCALE: 3/4" = 1'-0"

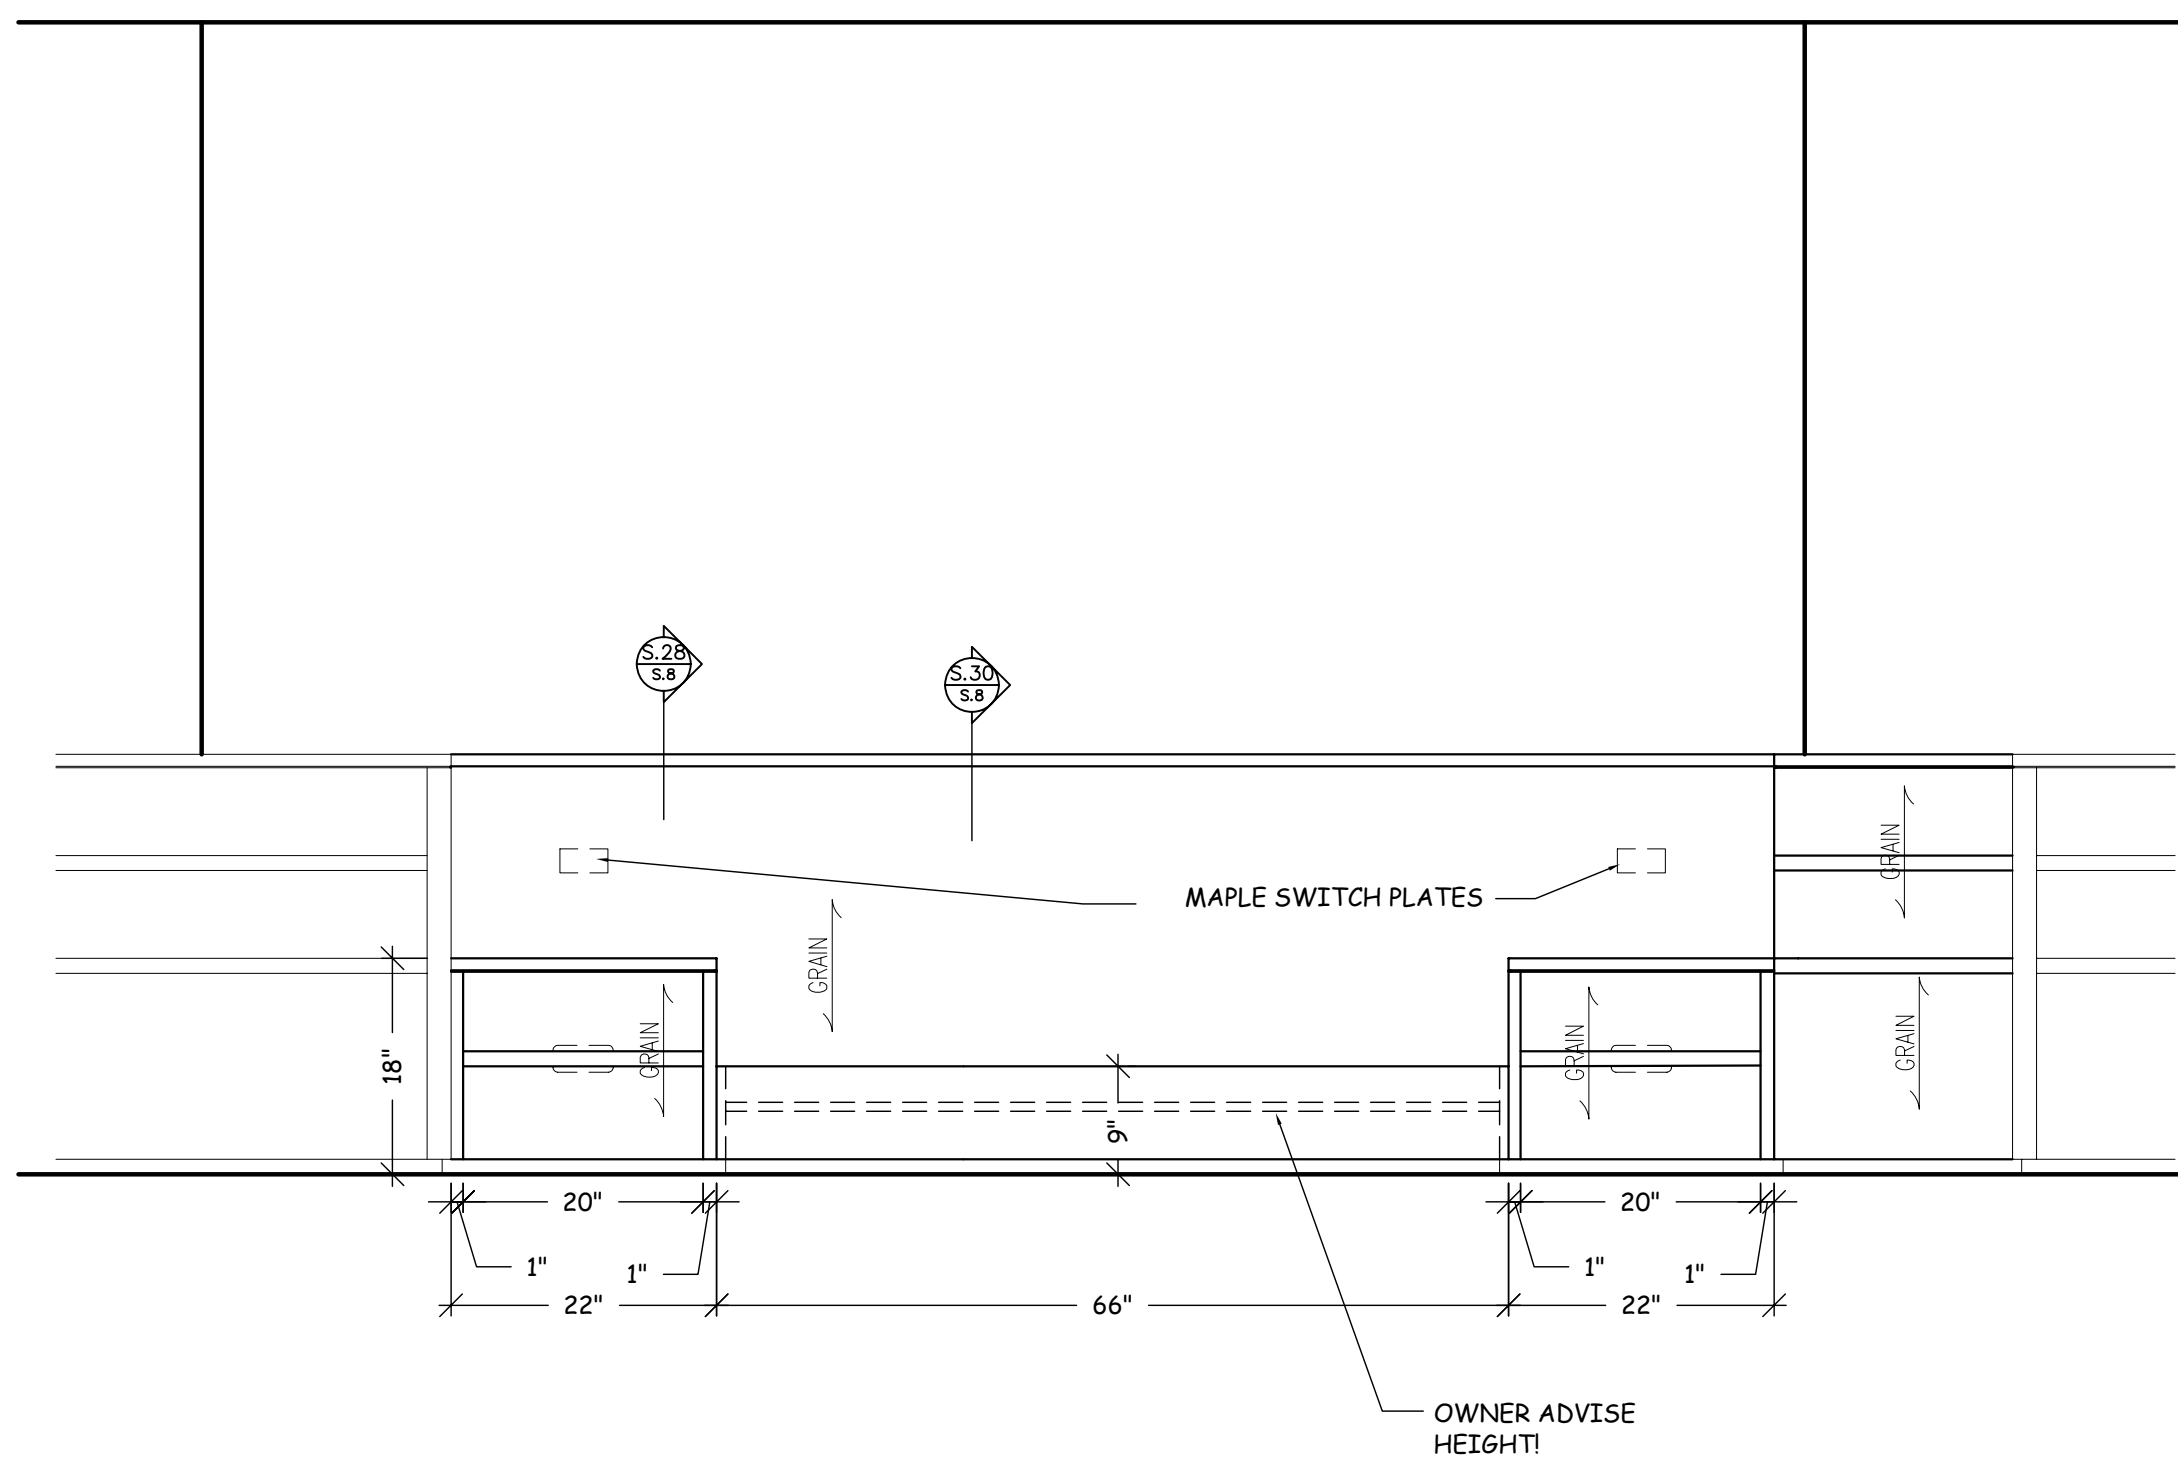

A.1 ELEVATION
SCALE: 3/4" = 1'-0"

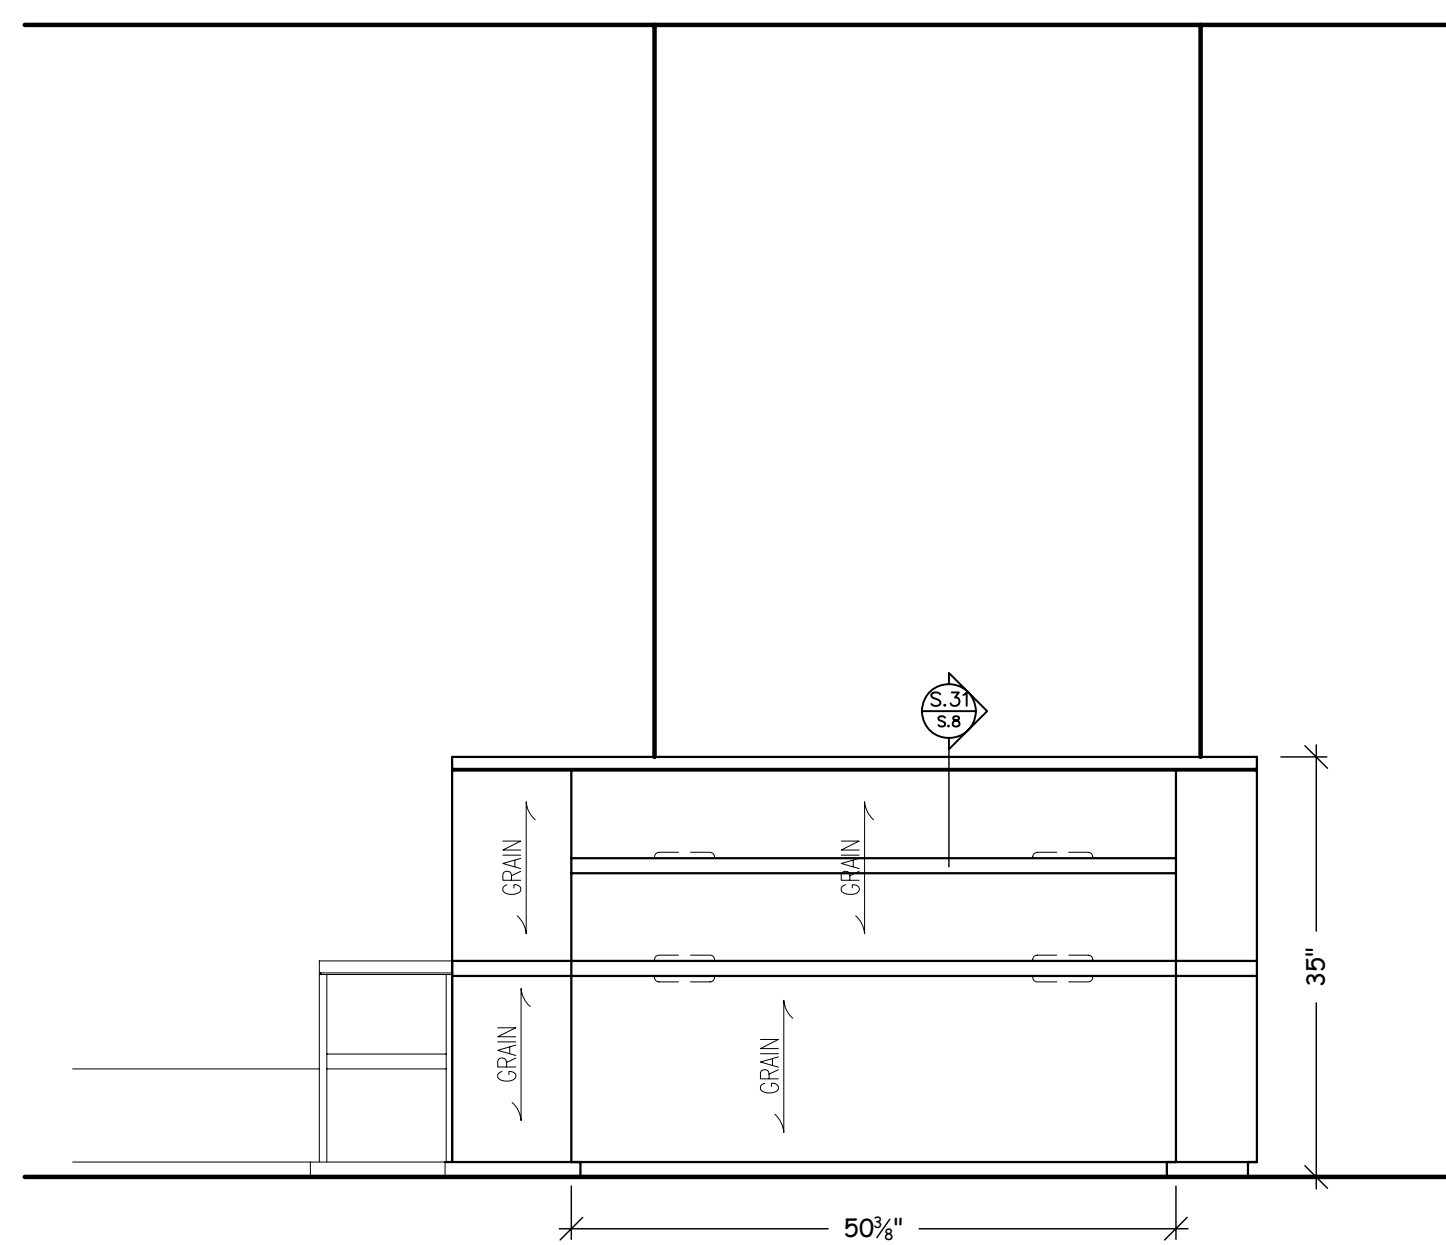

A.2 ELEVATION
SCALE: 3/4" = 1'-0"

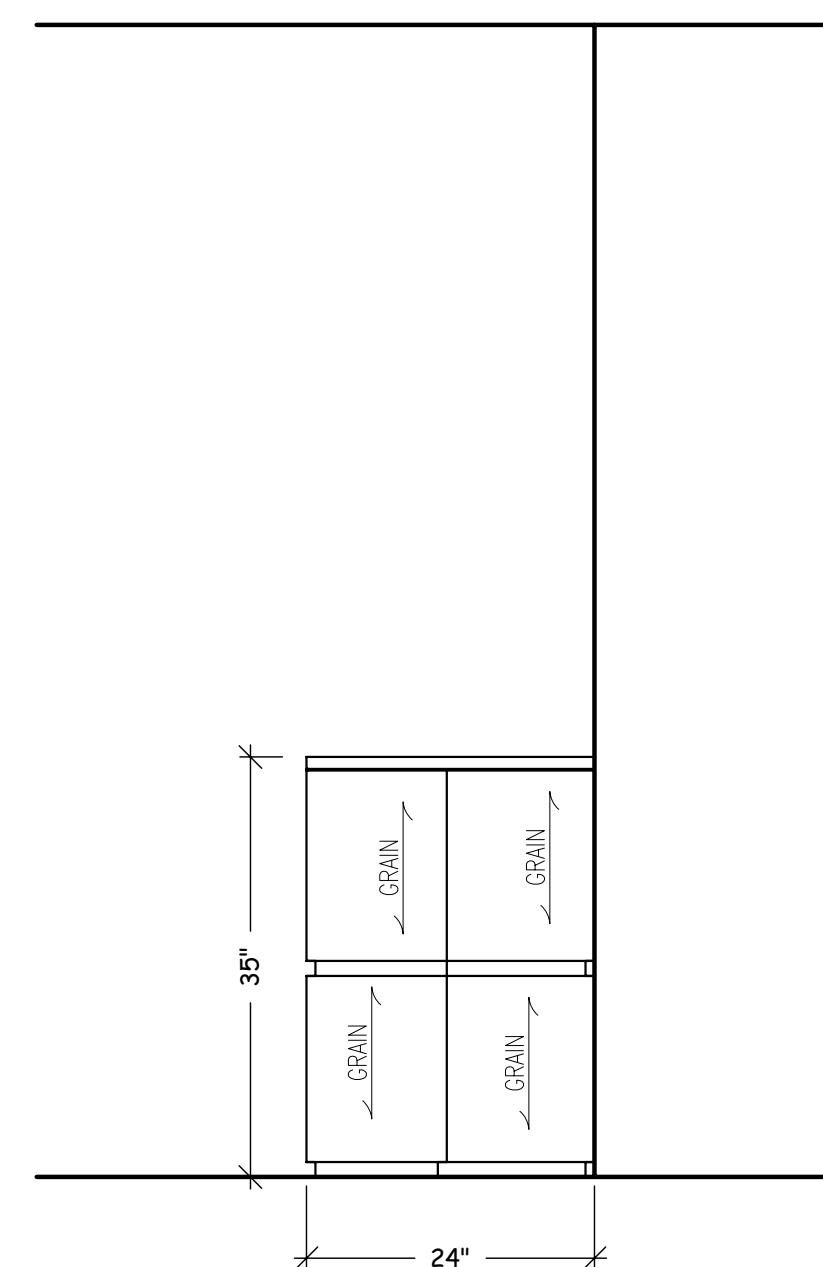


A.3 ELEVATION
SCALE: 3/4" = 1'-0"

General Notes

SHOP NOTES:

N&N Architectural Drafting Service
Computer Aided Design & Drafting/ CNC Programming

LEGEND:

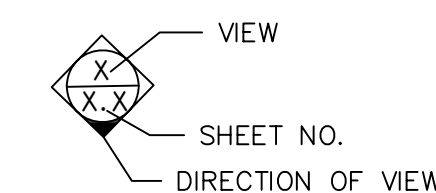

Drawn by Neno K.

No.	Revision/Issue	Date

DRAWING RECORD

ARCHITECT:

CONTRACTOR:


Project Name and Address:

Project: _____ Sheet: _____


Date: **7-23-07**

JOB # : *

A-12

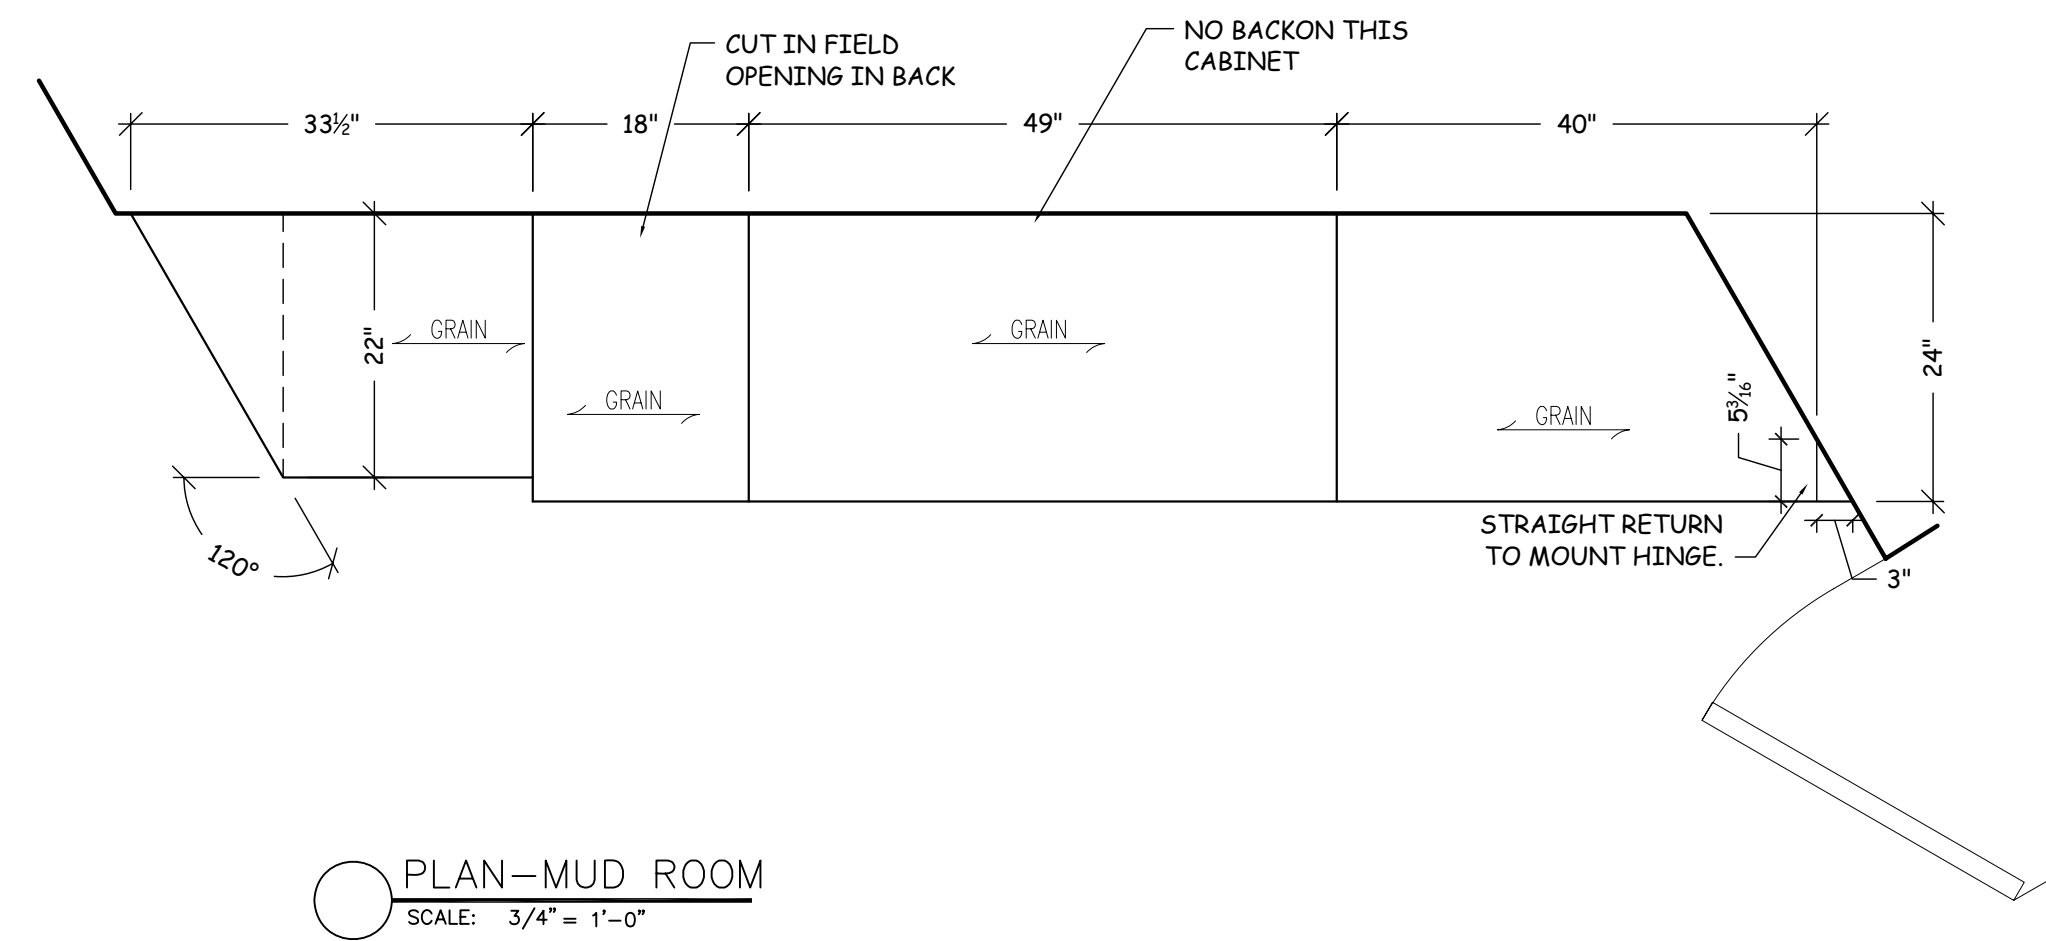

PLAN-MUD ROOM
SCALE: 3/4" = 1'-0"

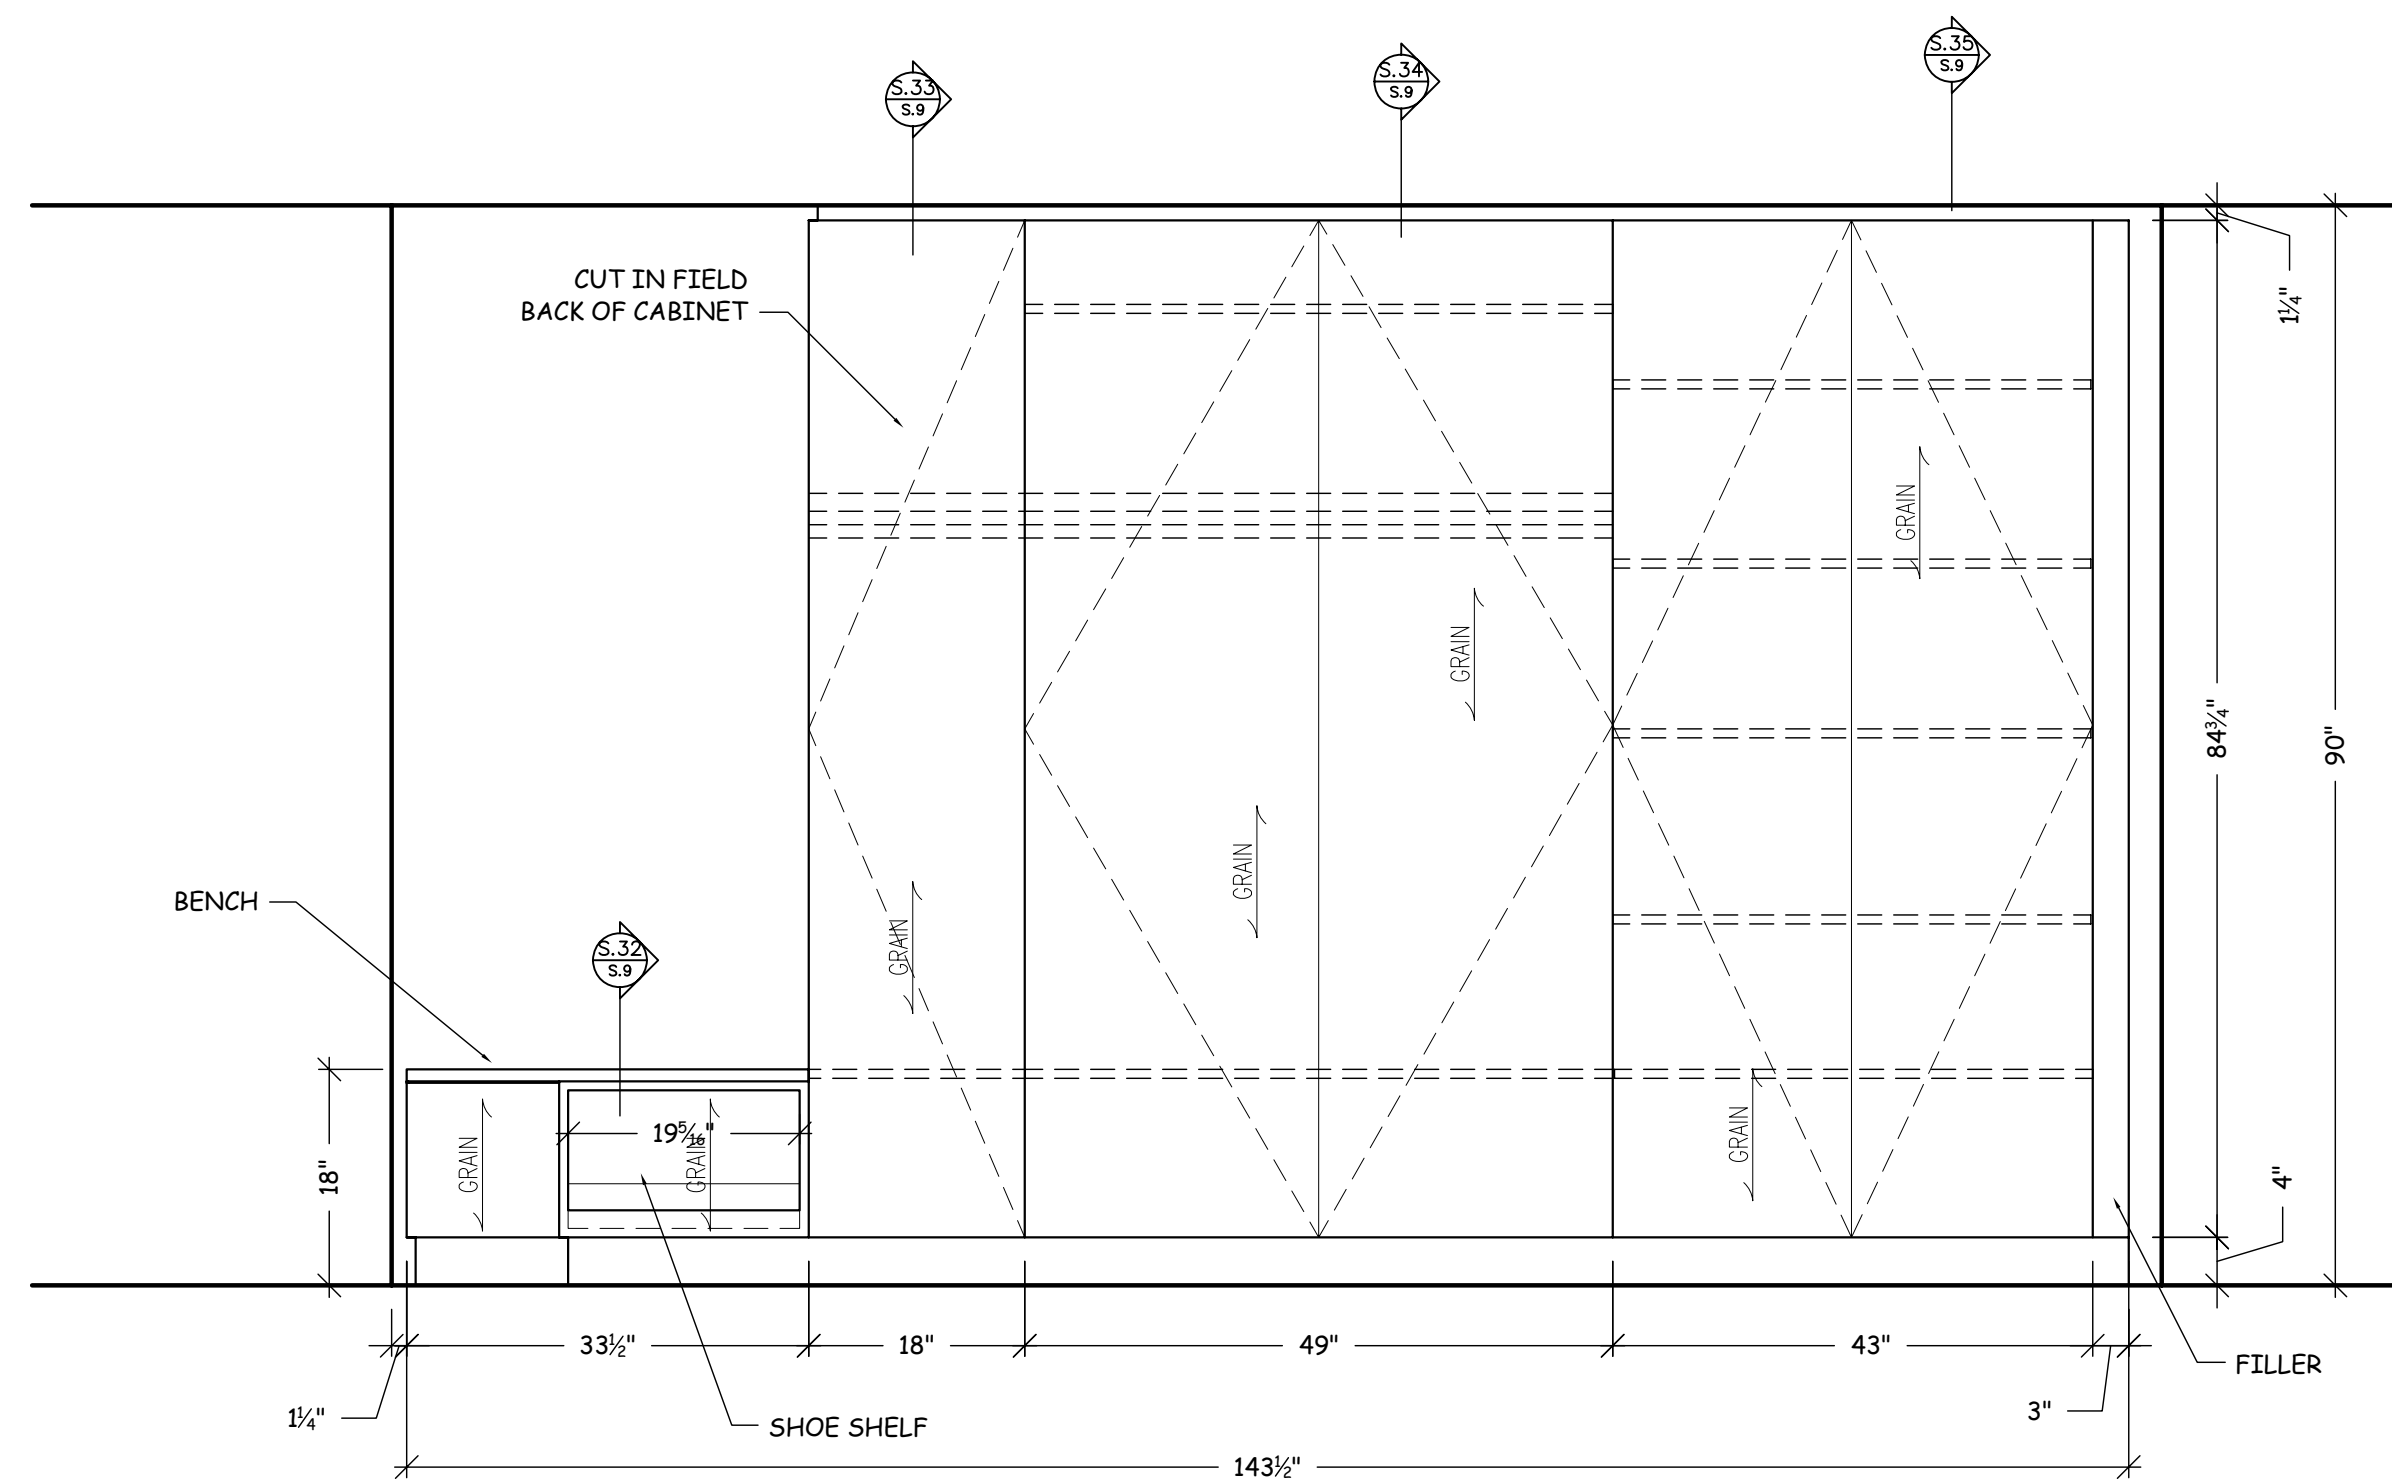

ELEVATION
SCALE: 3/4" = 1'-0"

General Notes

SHOP NOTES:

N&N Architectural Drafting Service
Computer Aided Design & Drafting/ CNC Programming

LEGEND:
VIEW
SHEET NO.
DIRECTION OF VIEW


Drawn by Nono K.

No.	Revision/Issue	Date

DRAWING RECORD

ARCHITECT:
CONTRACTOR:
Project Name and Address:

Project: -
Date: 7-23-07
JOB # : *
Sheet: A-13

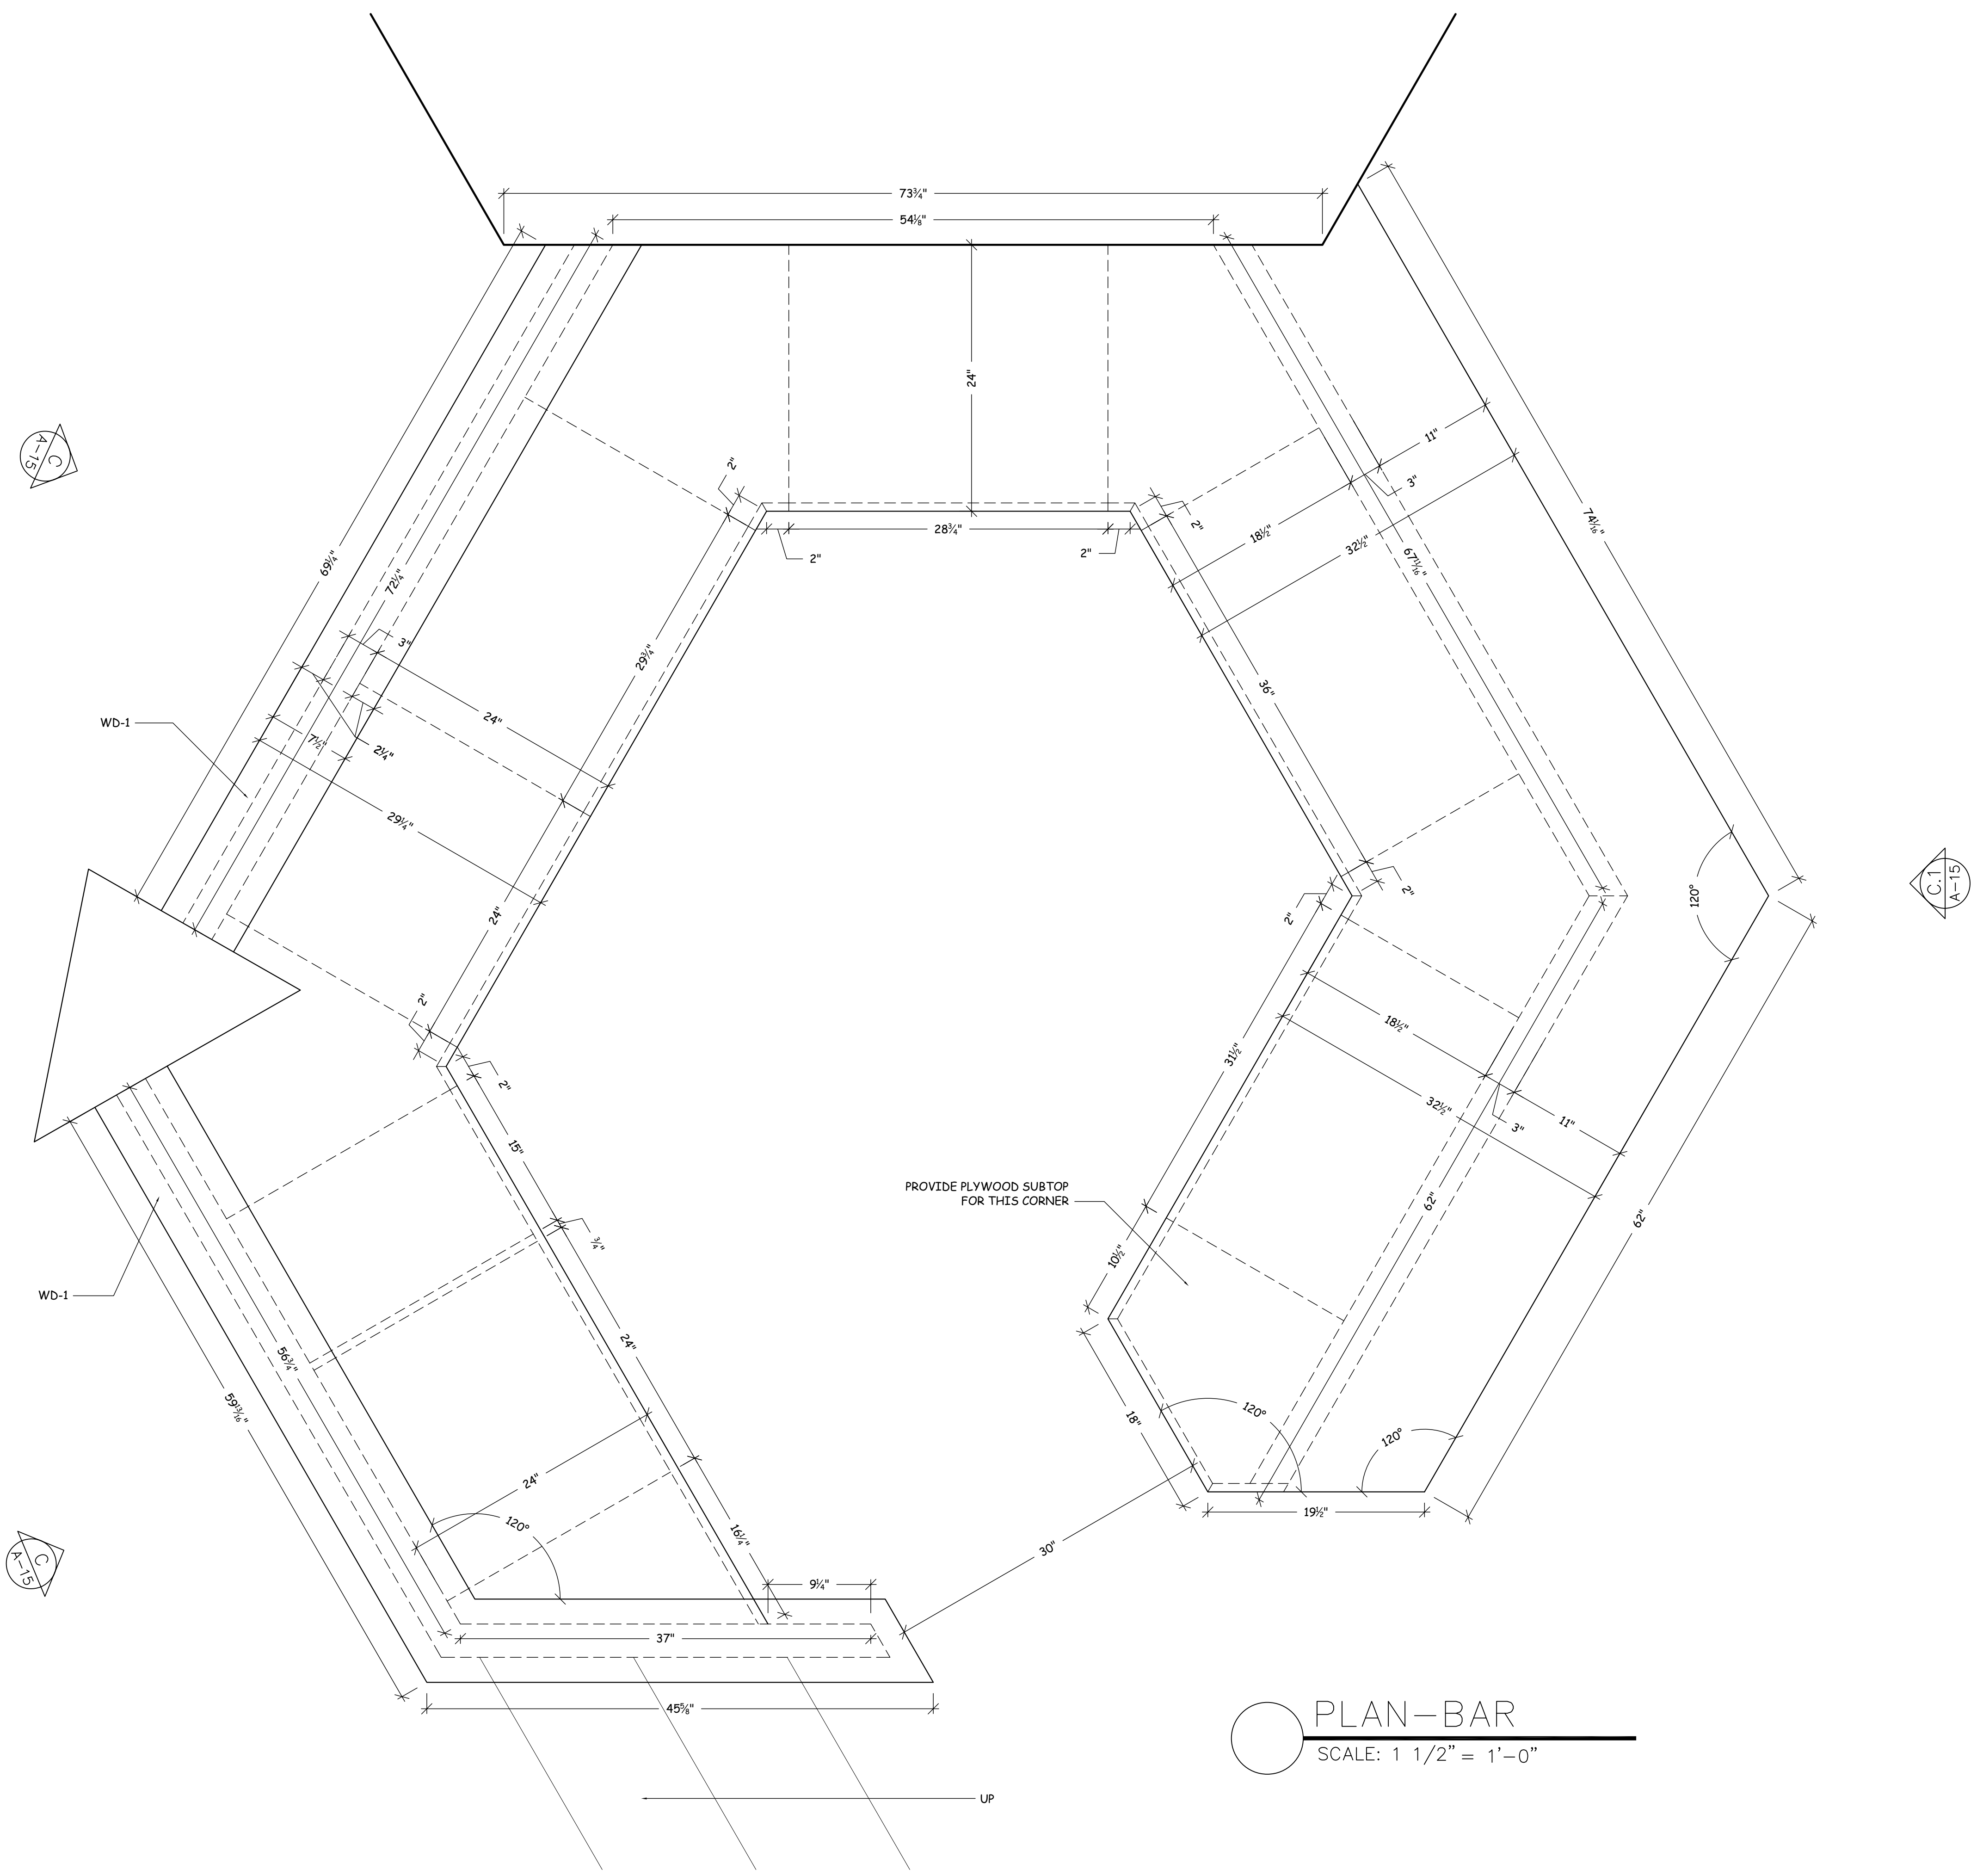

PLAN-BAR
SCALE: 1 1/2" = 1'-0"

General Notes

SHOP NOTES:

N&N Architectural Drafting Service
Computer Aided Design & Drafting/ CNC Programming

LEGEND:

 VIEW
 SHEET NO.
 DIRECTION OF VIEW


Drawn by Neno K.

No.	Revision/Issue	Date


DRAWING RECORD

ARCHITECT:
 CONTRACTOR:
 Project Name and Address:


Project: _____ Date: **7-23-07**
 Sheet: **A-14**
 Job #: *

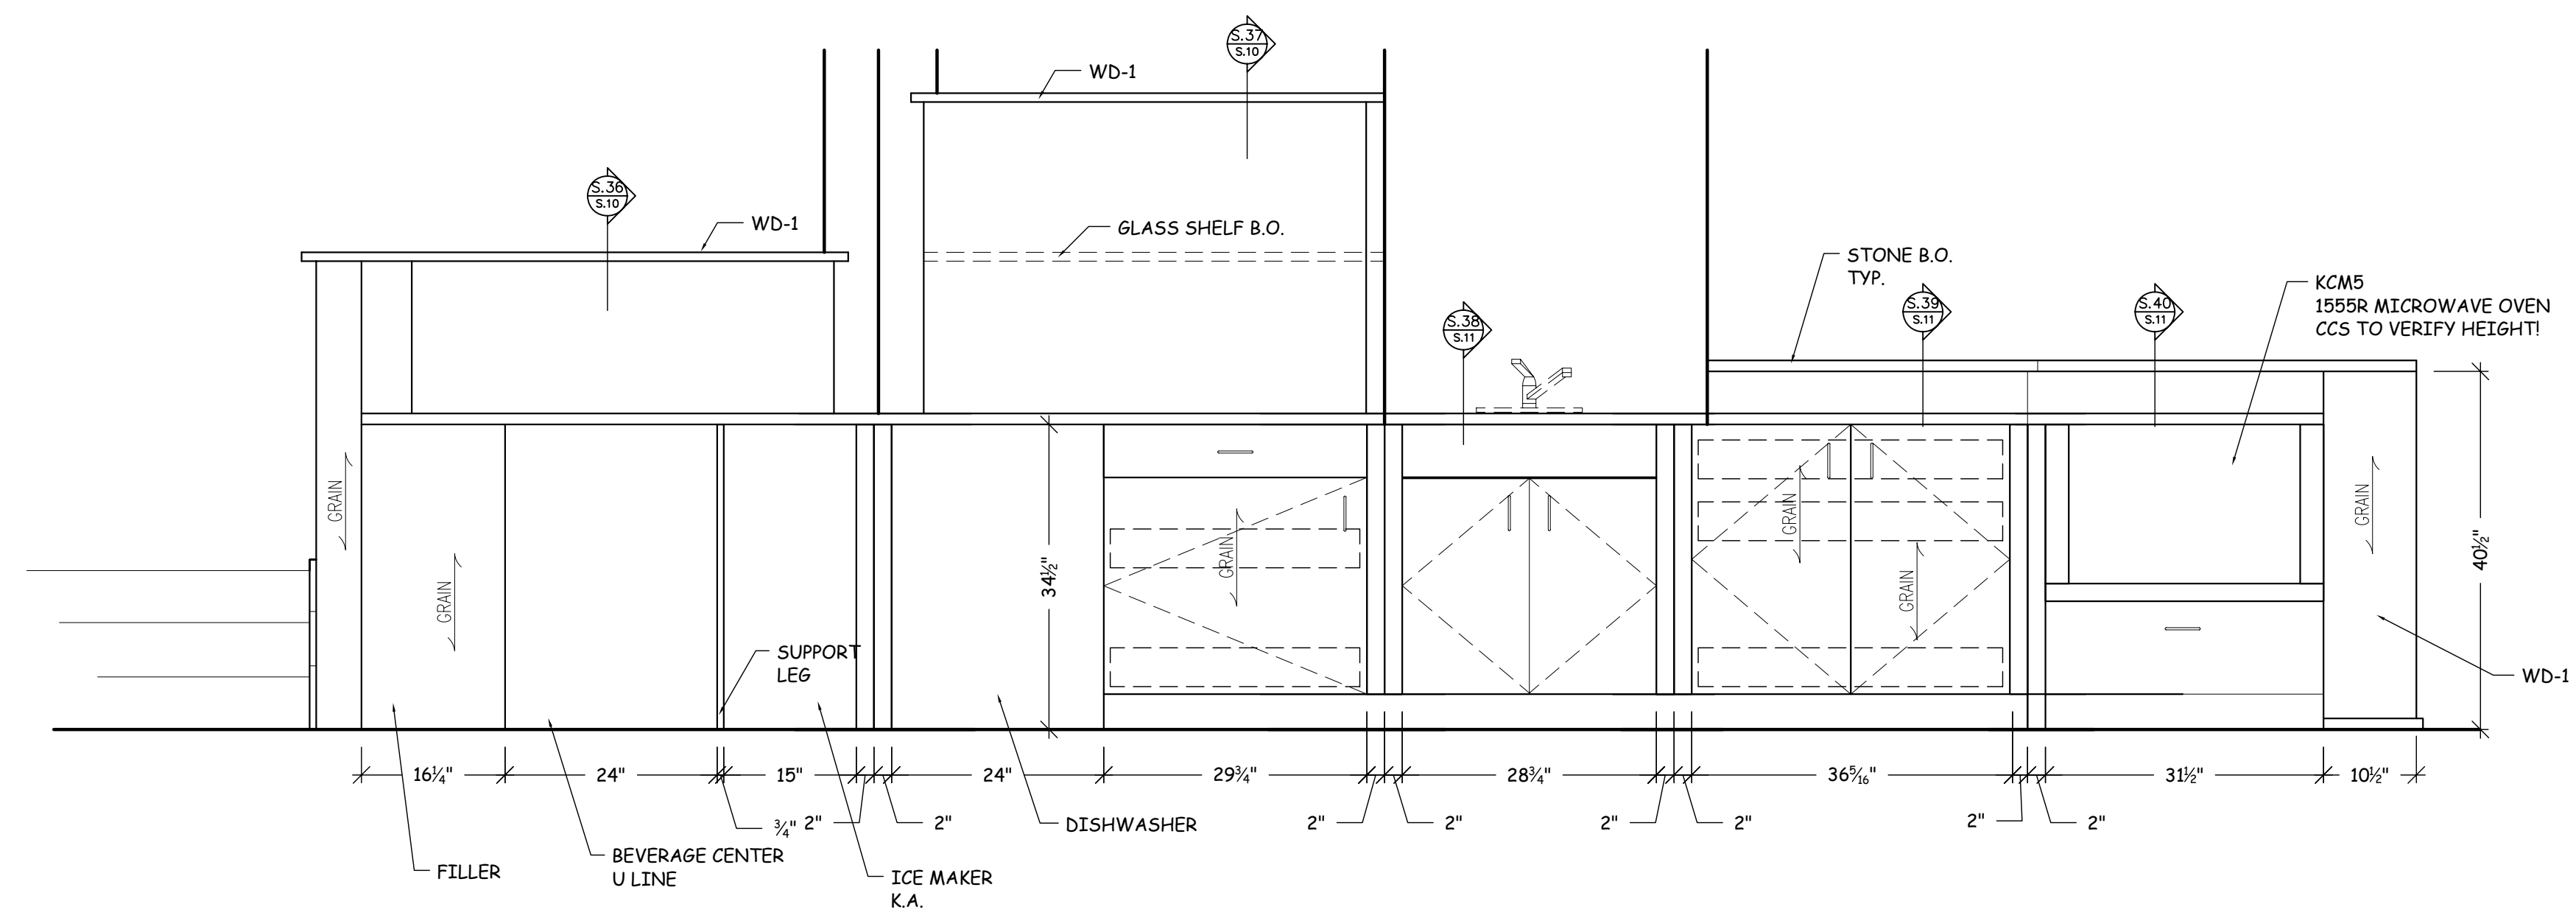

ELEVATION - INSIDE OF BAR
SCALE: 3/4" = 1'-0"

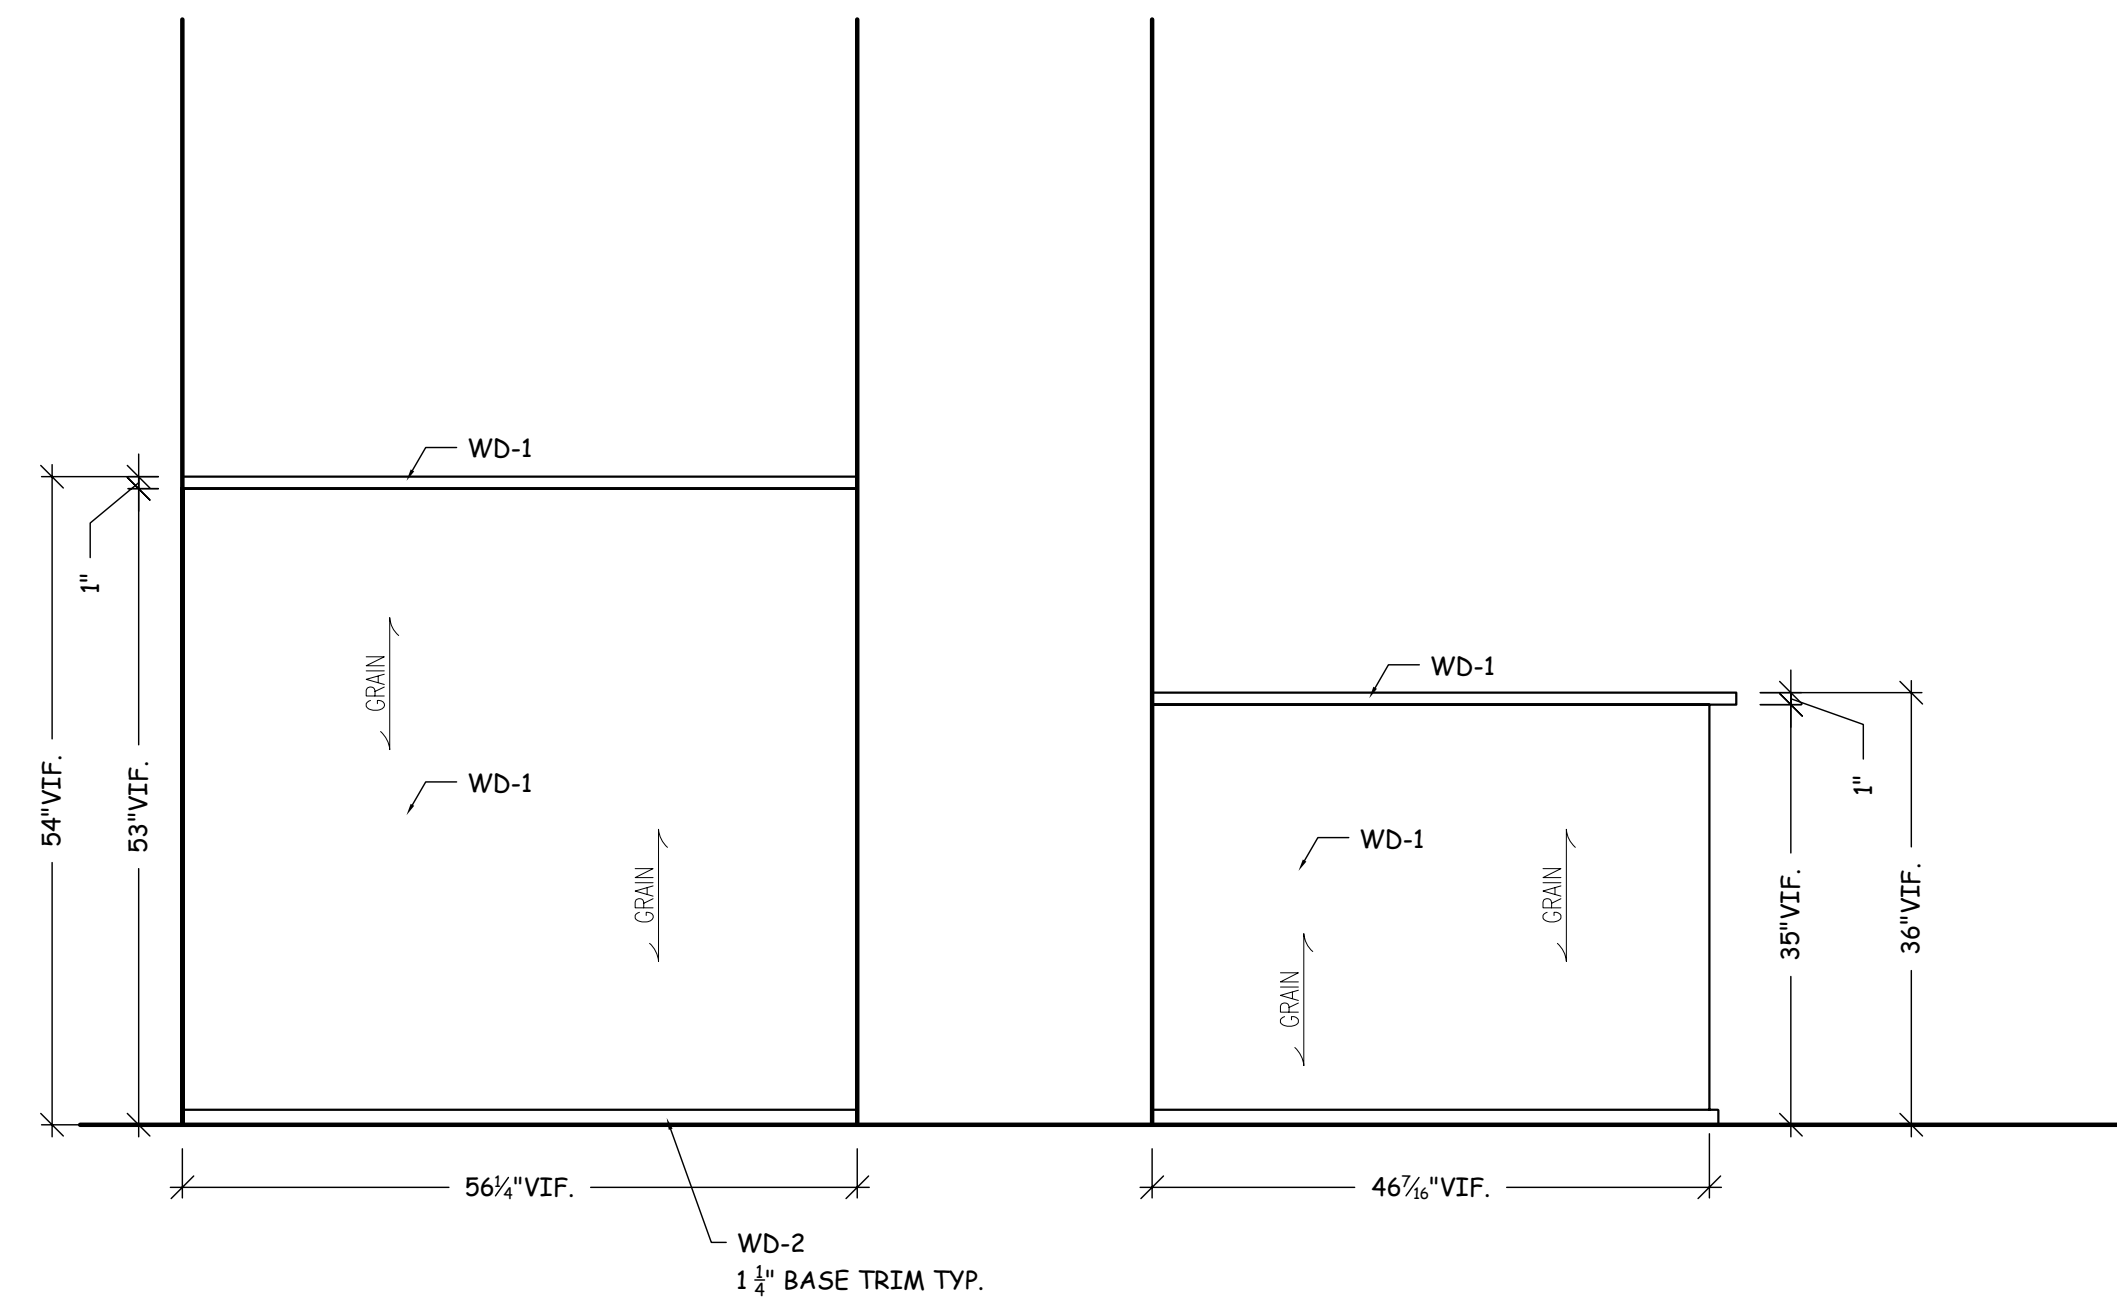

C ELEVATION
SCALE: 3/4" = 1'-0"

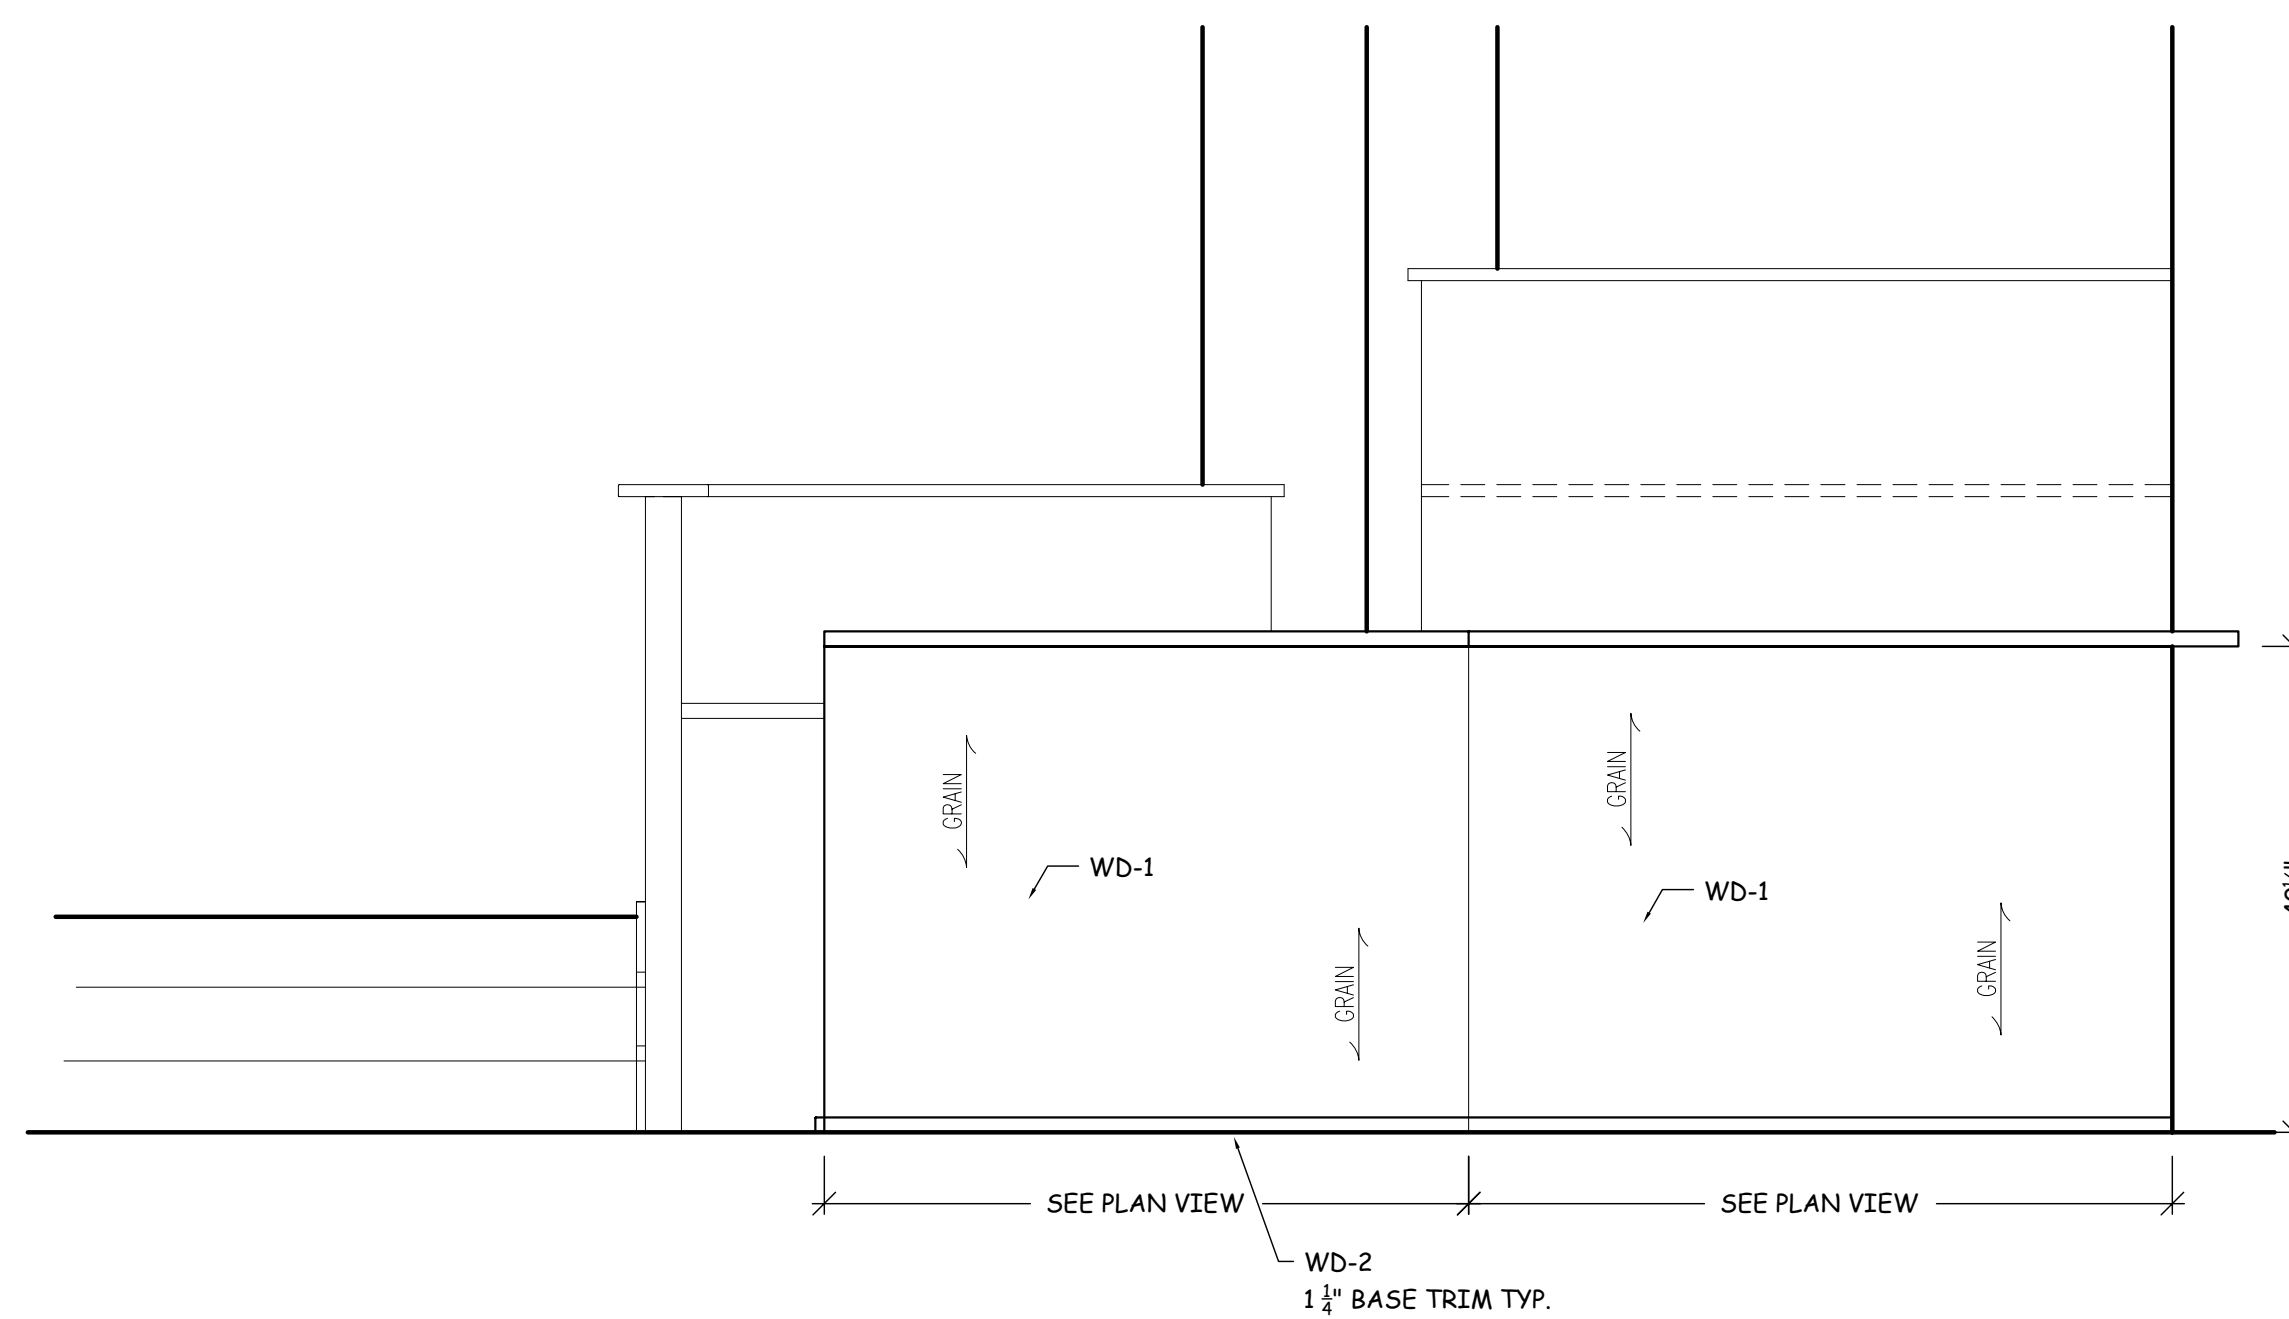

C.1 ELEVATION
SCALE: 3/4" = 1'-0"

General Notes

SHOP NOTES:

N&N Architectural Drafting Service
Computer Aided Design & Drafting/ CNC Programming

LEGEND:
VIEW
SHEET NO.
DIRECTION OF VIEW

Drawn by Neno K.

No.	Revision/Issue	Date

DRAWING RECORD


ARCHITECT:
CONTRACTOR:
Project Name and Address:

Project: - Sheet:
Date: **7-23-07** A-15
JOB # : *

General Notes

SHOP NOTES:

N&N Architectural Drafting Service
Computer Aided Design & Drafting/ CNC Programming

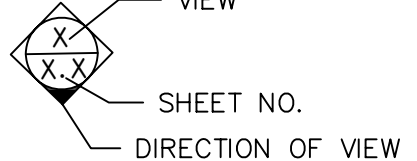LEGEND:

 X VIEW
 X X SHEET NO.
 X DIRECTION OF VIEW


Drawn by Neno K.

No.	Revision/Issue	Date
-	FIELD UPDATES	2-05
1	MARKUP PER OWNER/ARCH.	2-27


DRAWING RECORD

ARCHITECT:
 CONTRACTOR:
 Project Name and Address:


Project: **SECTIONS** Sheet:
 Date: **1-29-07** **S-1**
 JOB # : *

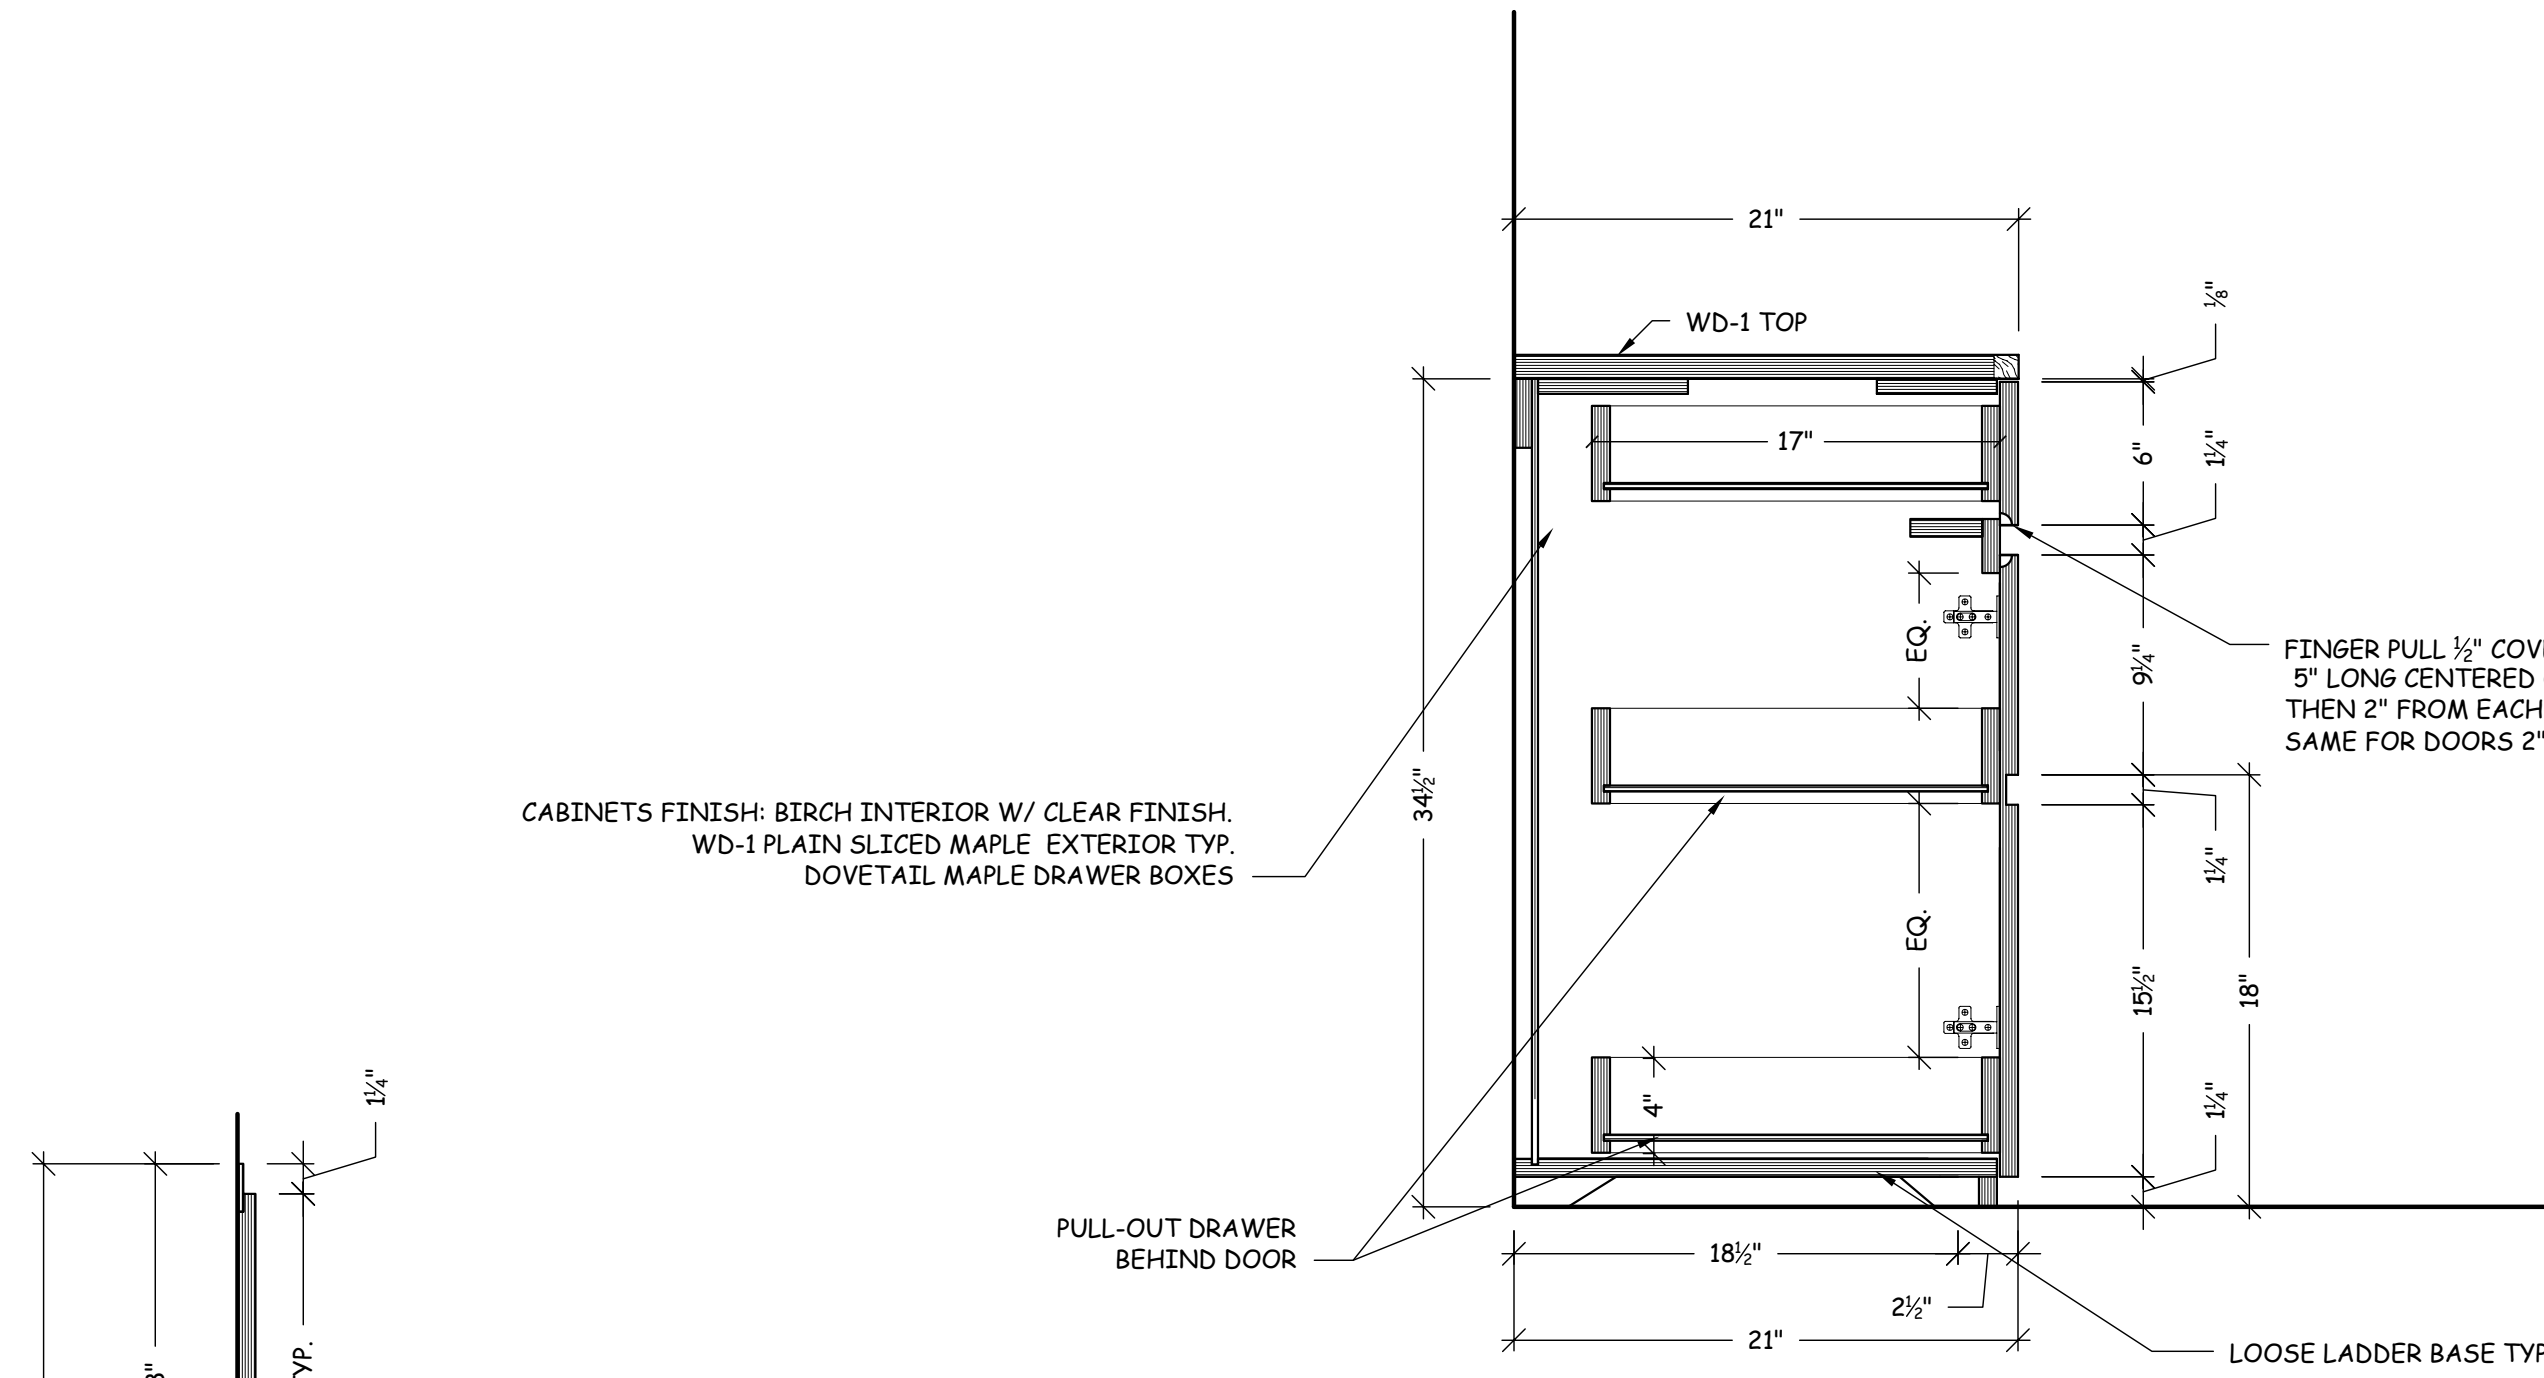


S.4 SECTION- BUFFET @ DINNING RM.
SCALE: 1 1/2" = 1'-0"

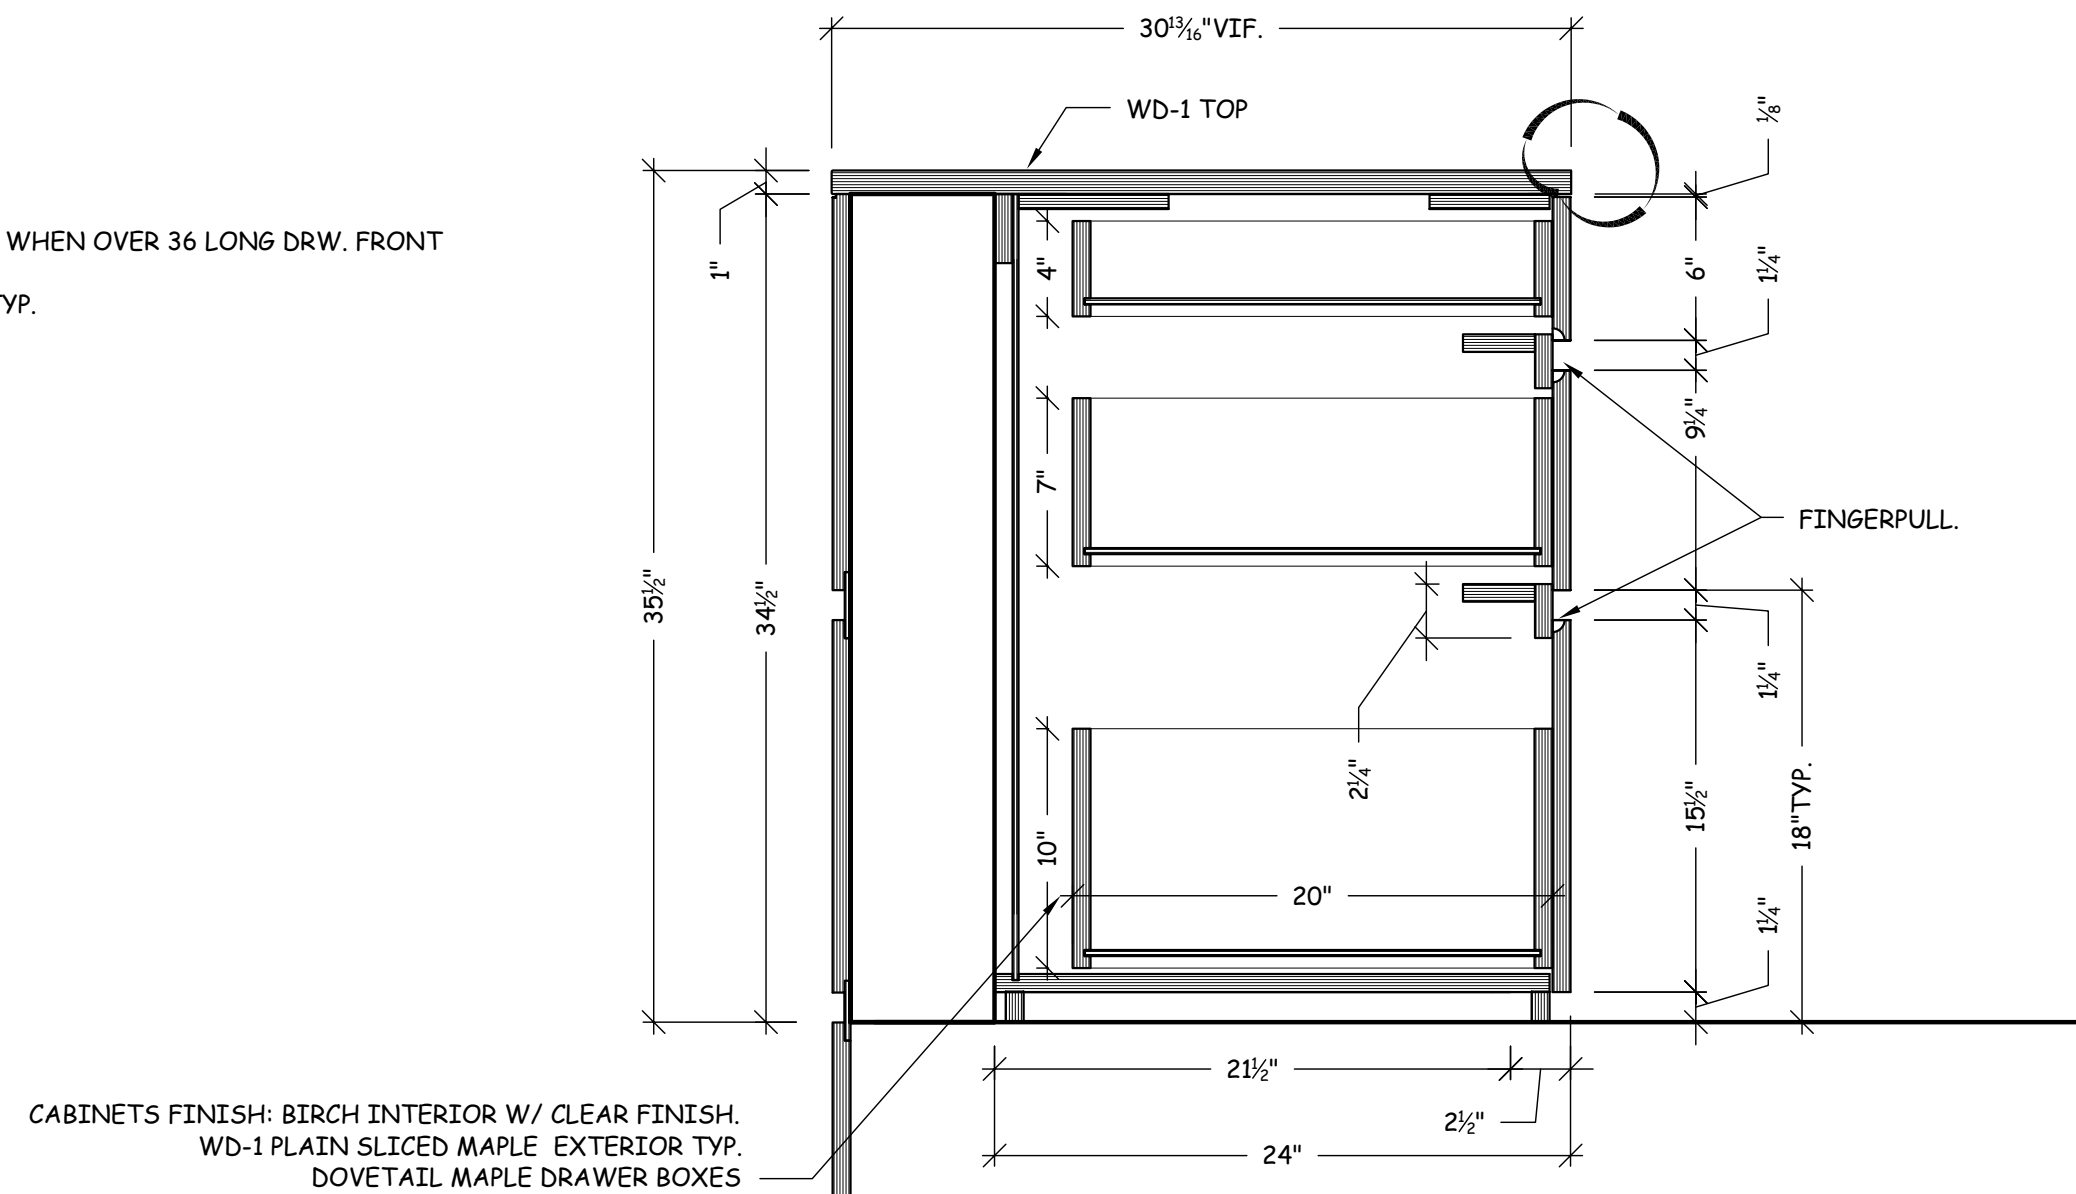



S.5 SECTION-BUFFET @ HALF WALL DINNING RM
SCALE: 1 1/2" = 1'-0"

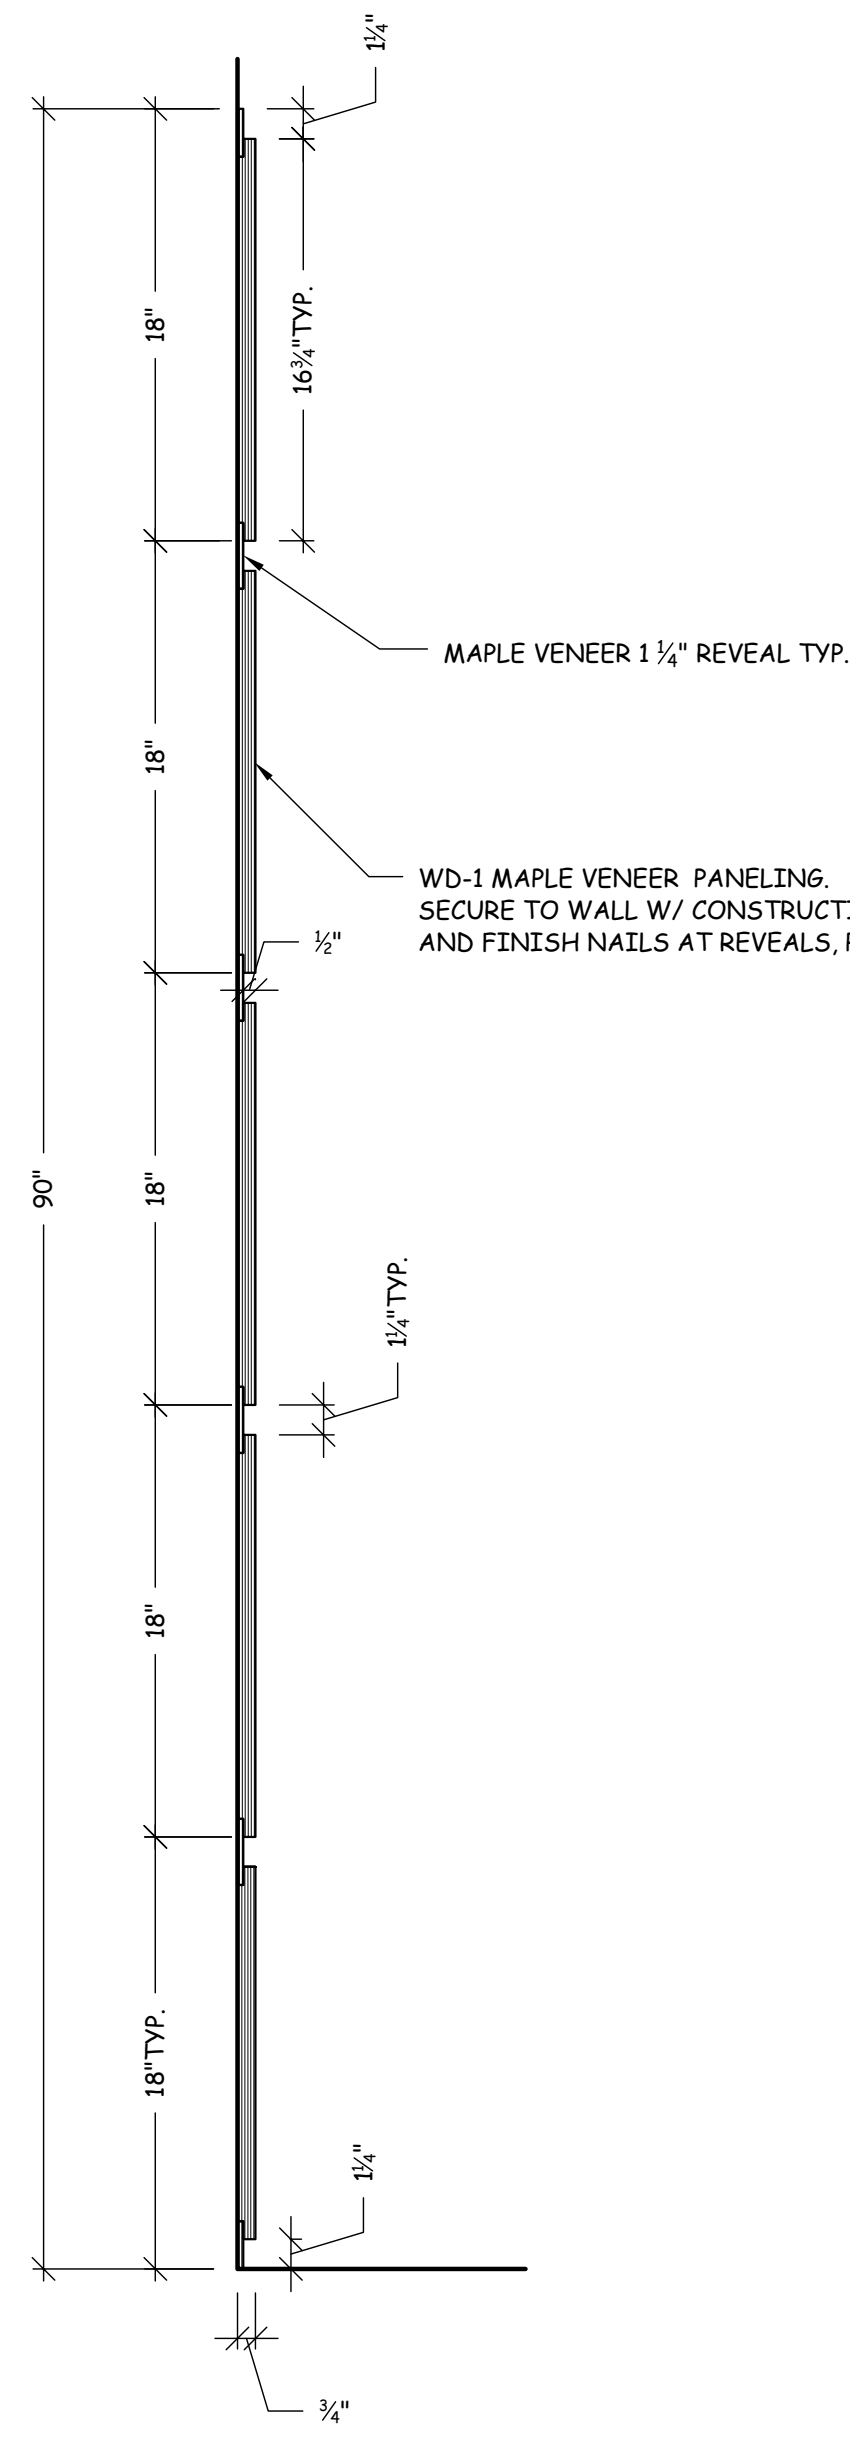

S.1 SECTION- PANELING
SCALE: 1 1/2" = 1'-0"

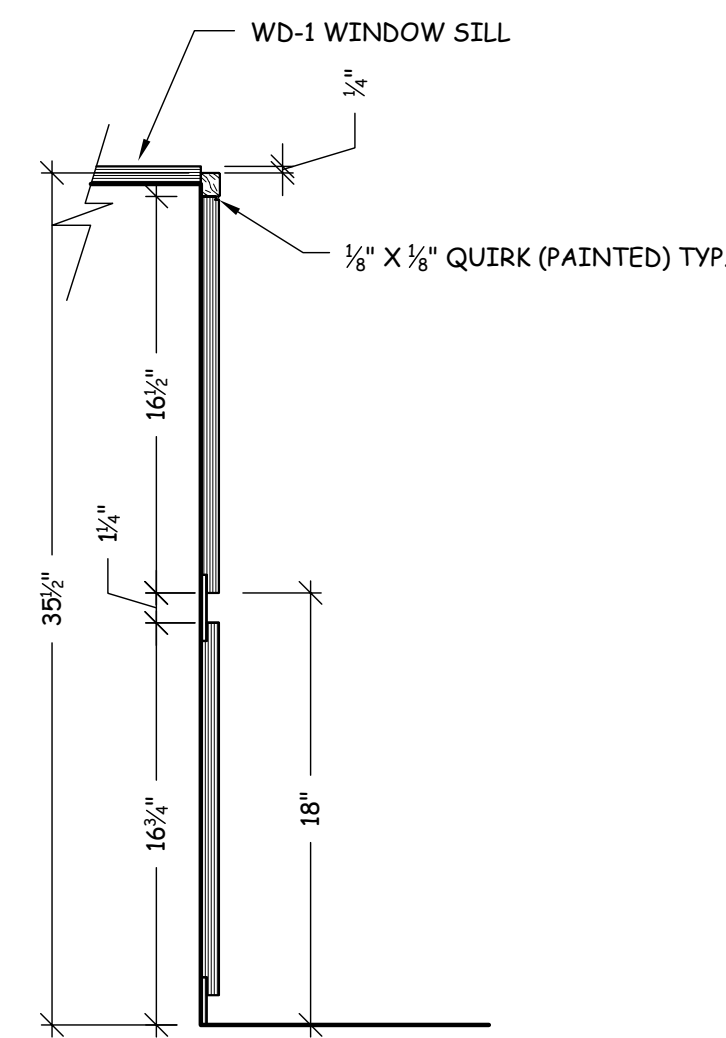

S.2 SECTION-PANELING
SCALE: 1 1/2" = 1'-0"

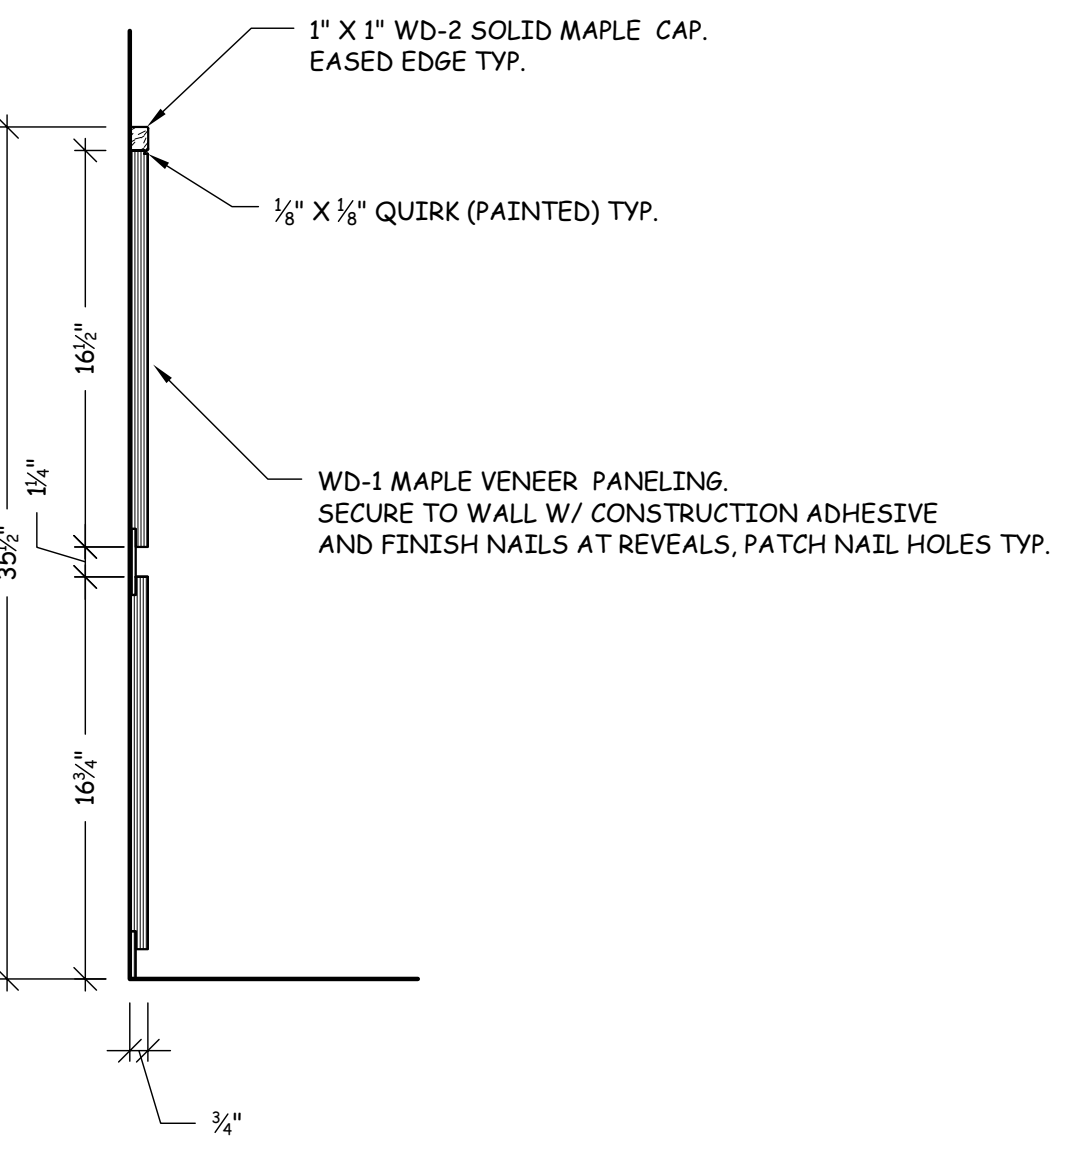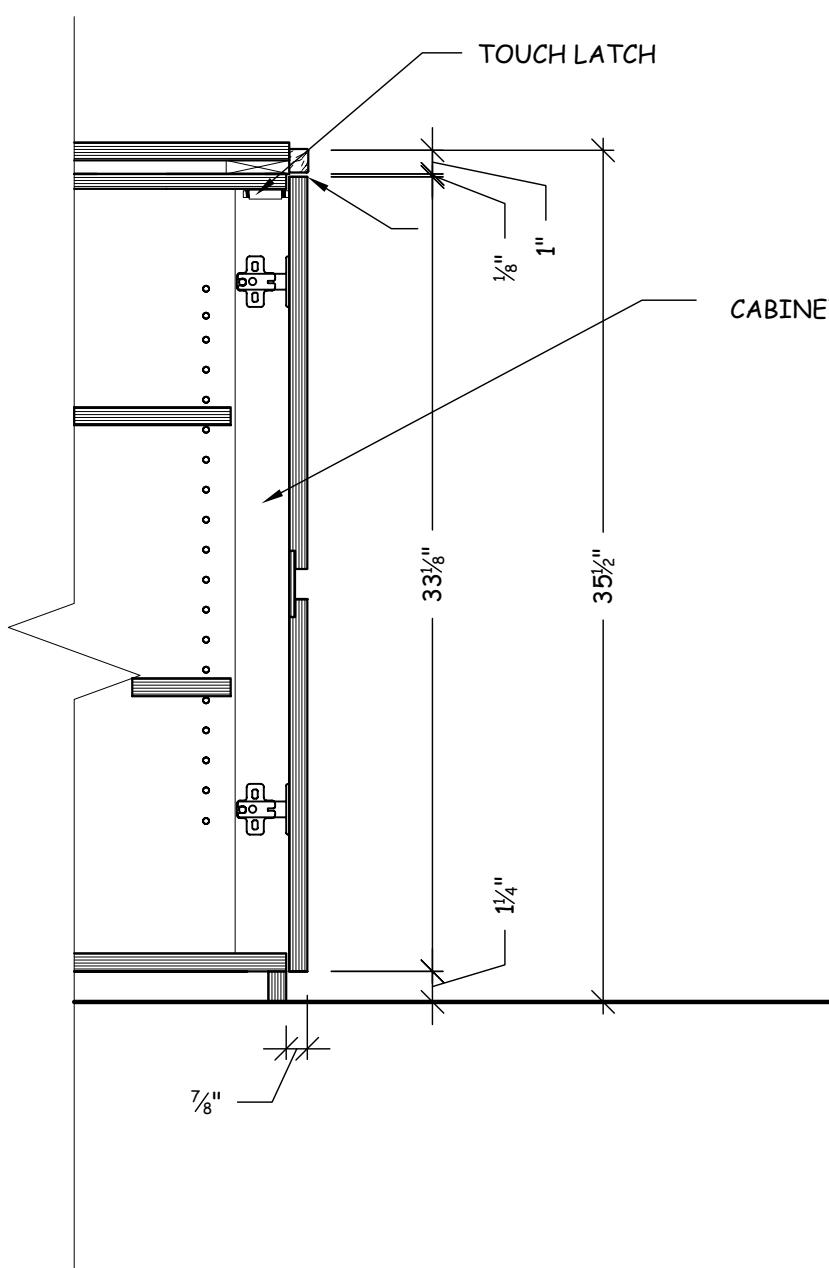

S.3 SECTION-PANELING
SCALE: 1 1/2" = 1'-0"

CABINETS FINISH: BIRCH INTERIOR W/ CLEAR FINISH.
WD-1 PLAIN SLICED MAPLE EXTERIOR TYP.
DOVETAIL MAPLE DRAWER BOXES

FINGER PULL 1/2" COVE ROUTER BIT
5" LONG CENTERED ON DRAWERS EXCEPT WHEN OVER 36 LONG DRW. FRONT
THEN 2" FROM EACH END & 5" LONG.
SAME FOR DOORS 2" FROM END 5" LONG TYP.

CABINETS FINISH: BIRCH INTERIOR W/ CLEAR FINISH.
WD-1 PLAIN SLICED MAPLE EXTERIOR TYP.
DOVETAIL MAPLE DRAWER BOXES

WD-1 MAPLE VENEER PANELING.
SECURE TO WALL W/ CONSTRUCTION ADHESIVE
AND FINISH NAILS AT REVEALS, PATCH NAIL HOLES TYP.

General Notes

SHOP NOTES:

N&N Architectural Drafting Service
 Computer Aided Design & Drafting/ CNC Programming

LEGEND:


 VIEW
 SHEET NO.
 DIRECTION OF VIEW

Drawn by Nono K.


No.	Revision/Issue	Date
-	FIELD UPDATES	2-05
1	MARKUP PER OWNER/ARCH.	2-27

DRAWING RECORD


ARCHITECT:	
CONTRACTOR:	
Project Name and Address:	
Project: SECTIONS	Sheet: S-2
Date: 1-29-07	
JOB # : *	

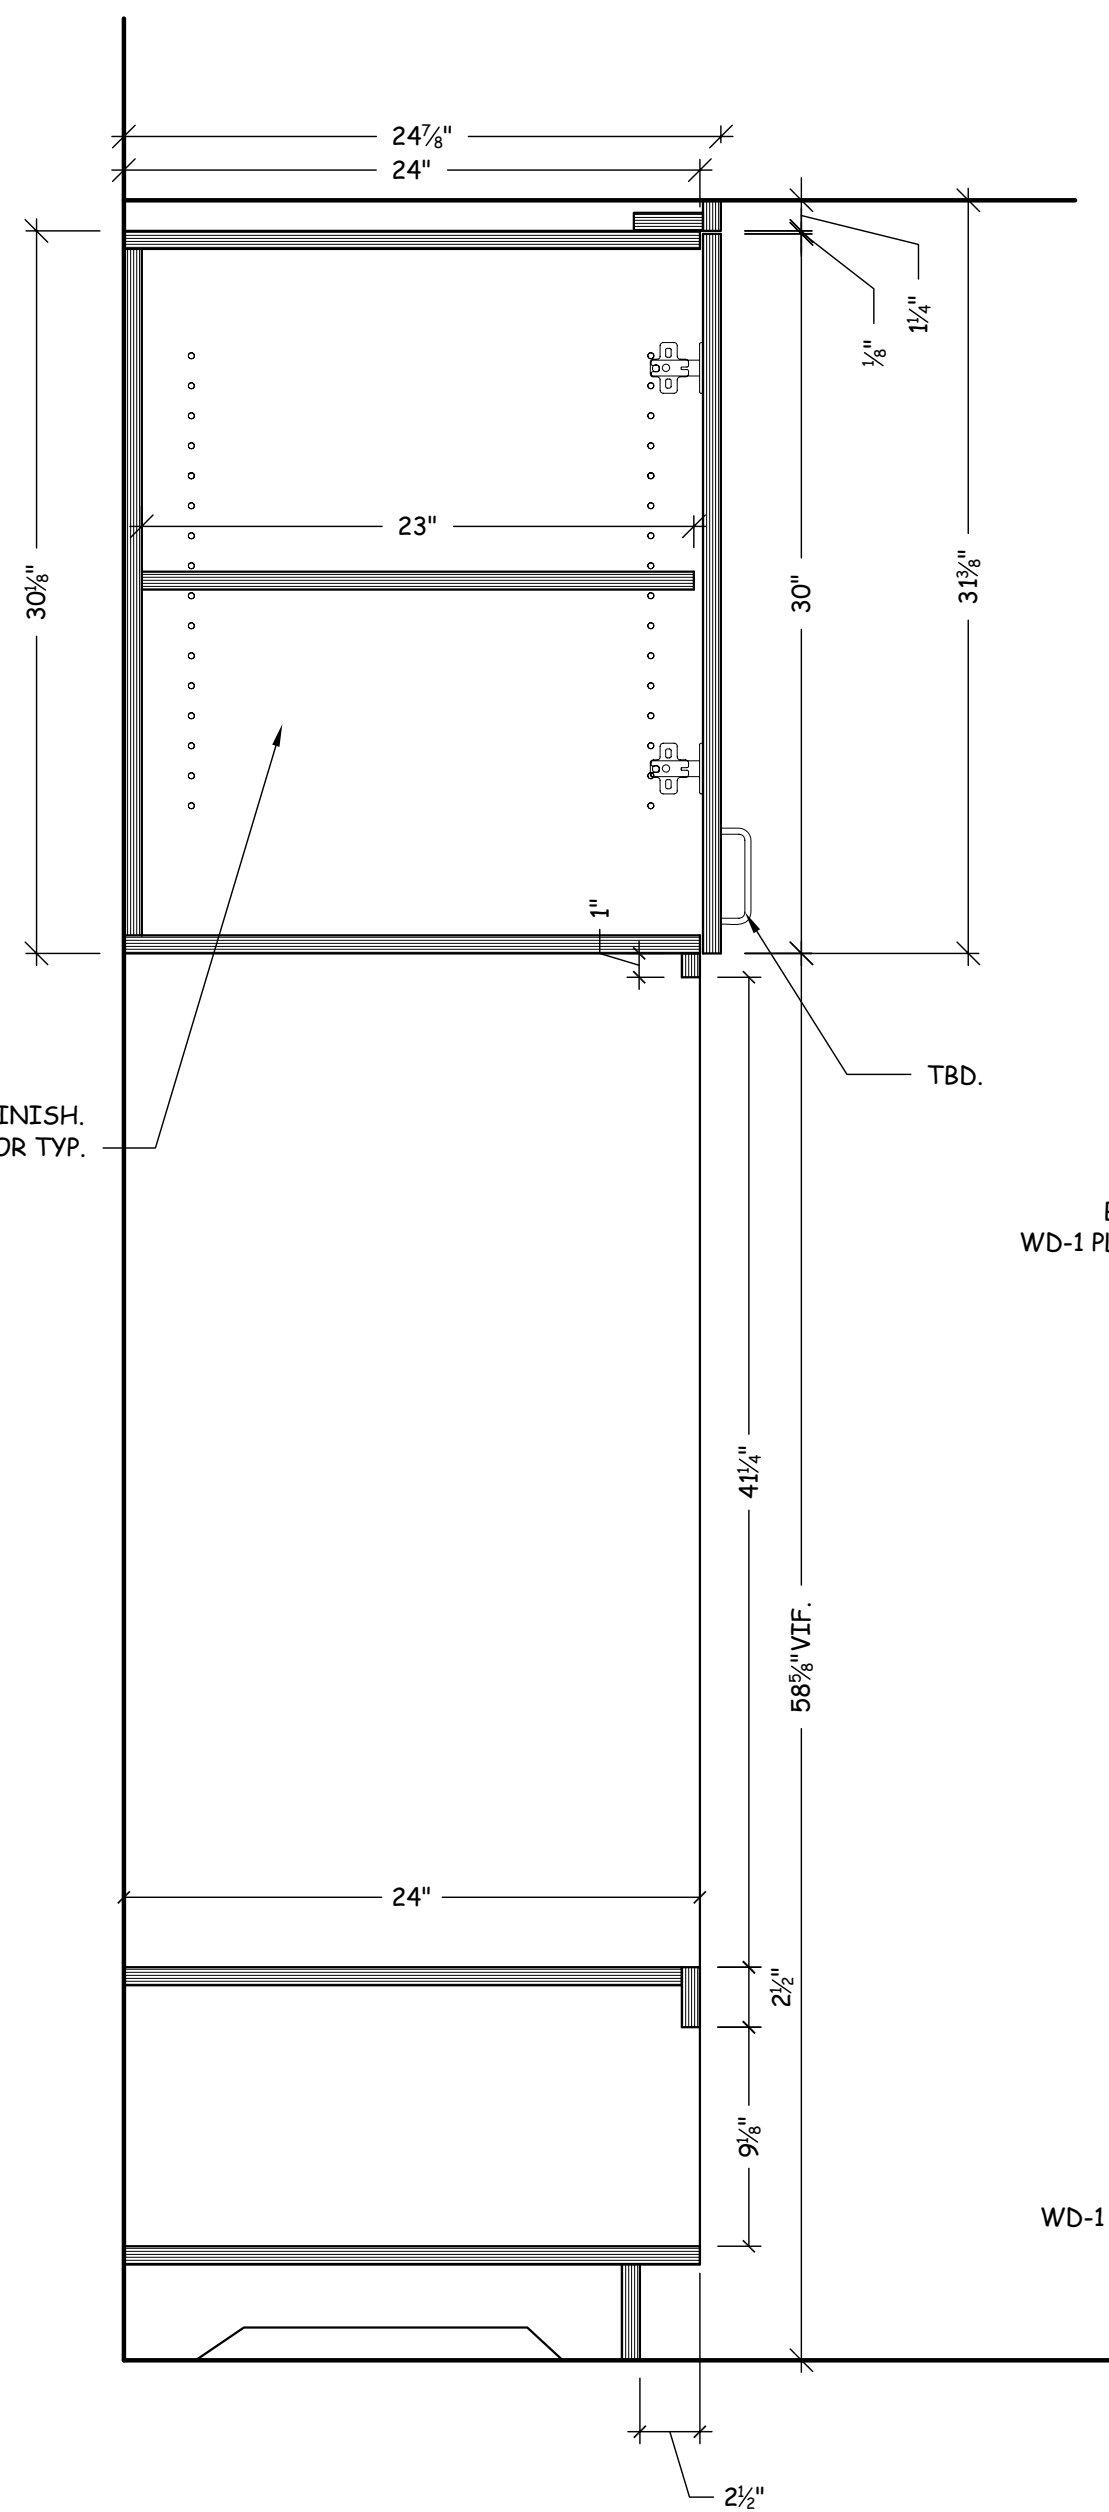


S.6 SECTION@KITCHEN (OVEN/ MICRO)
 SCALE: 1 1/2" = 1'-0"

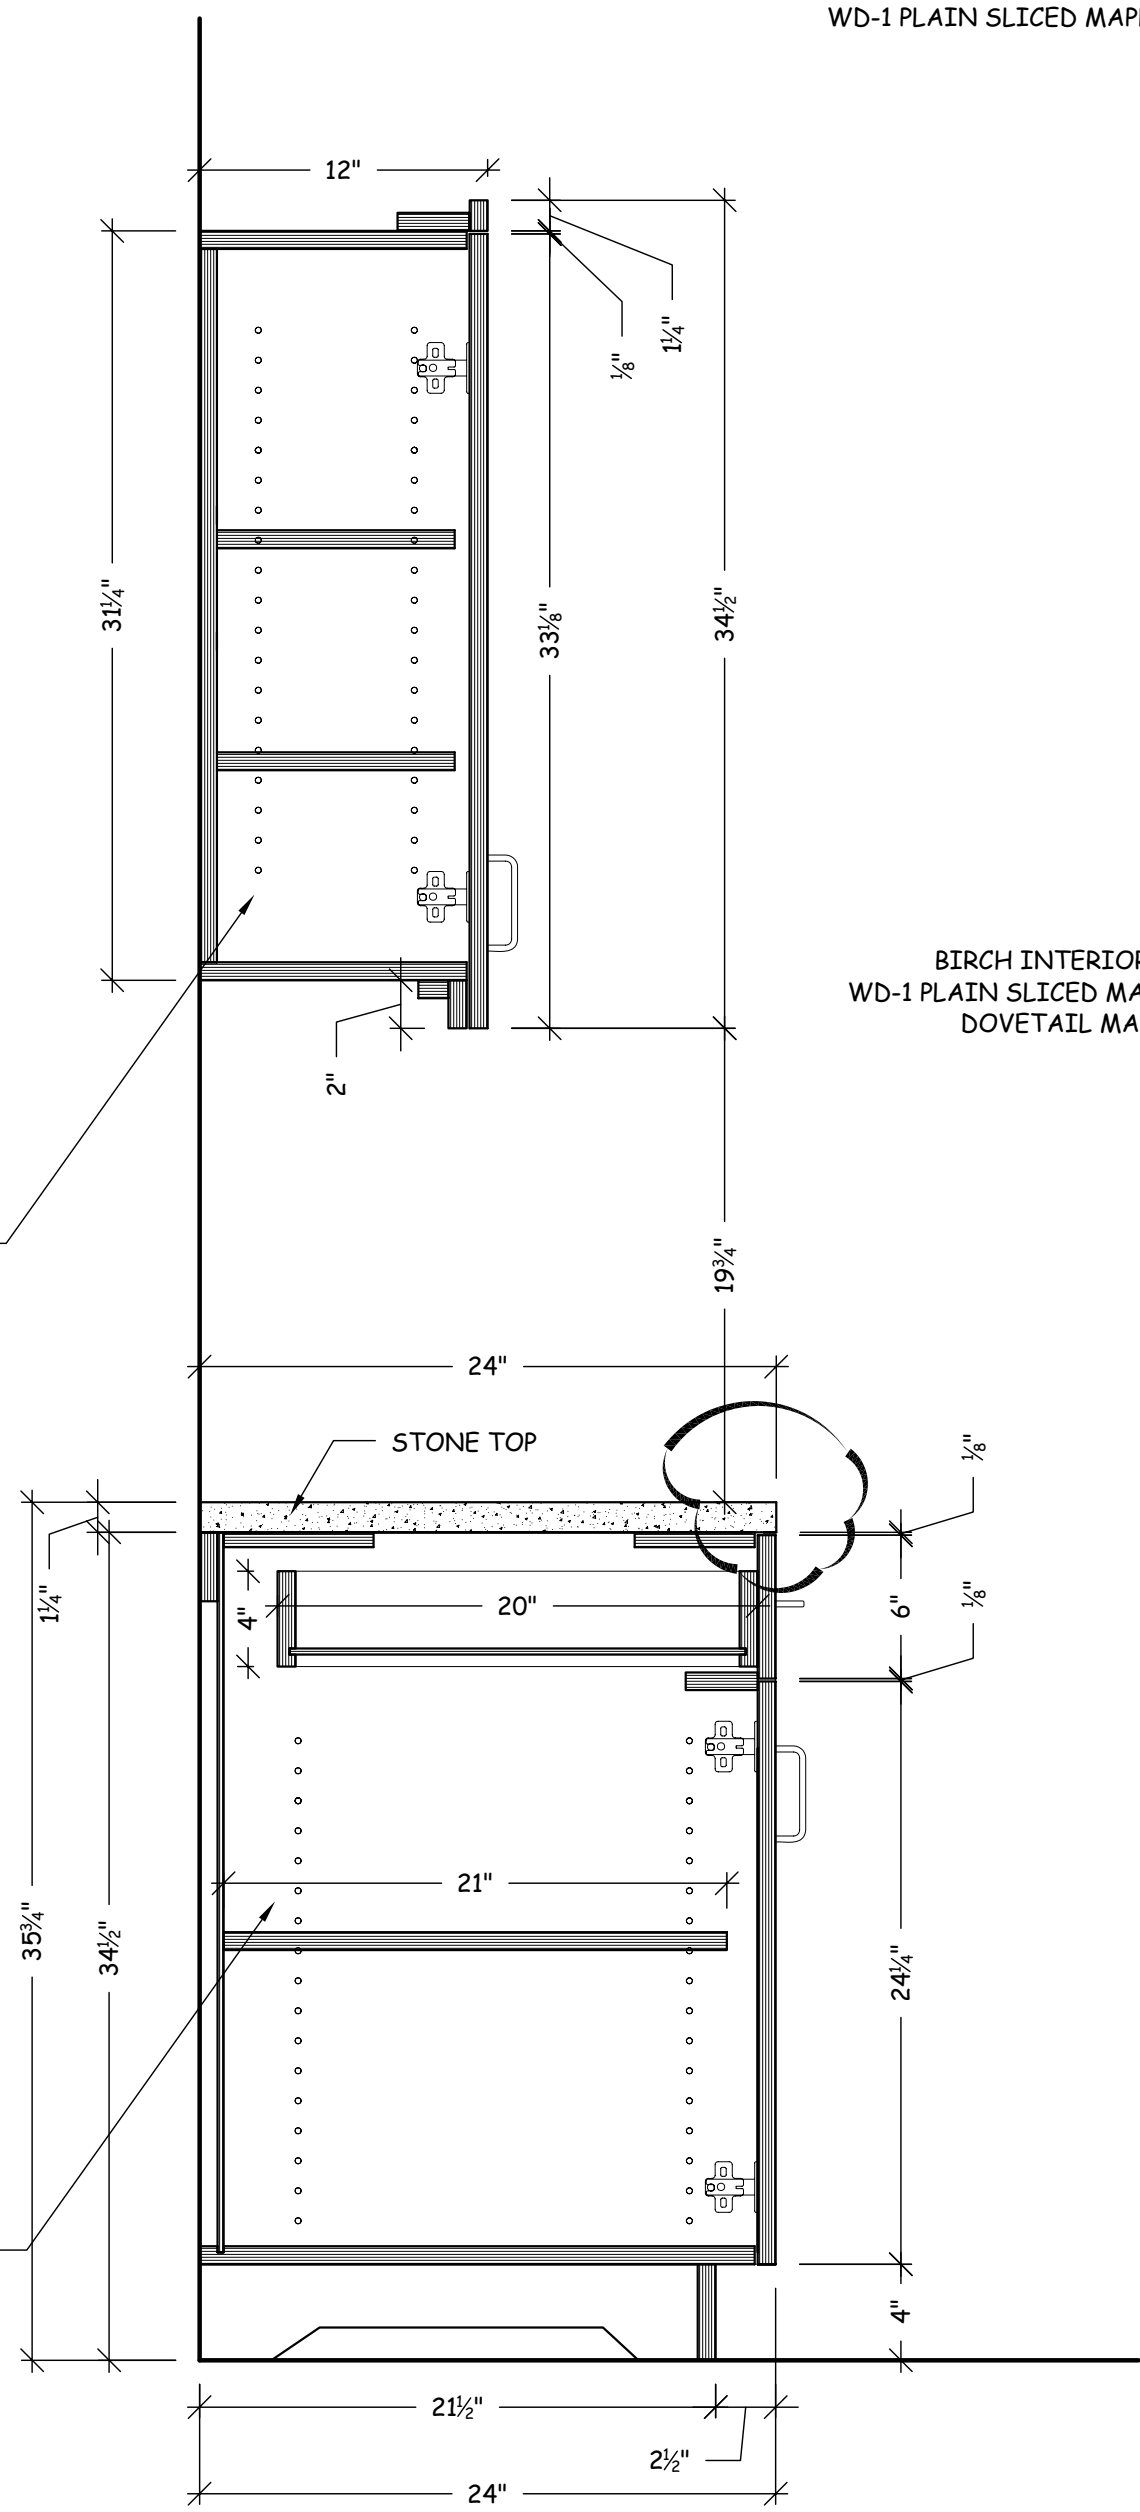


S.7 SECTION (KITCHEN)
 SCALE: 1 1/2" = 1'-0"

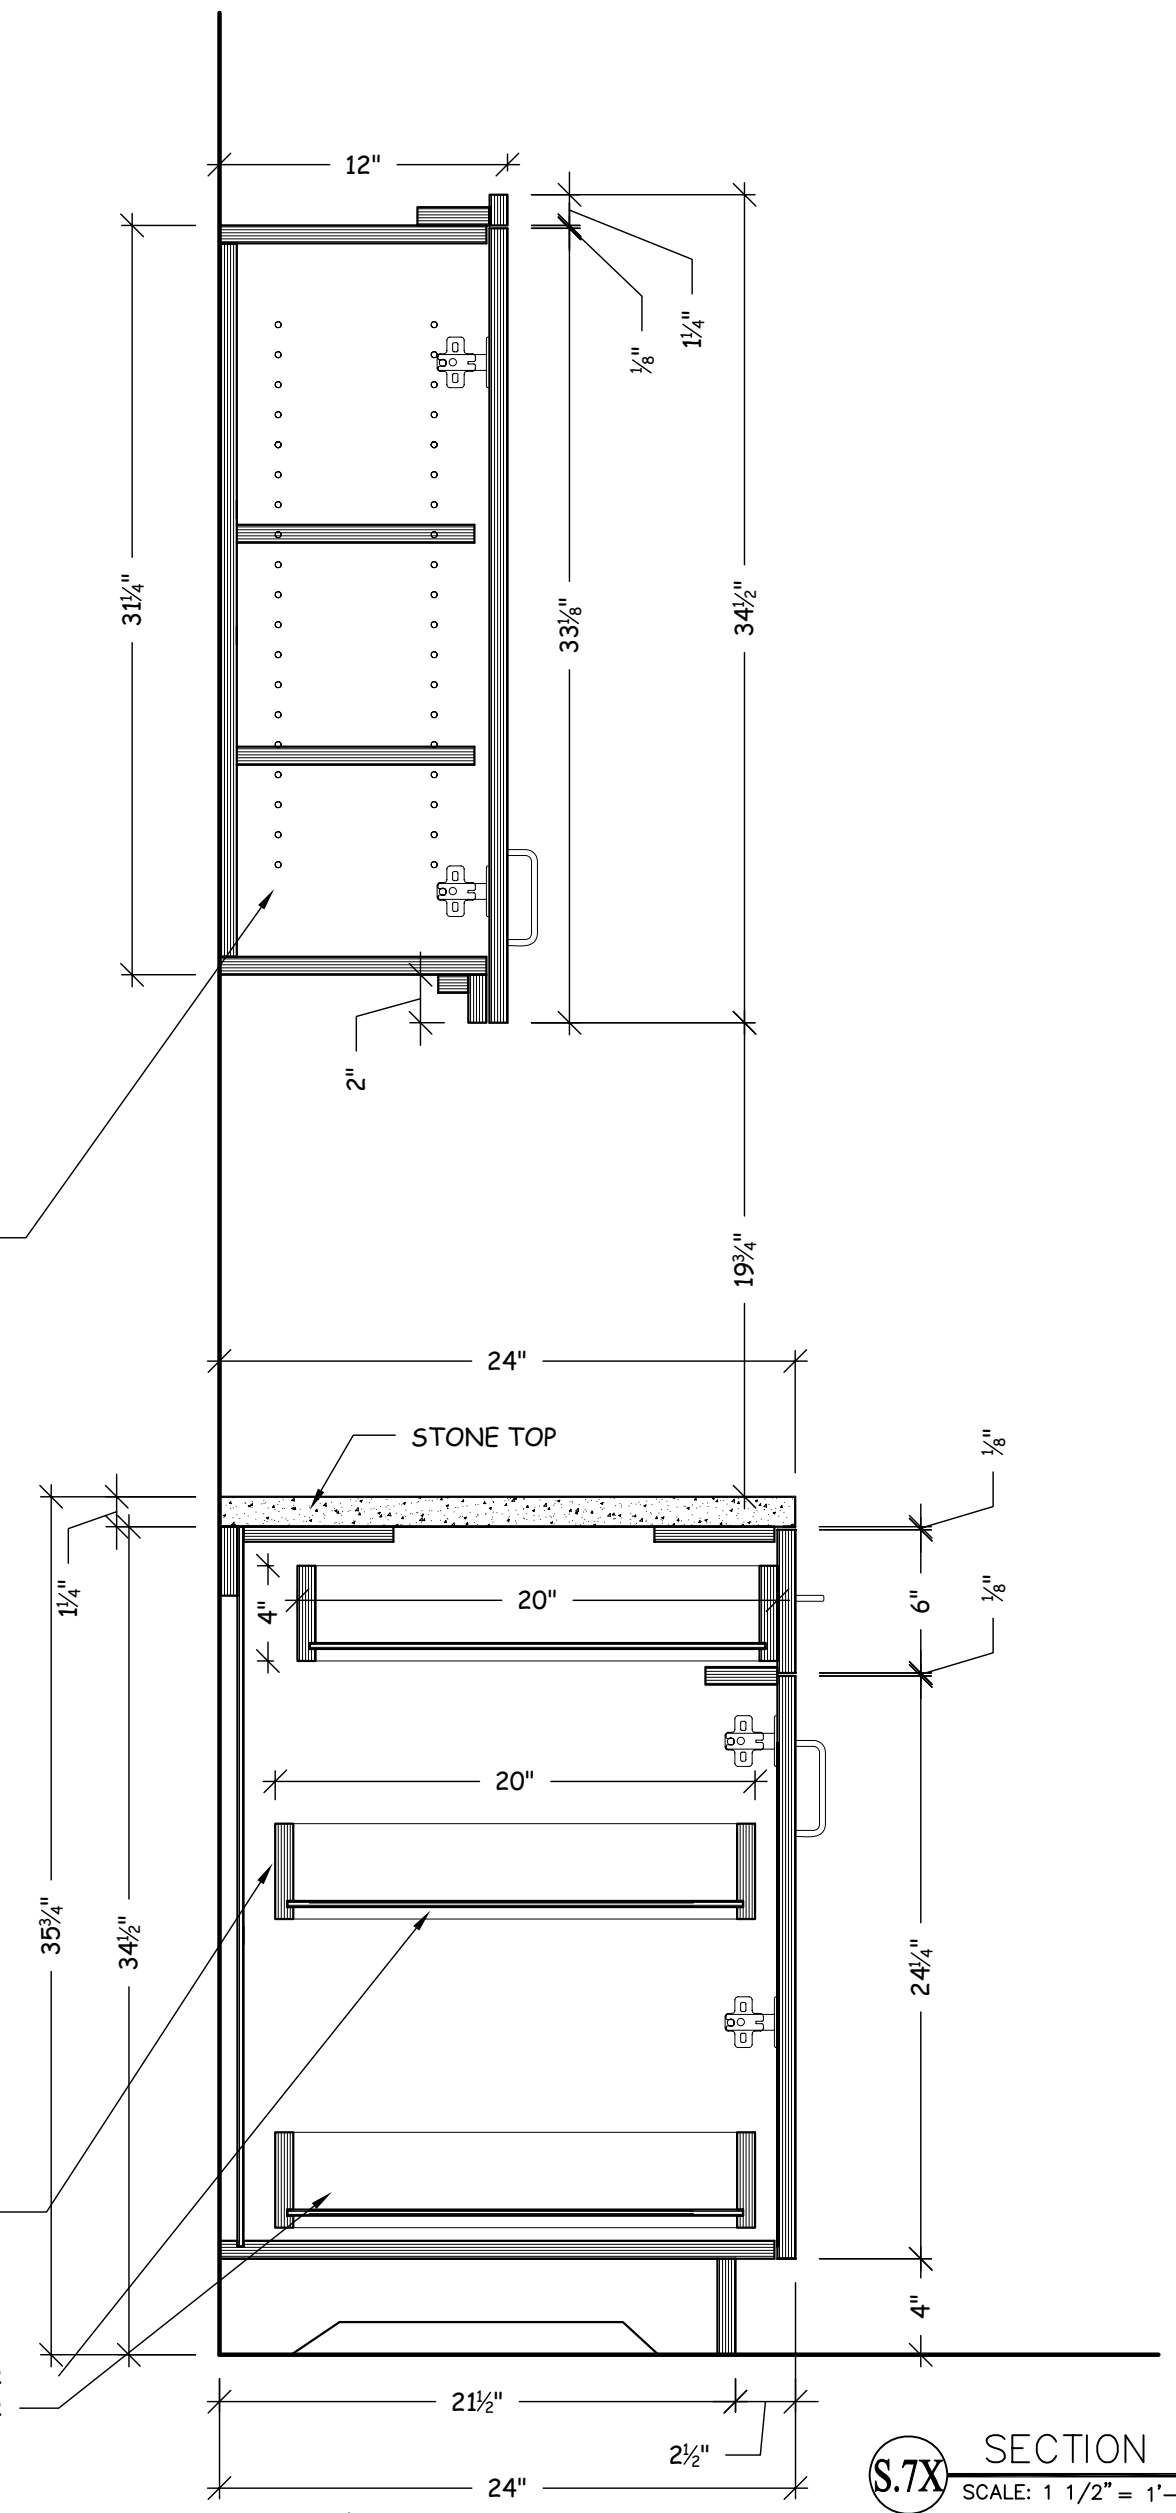


S.7X SECTION (DUMB WAITER)
 SCALE: 1 1/2" = 1'-0"

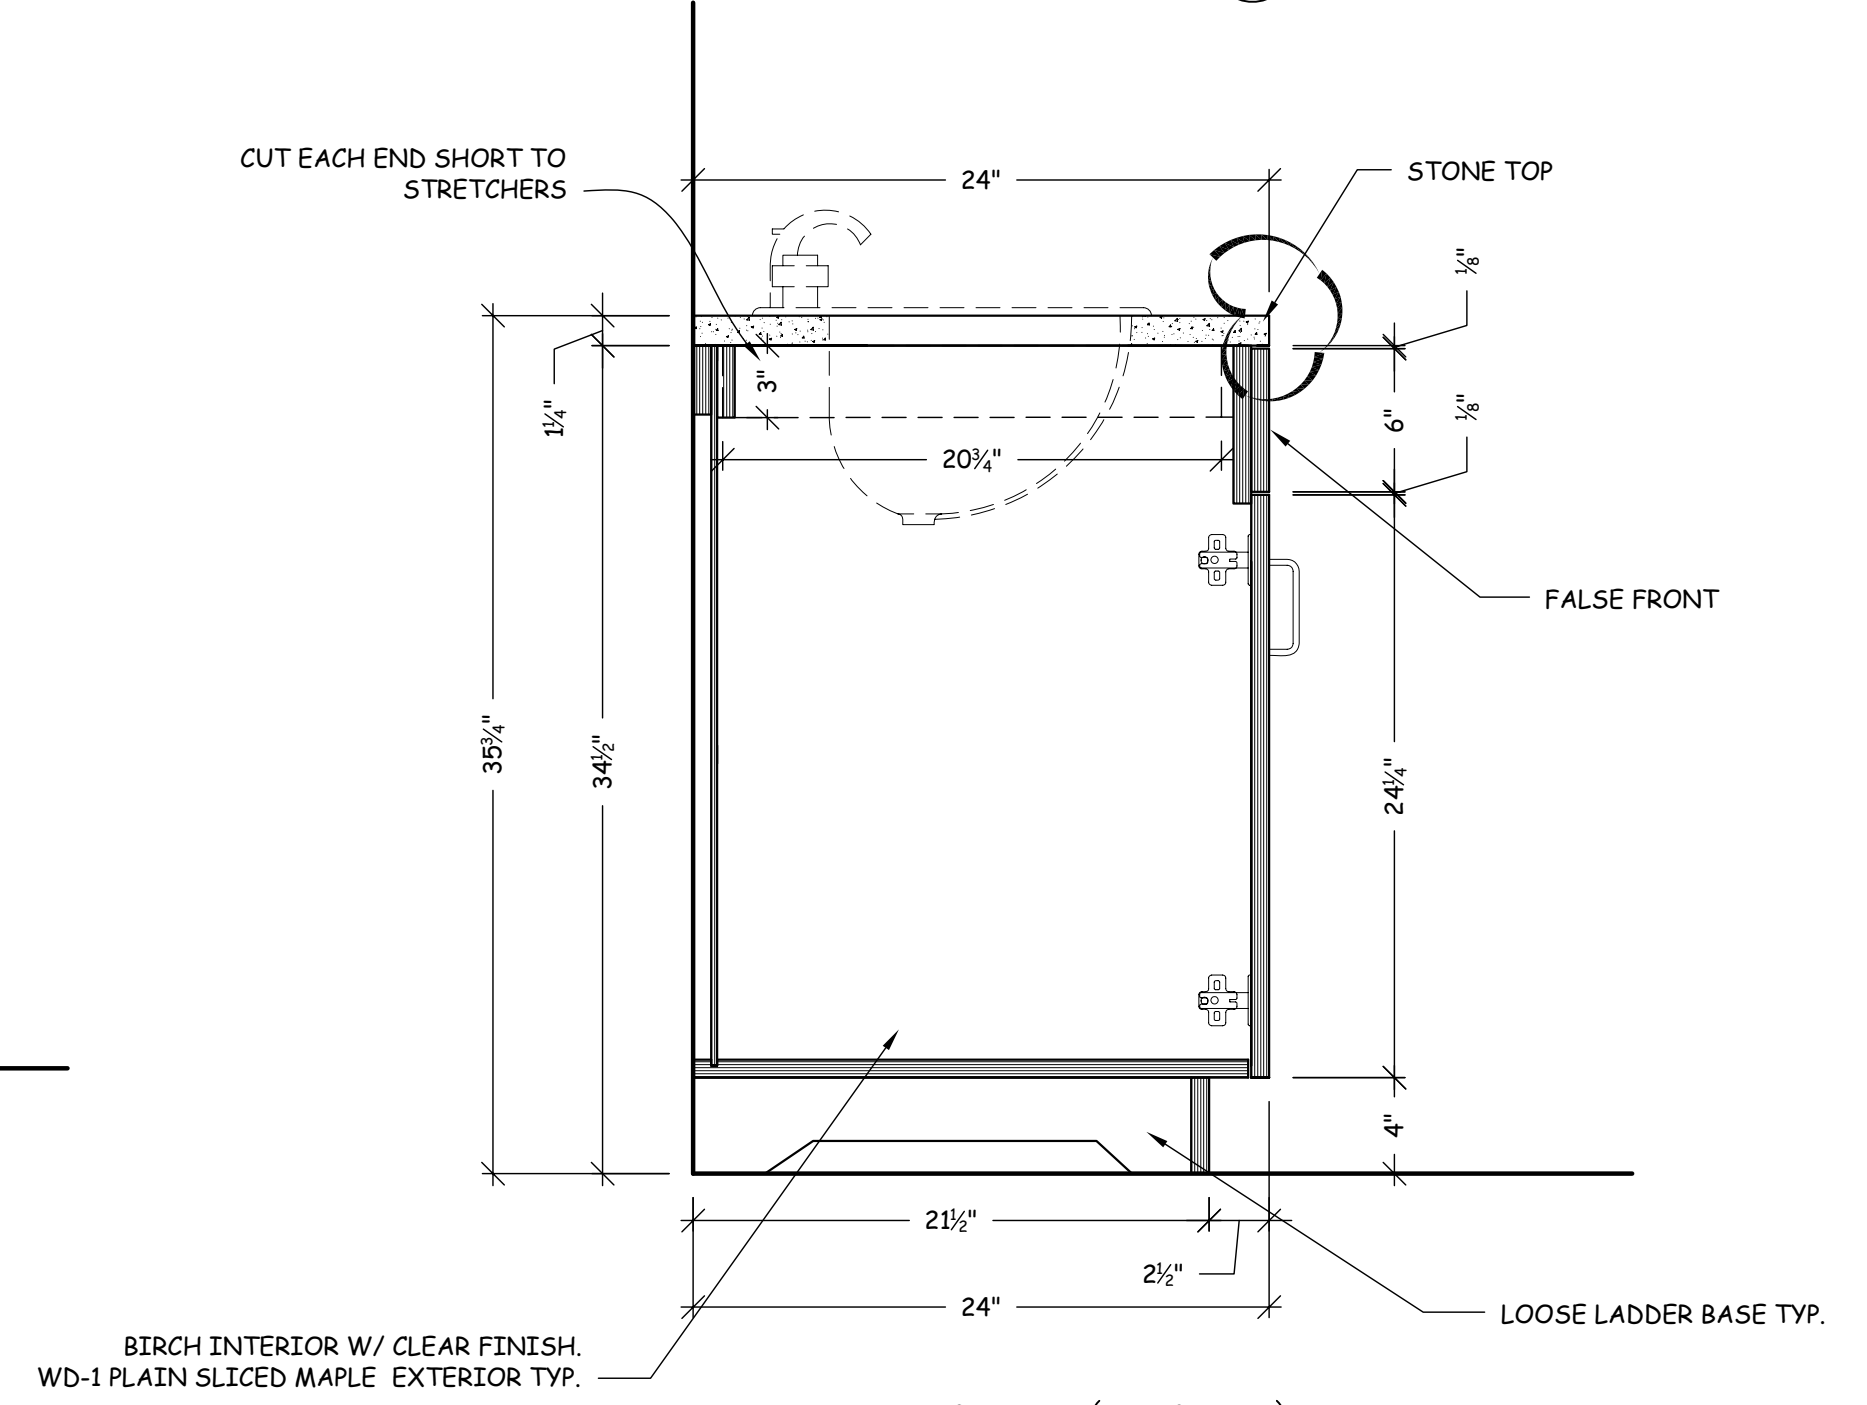


S.8 SECTION (KITCHEN)
 SCALE: 1 1/2" = 1'-0"

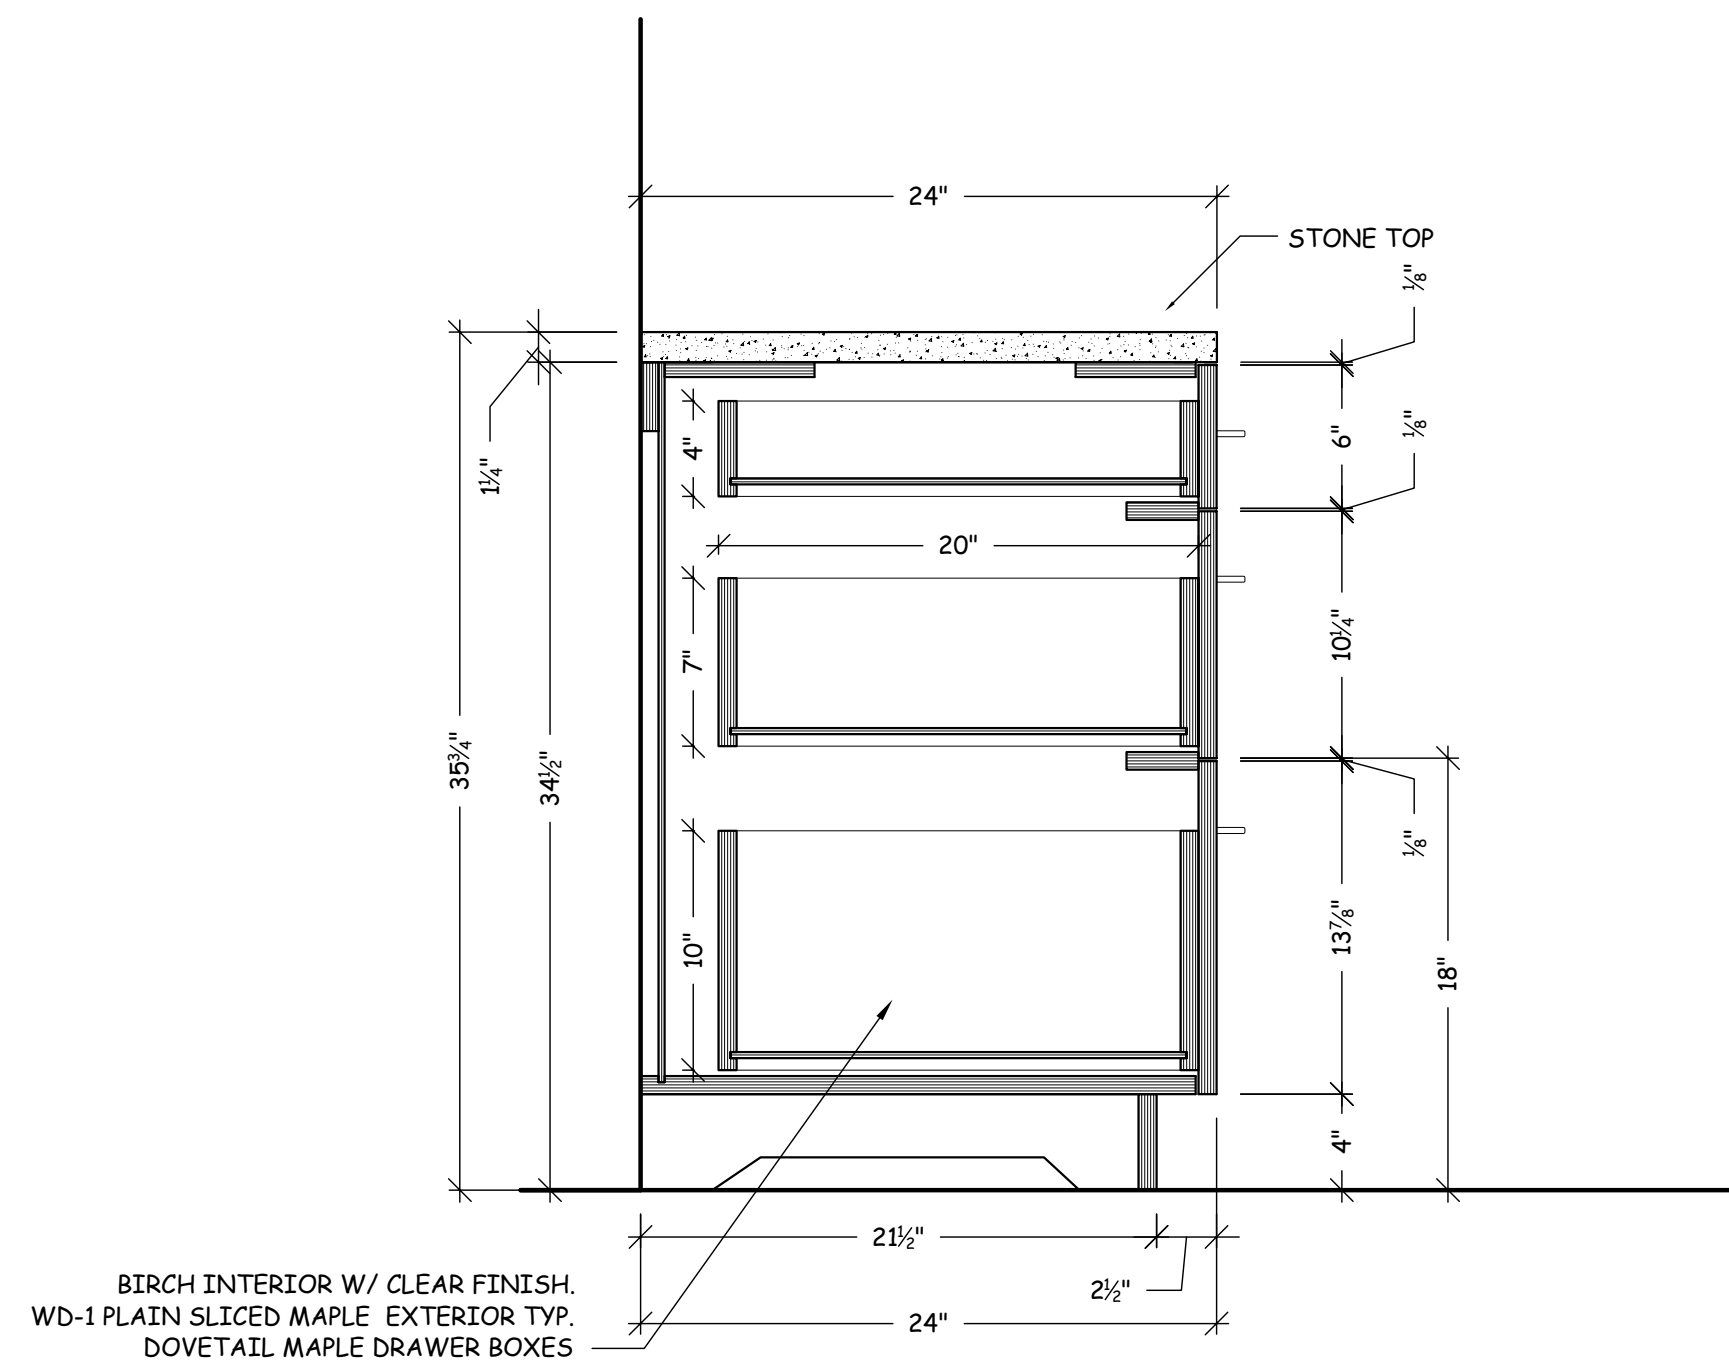


S.9 SECTION (KITCHEN)
SCALE: 1 1/2" = 1'-0"

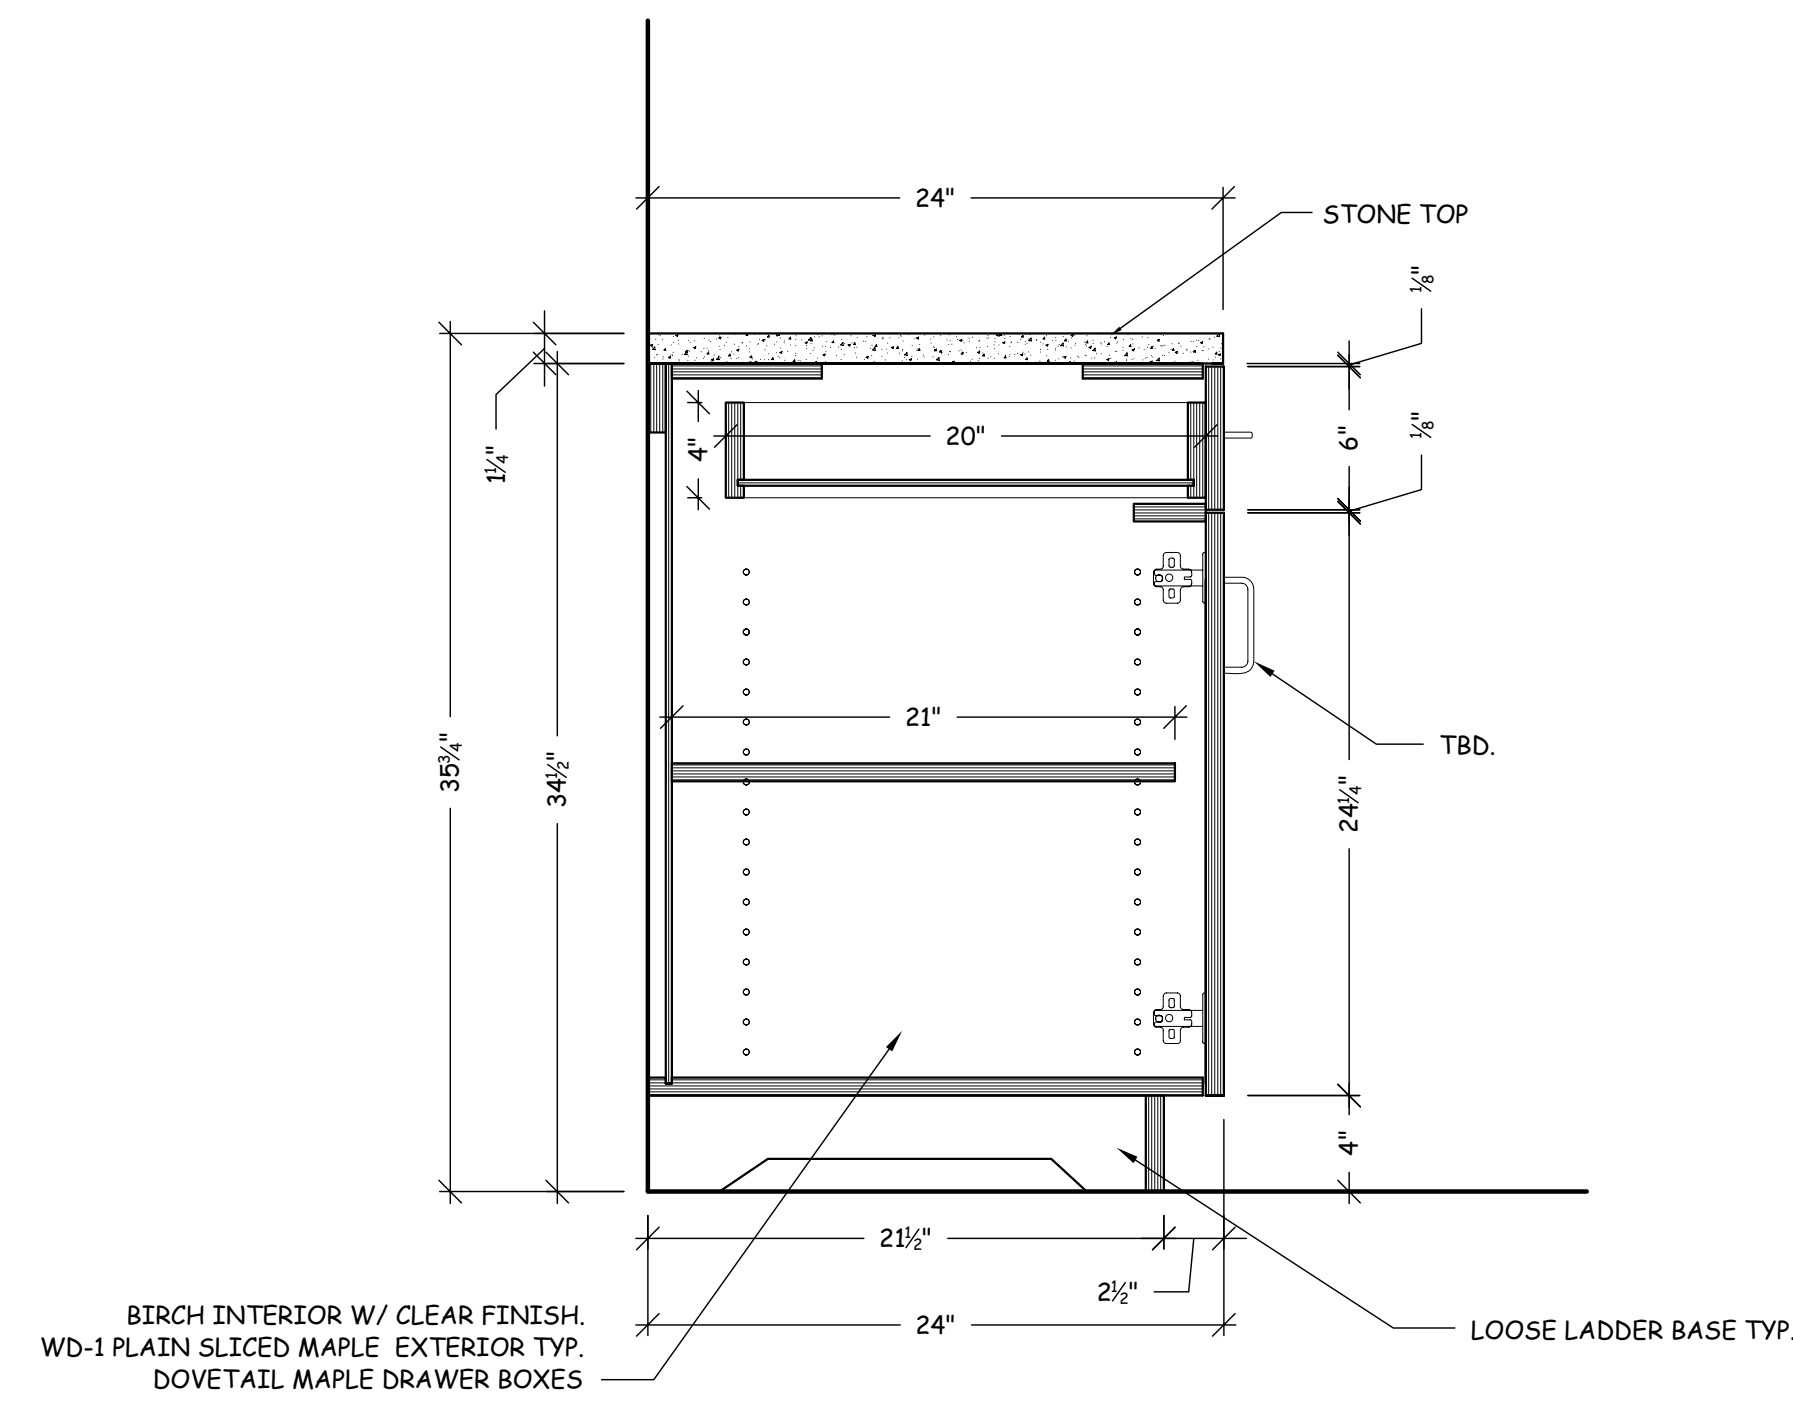

S.10 SECTION (KITCHEN)
SCALE: 1 1/2" = 1'-0"

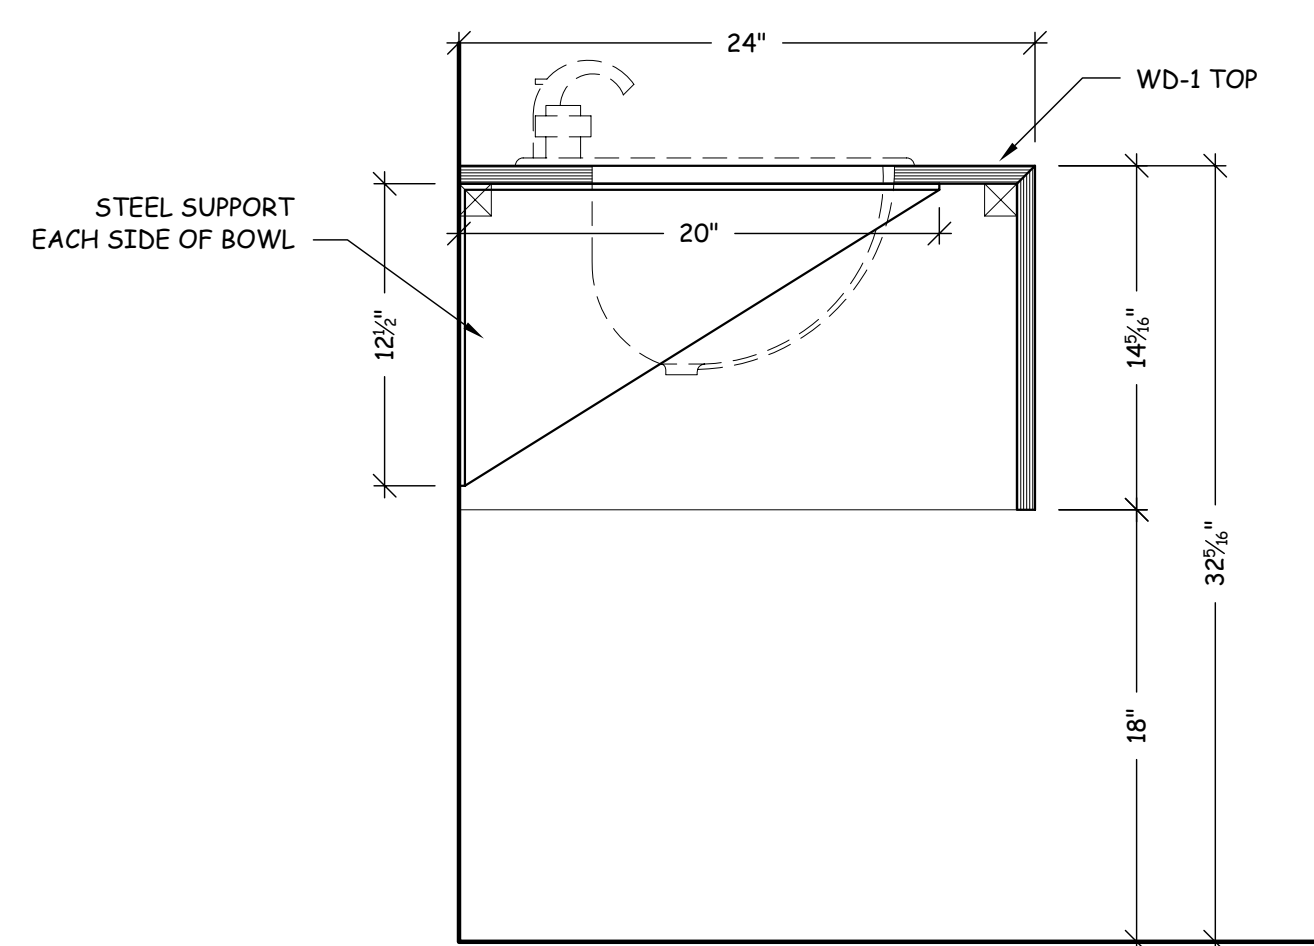

S.12 SECTION-BATH #3
SCALE: 1 1/2" = 1'-0"

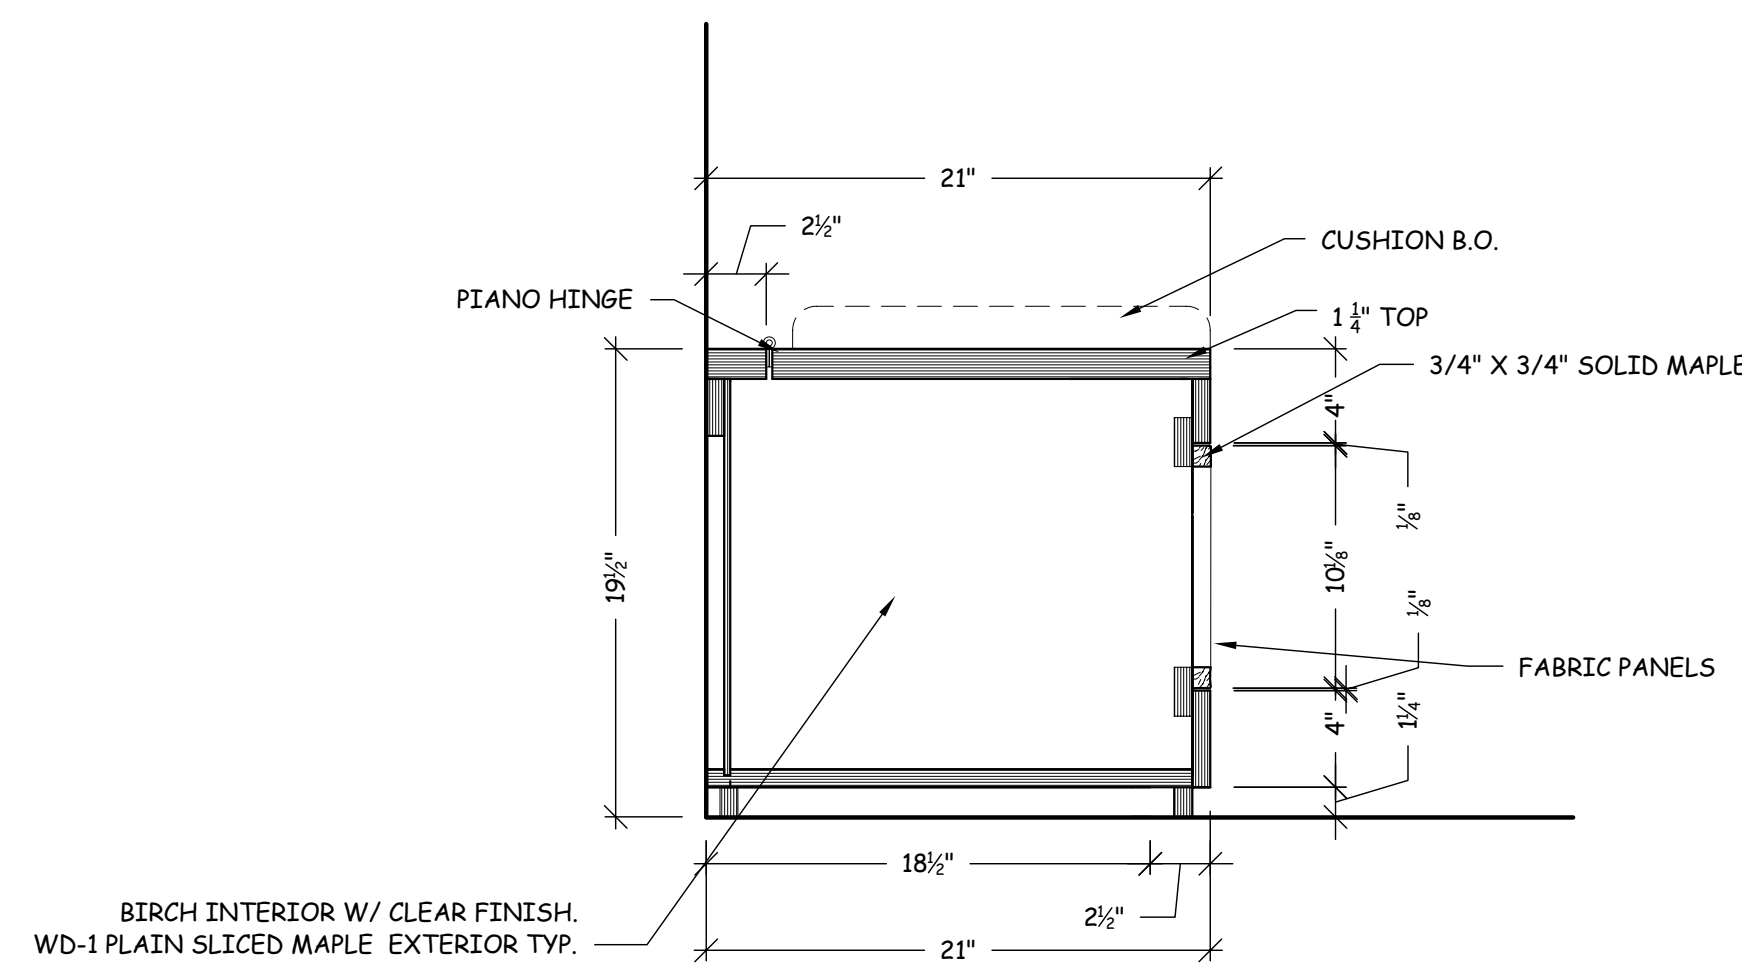

S.11 SECTION-BENCH SEAT @ KITCHEN
SCALE: 1 1/2" = 1'-0"

General Notes

SHOP NOTES:

N&N Architectural Drafting Service
Computer Aided Design & Drafting/ CNC Programming

LEGEND:
VIEW
SHEET NO.
DIRECTION OF VIEW

Drawn by Neno K.

No.	Revision/Issue	Date
-	FIELD UPDATES	2-05
1	MARKUP PER OWNER/ARCH.	2-27

DRAWING RECORD

ARCHITECT:


CONTRACTOR:

Project Name and Address:


Project: SECTIONS Sheet:

Date: 1-29-07 S-3


JOB # : *

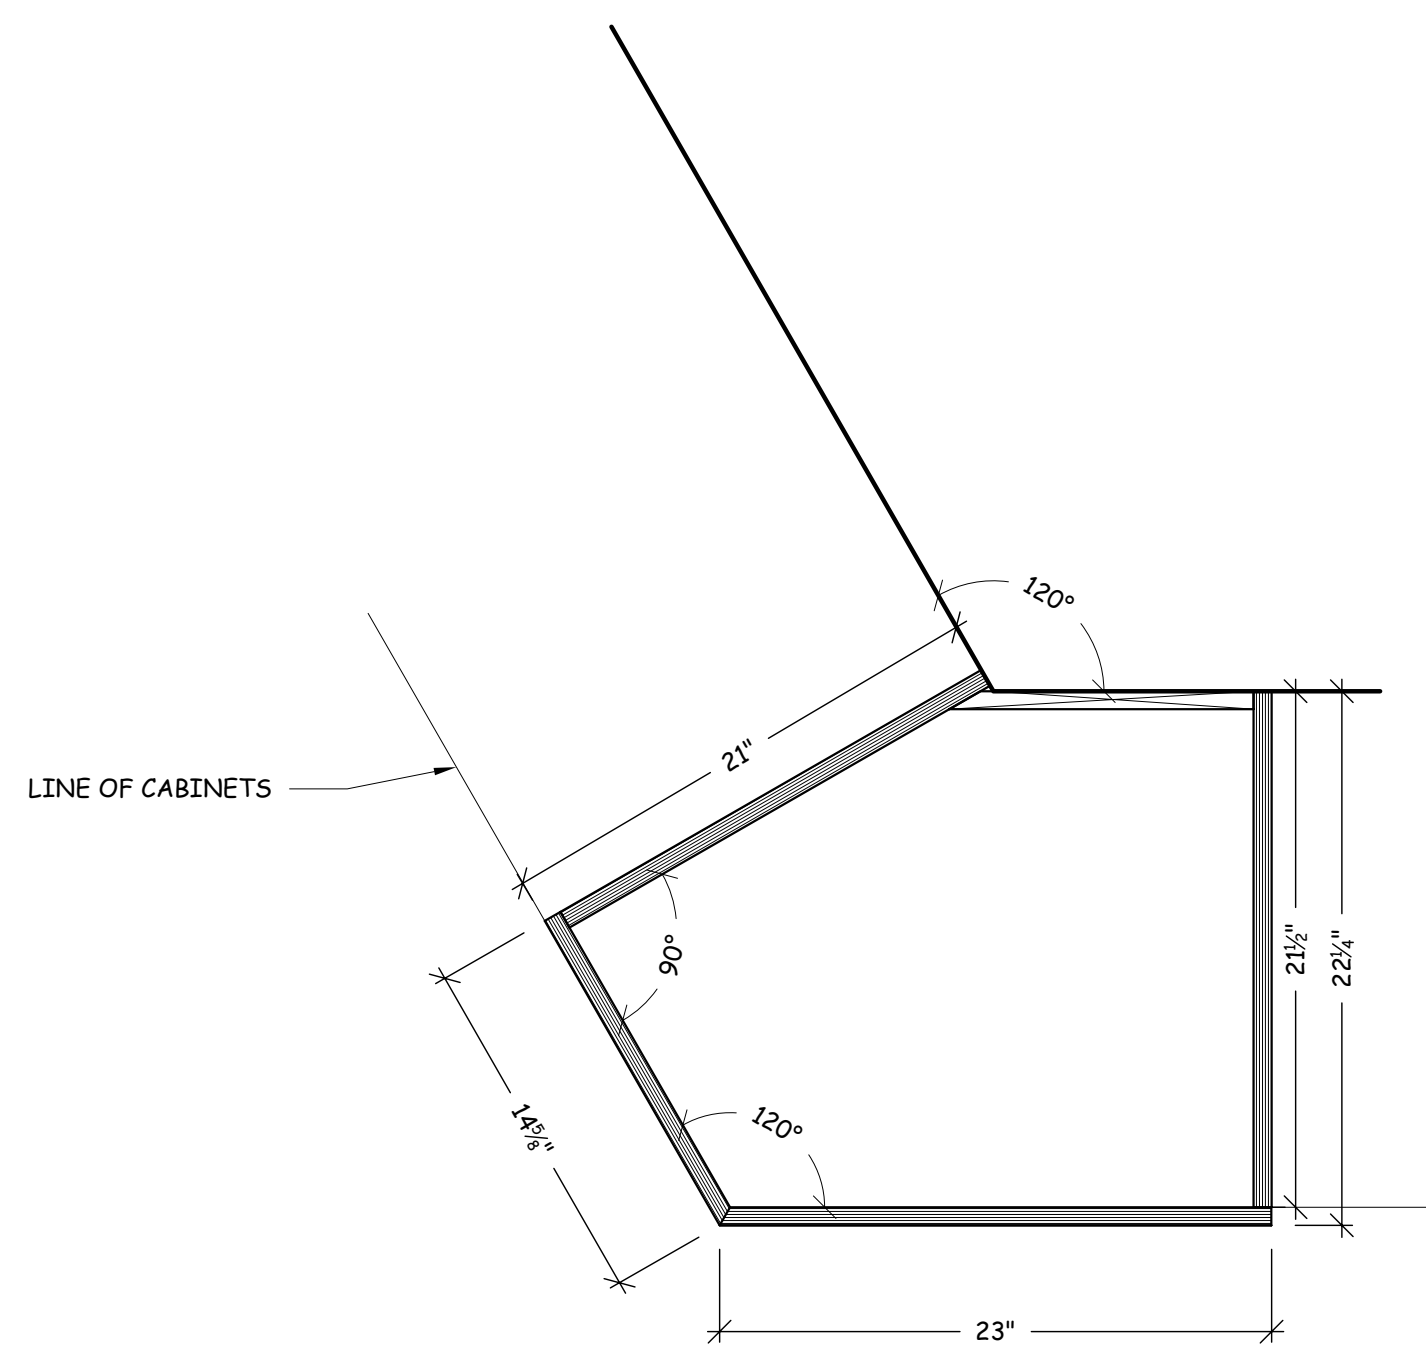

S.15X SECTION
SCALE: 1 1/2" = 1'-0"

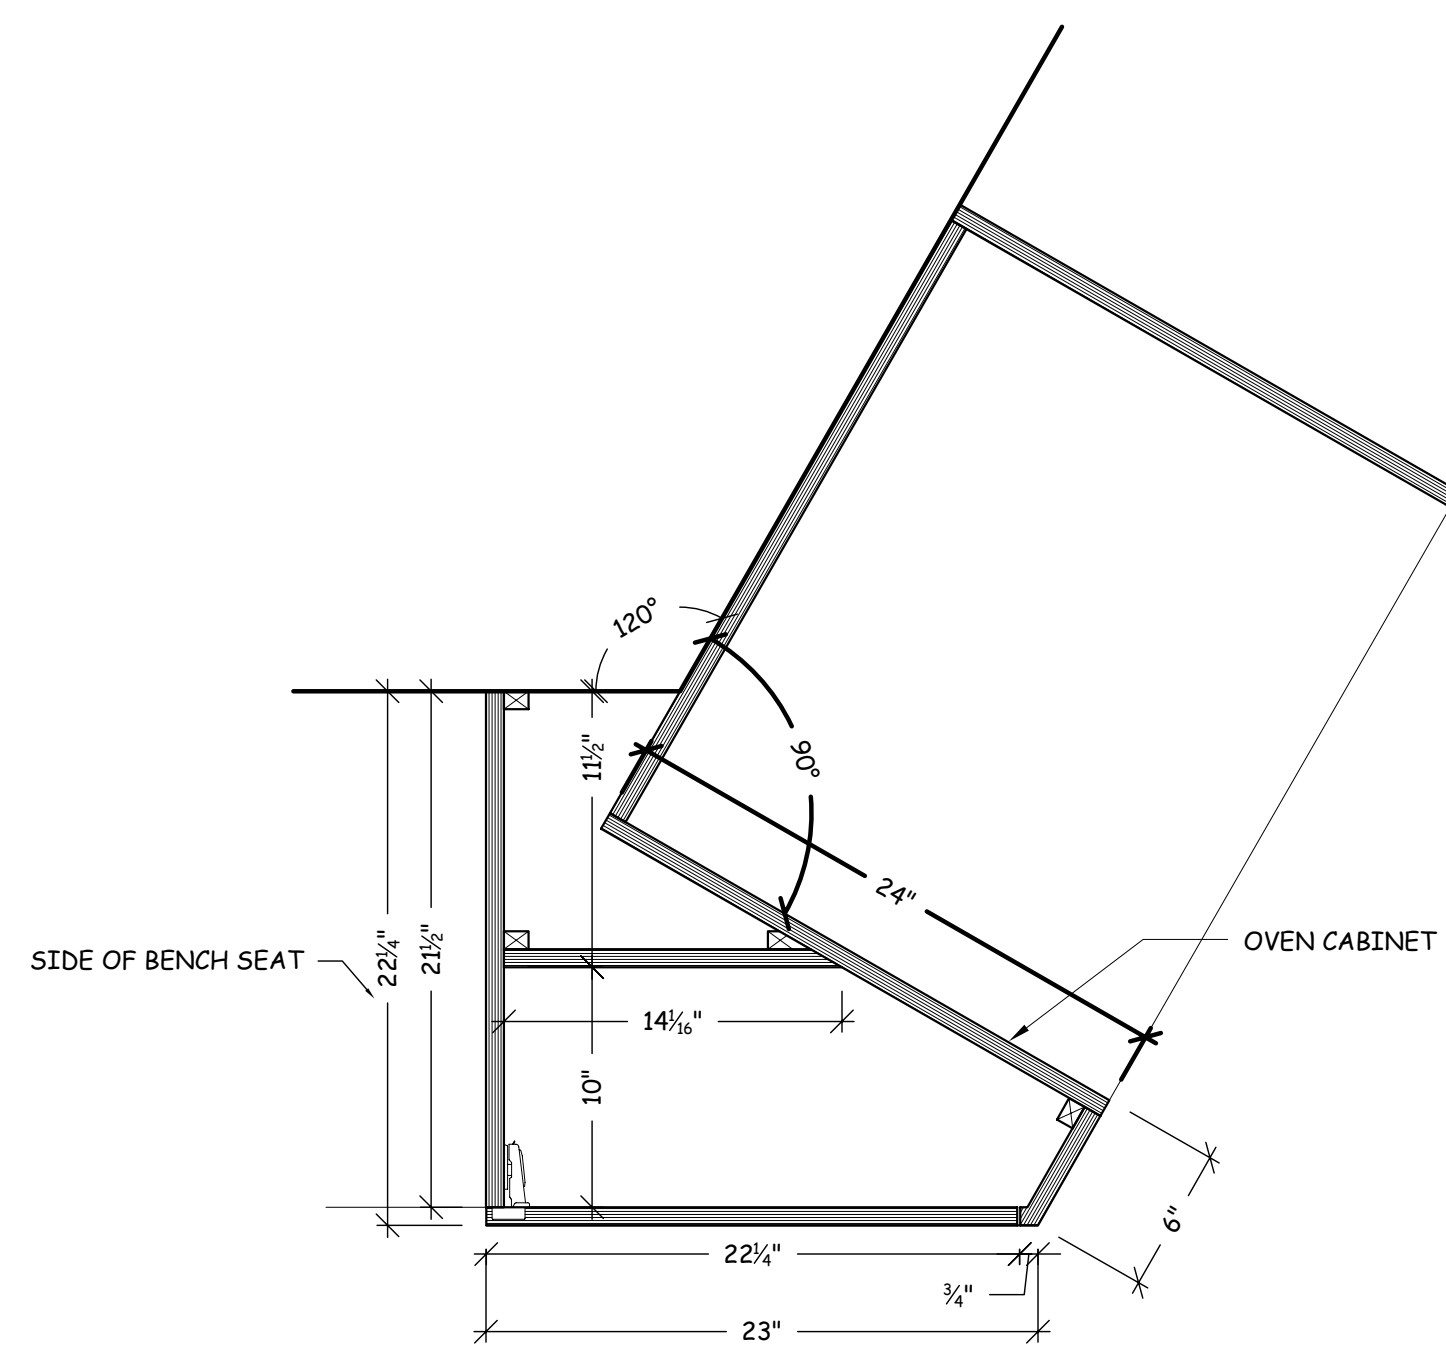

S.15 SECTION
SCALE: 1 1/2" = 1'-0"

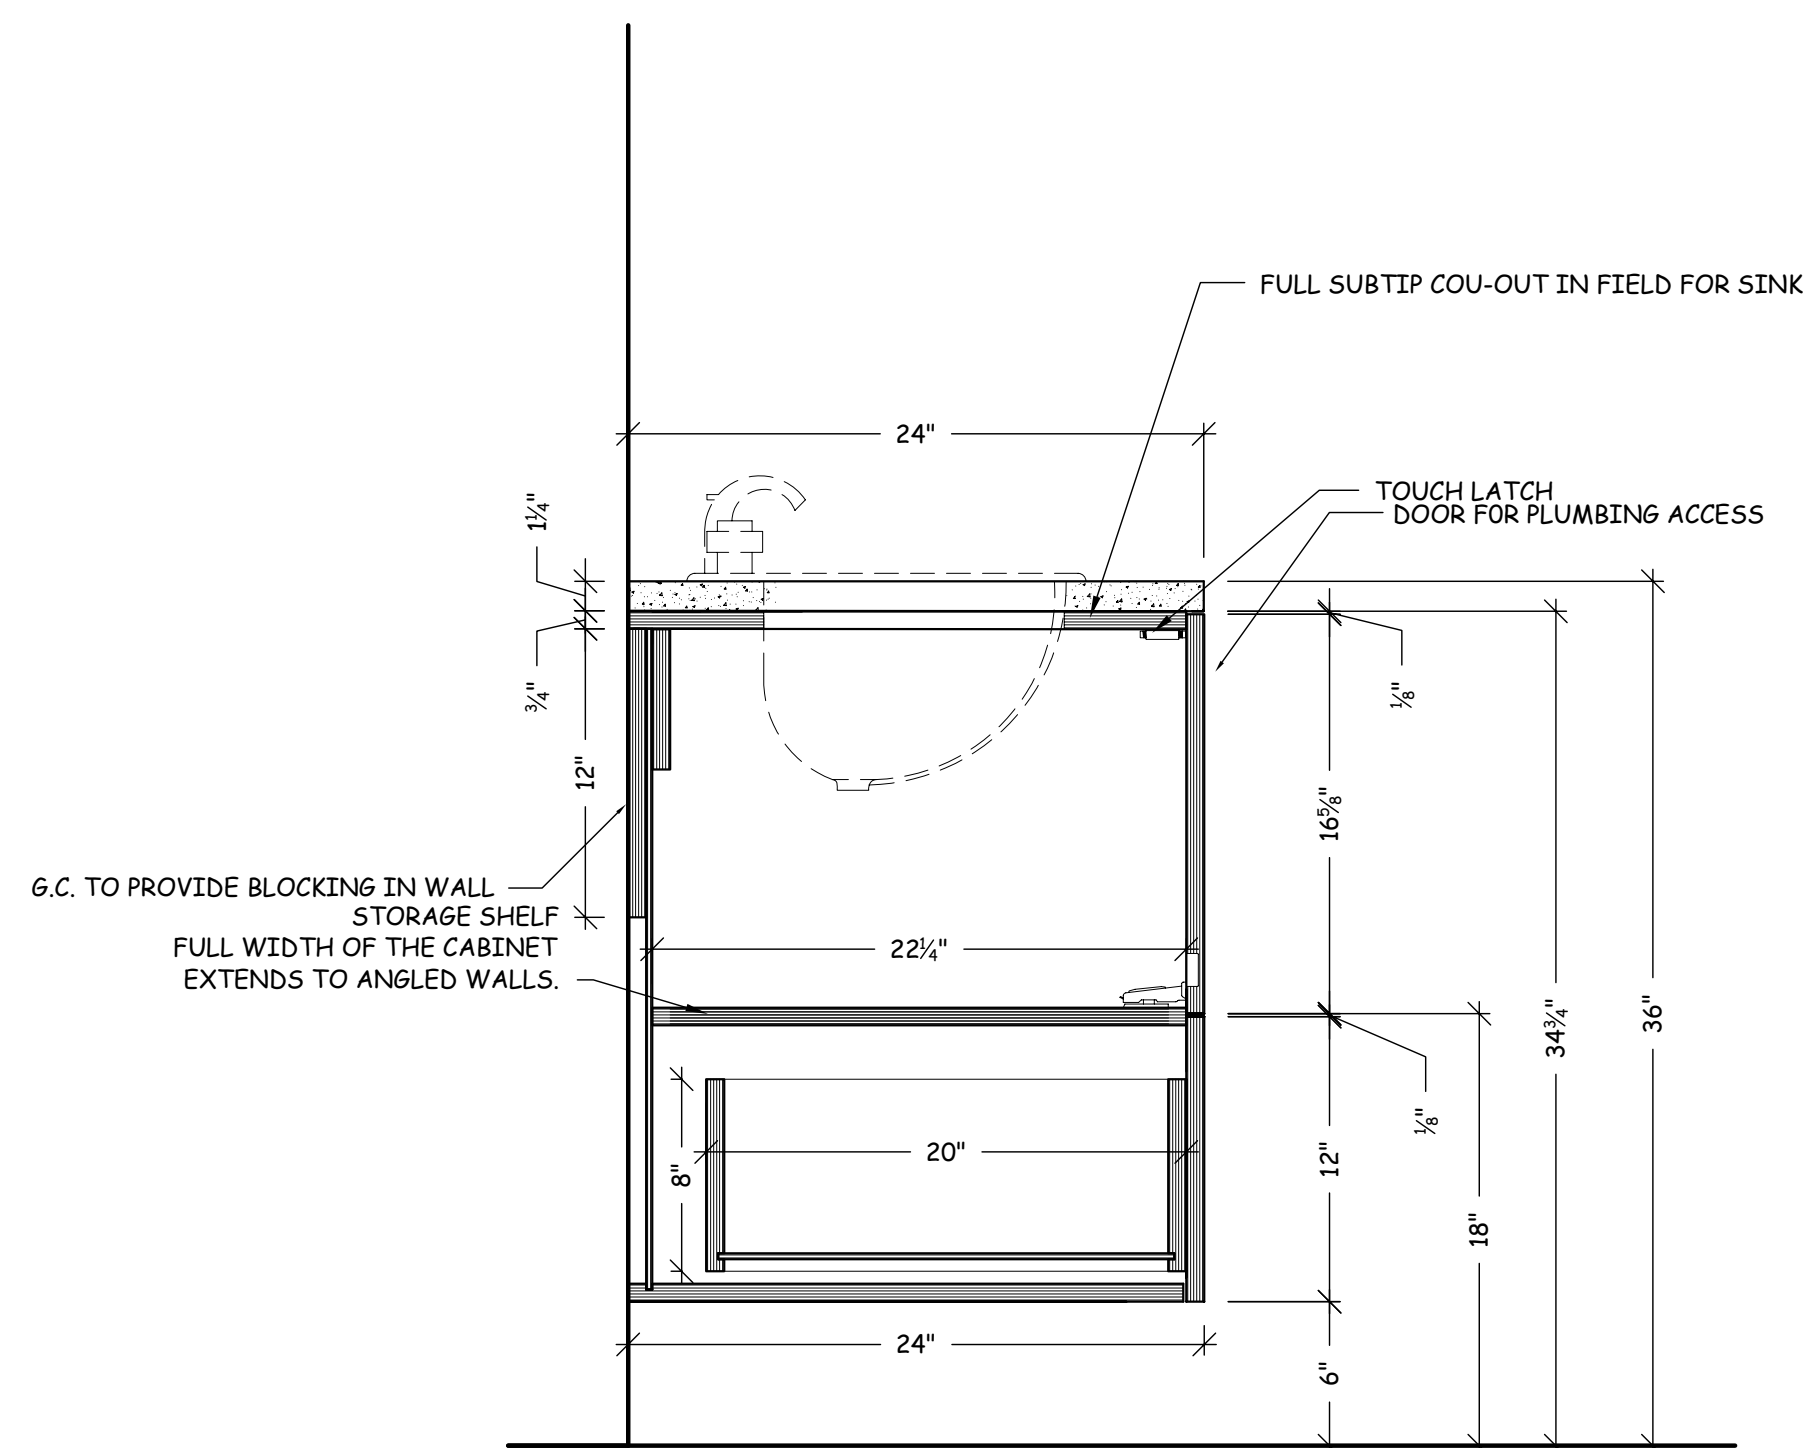

S.14 SECTION
SCALE: 1 1/2" = 1'-0"

General Notes

SHOP NOTES:

N&N Architectural Drafting Service
Computer Aided Design & Drafting/ CNC Programming

LEGEND:

 VIEW
 SHEET NO.
 DIRECTION OF VIEW


Drawn by Neno K.

No.	Revision/Issue	Date
1	MARKUP PER OWNER/ARCH.	2-27


DRAWING RECORD

ARCHITECT:
 CONTRACTOR:
 Project Name and Address:


Project:	SECTIONS	Sheet:	S-4
Date:	2-05-07		
JOB # :	*		

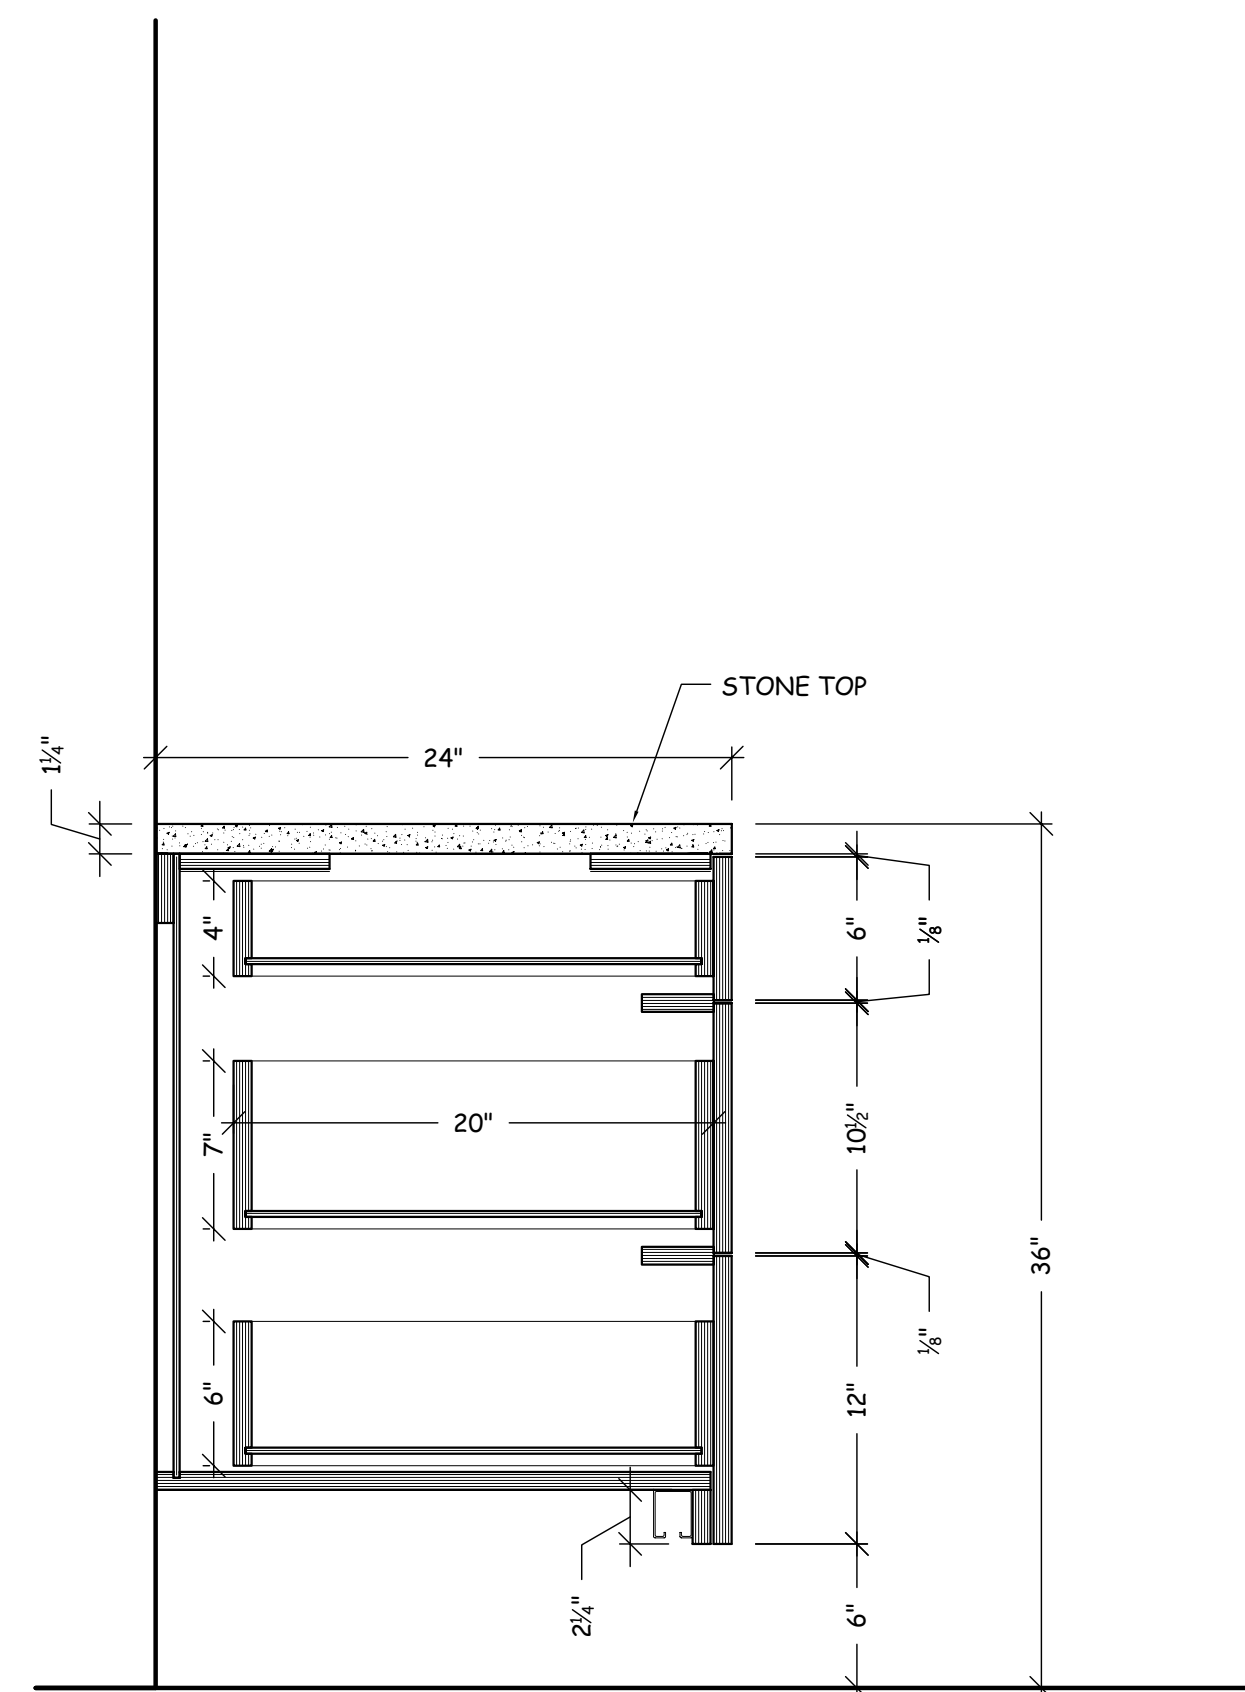

S.16 SECTION
SCALE: 1 1/2" = 1'-0"

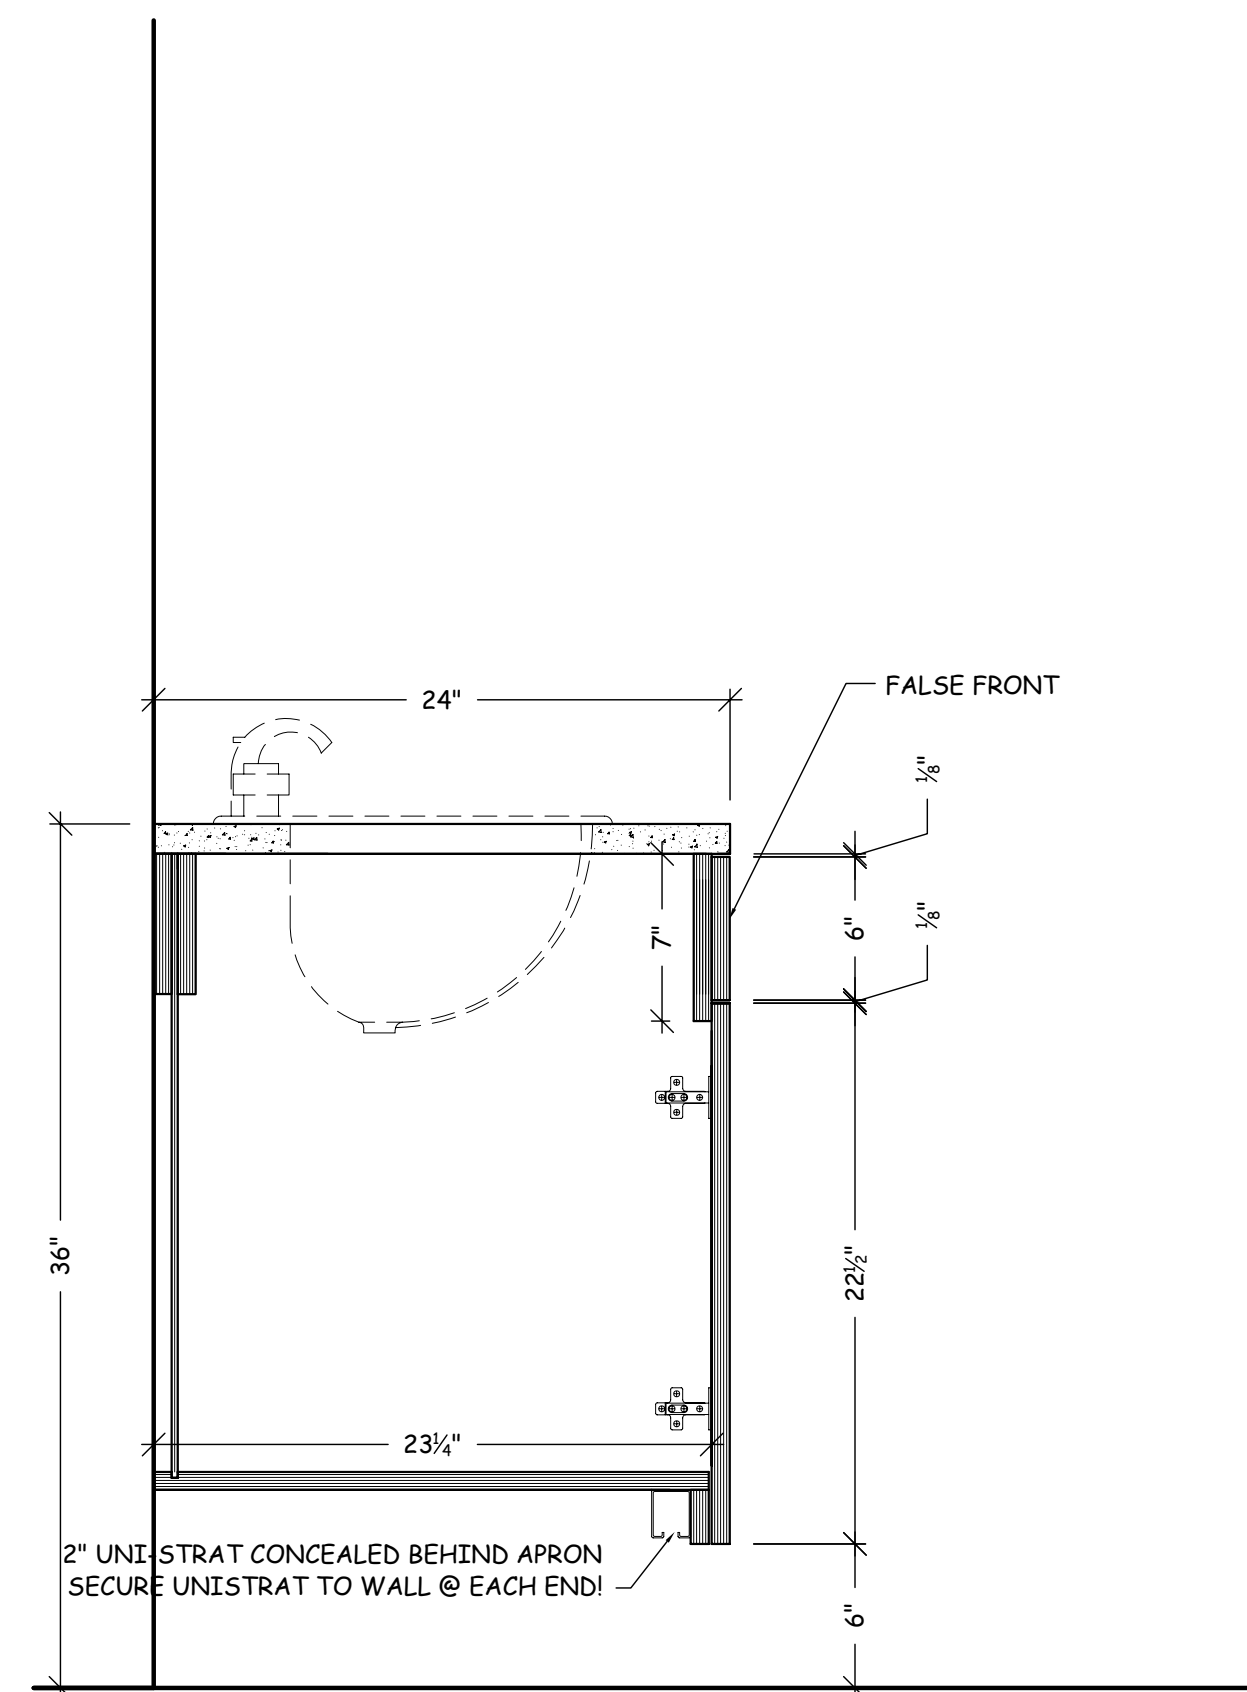

S.17 SECTION
SCALE: 1 1/2" = 1'-0"

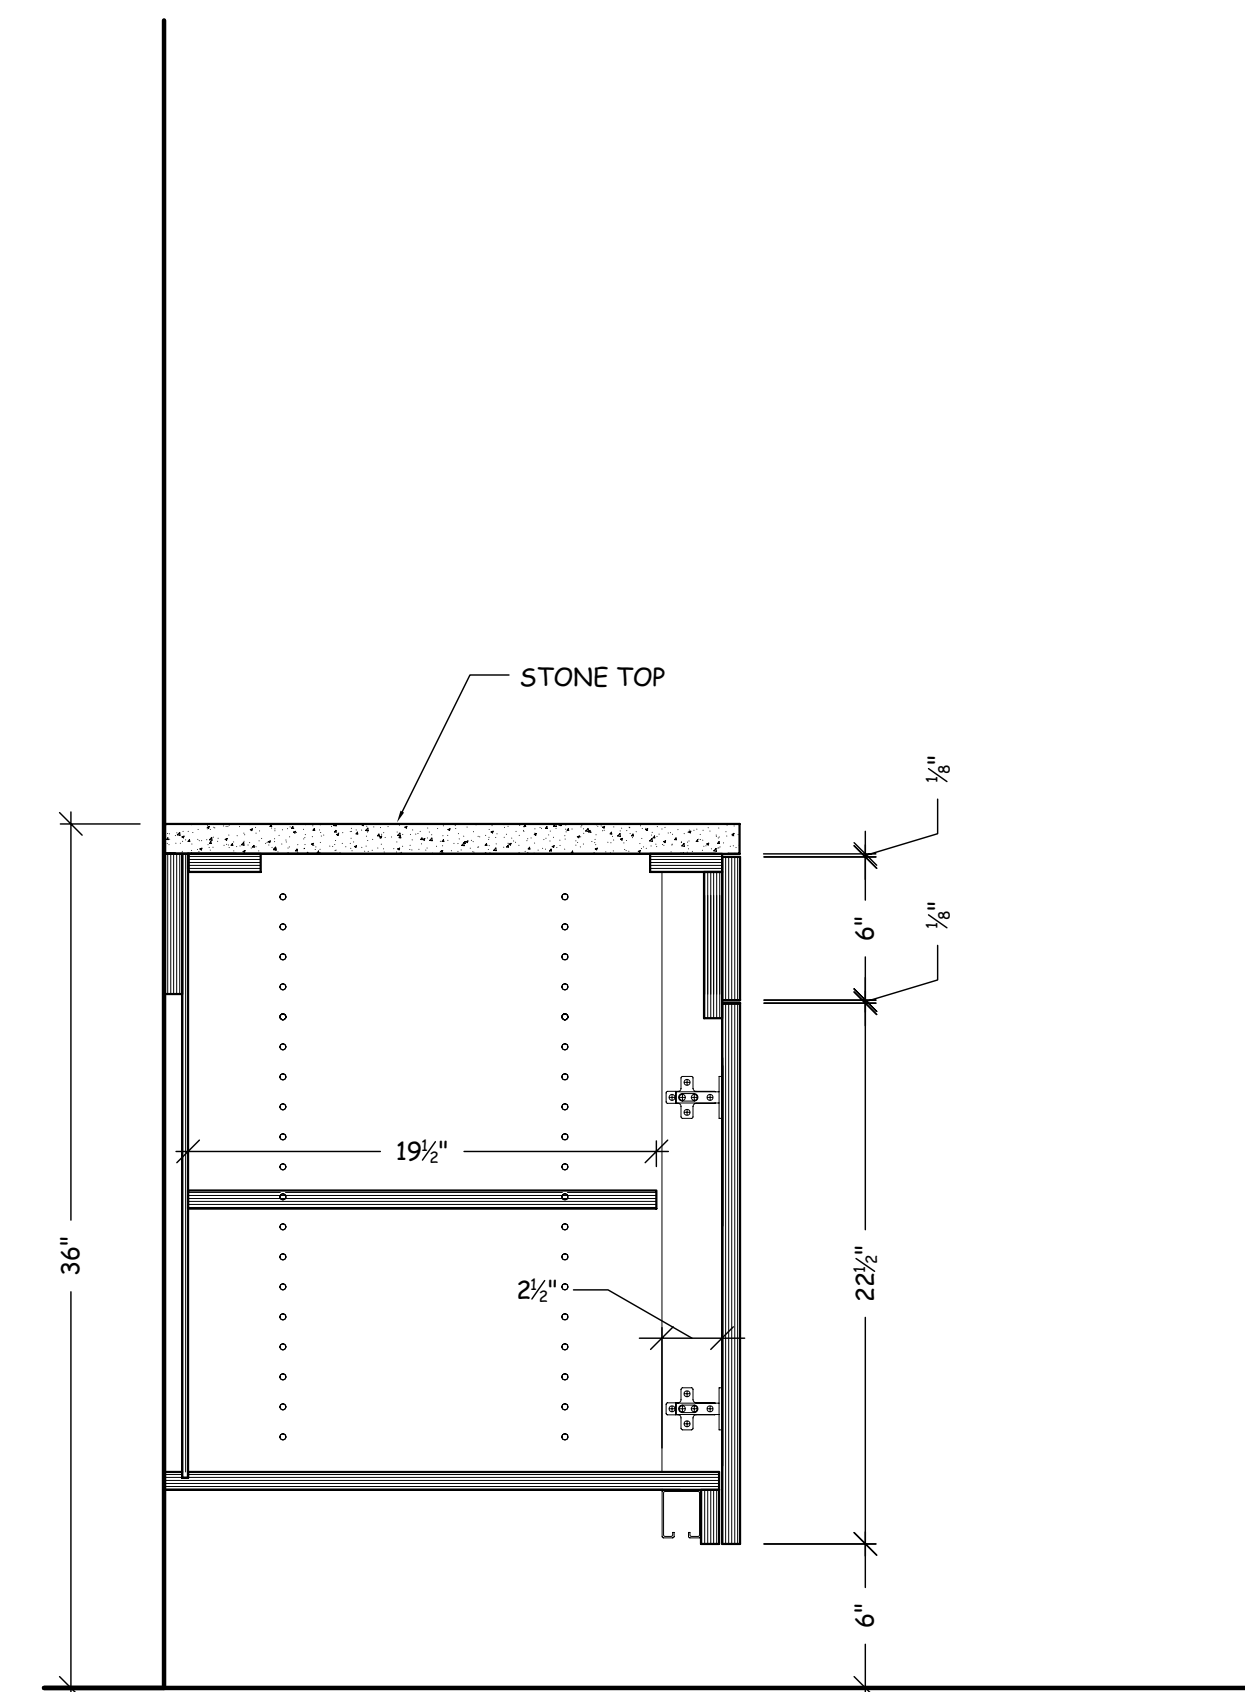

S.18 SECTION
SCALE: 1 1/2" = 1'-0"

General Notes

SHOP NOTES:

N&N Architectural Drafting Service
Computer Aided Design & Drafting/ CNC Programming

LEGEND:

 X VIEW
 X-X SHEET NO.
 X-X-X DIRECTION OF VIEW

Drawn by Nono K.

No.	Revision/Issue	Date
1	MARKUP PER OWNER/ARCH.	2-27


DRAWING RECORD

ARCHITECT:


CONTRACTOR:

Project Name and Address:


Project:	SECTIONS	Sheet:	S-5
Date:	2-05-07		
JOB # :	*		

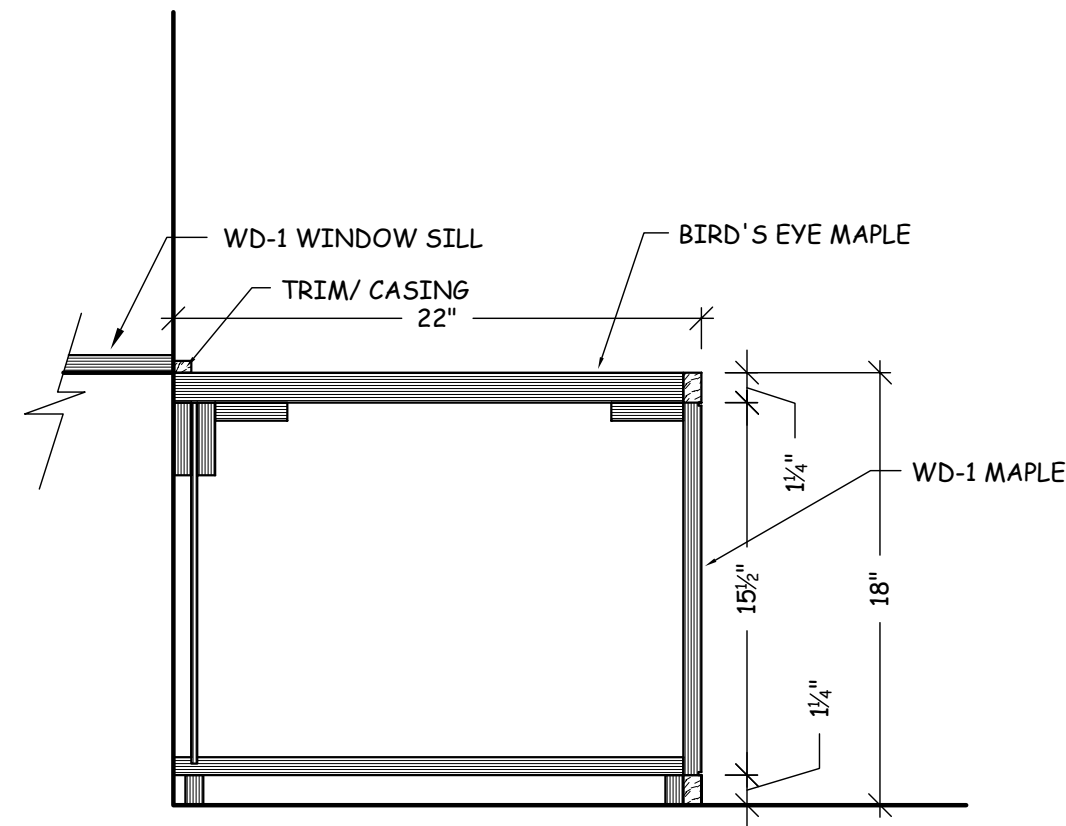


S.19 SECTION
SCALE: 1 1/2" = 1'-0"

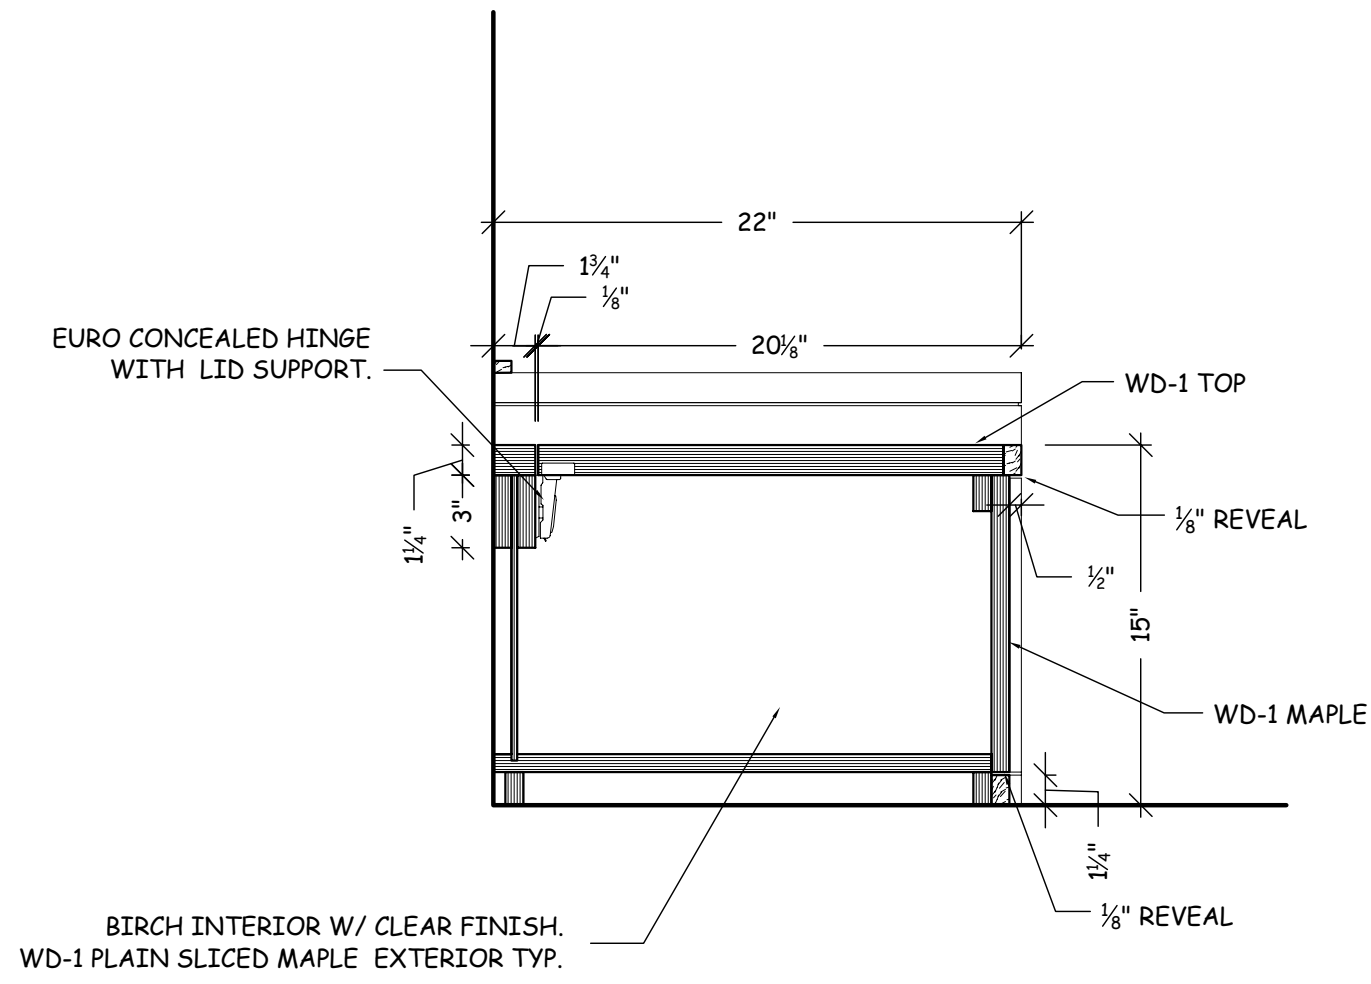

S.20 SECTION
SCALE: 1 1/2" = 1'-0"

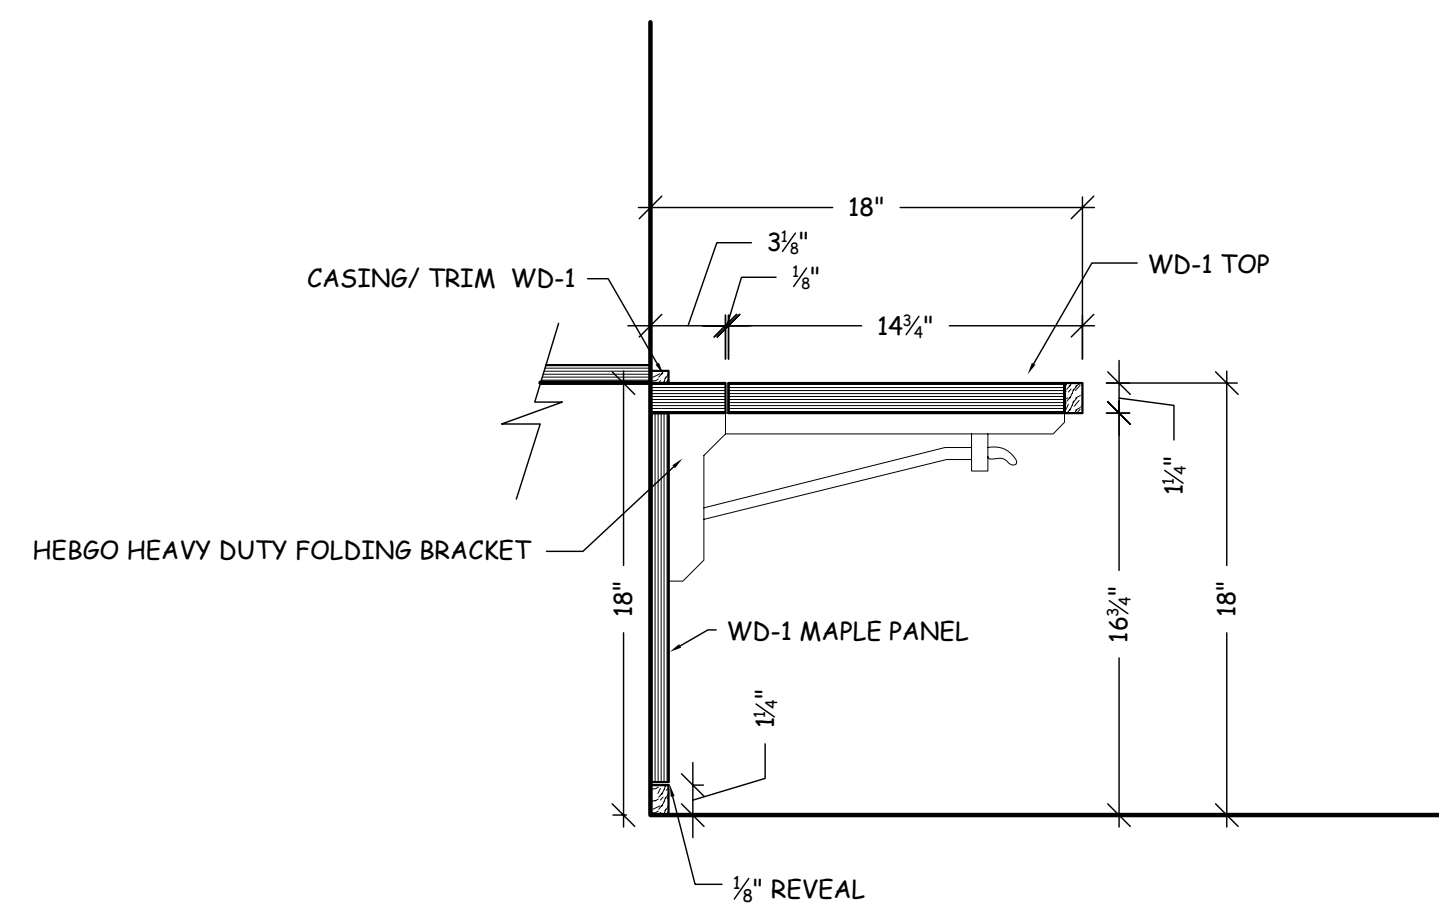

S.21 SECTION
SCALE: 1 1/2" = 1'-0"

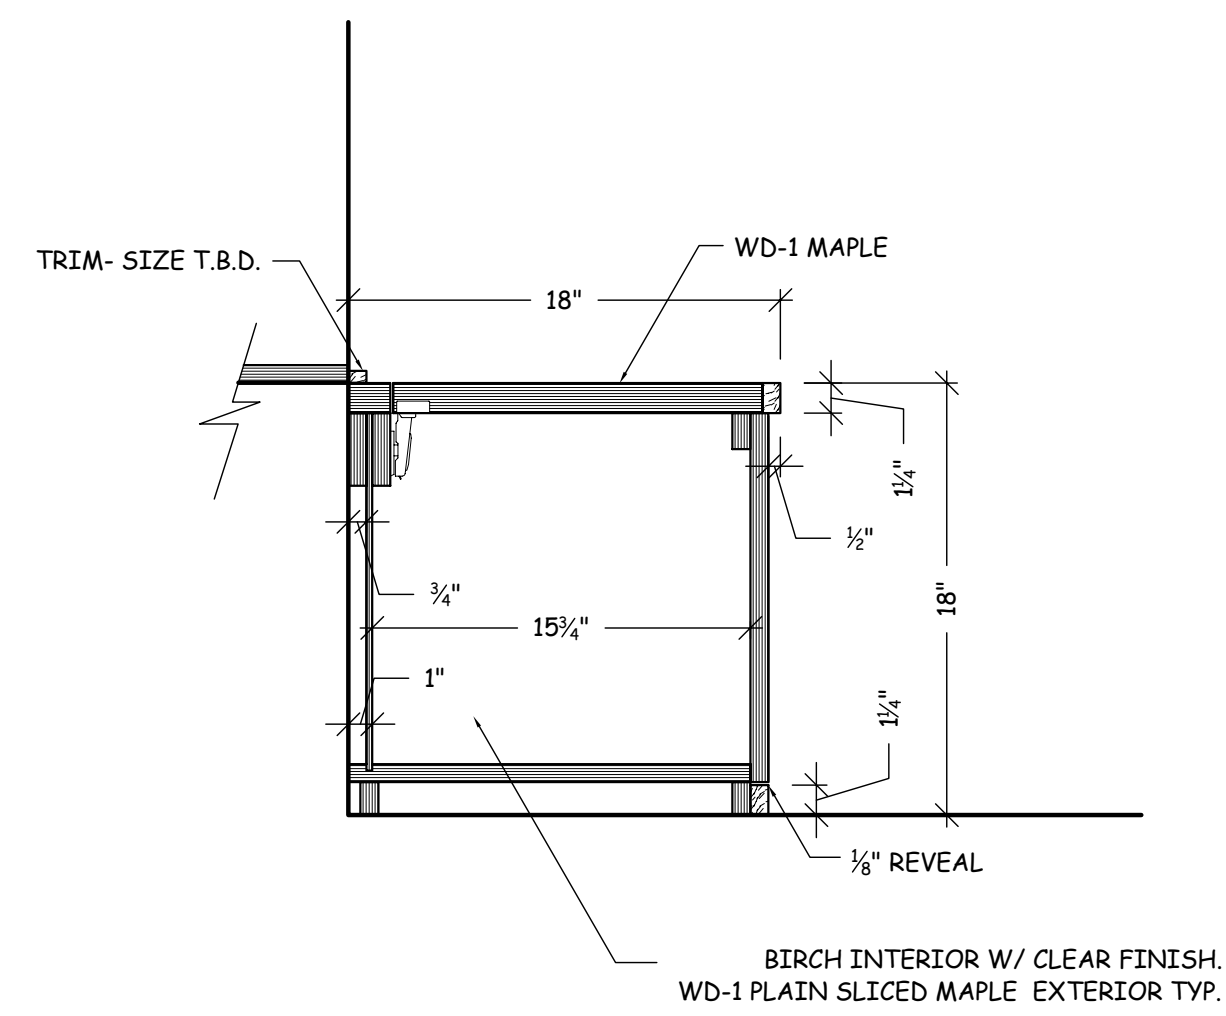


S.22 SECTION
SCALE: 1 1/2" = 1'-0"

General Notes

SHOP NOTES:

N&N Architectural Drafting Service
Computer Aided Design & Drafting/ CNC Programming

LEGEND:

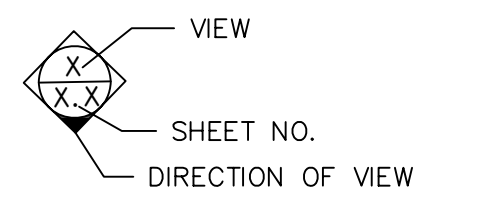

Drawn by Neno K.

No.	Revision/Issue	Date
-	UPDATED	2-03
1	MARKUP PER OWNER/ARCH.	2-27
-	1ST PHASE ADDITION	3-21
-	1ST PHASE ADDITION PART II	5-11

DRAWING RECORD

ARCHITECT:

CONTRACTOR:

Project Name and Address:


Project: *

Date: 5-11-07

JOB # : *


Sheet:

S-6

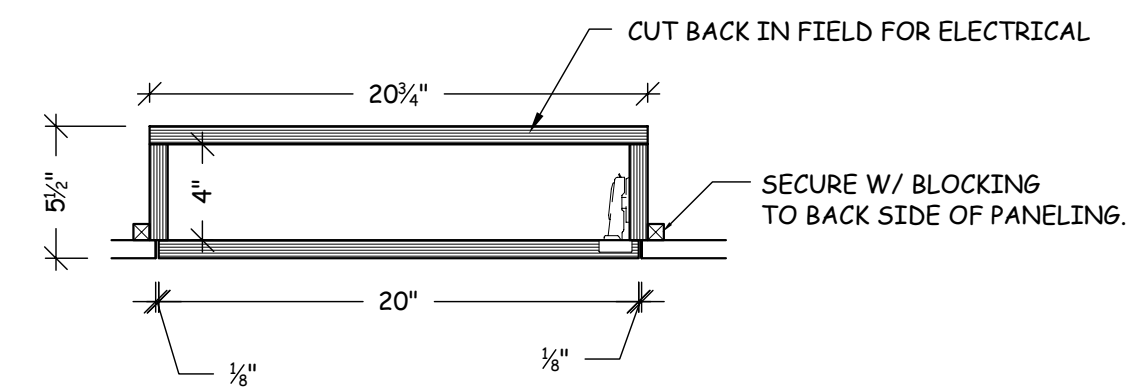


D.1 DETAIL— CLOSET EL. ACCESS PANEL
SCALE: 3" = 1'-0"


BIRCH INTERIOR W/ CLEAR FINISH.
WD-1 PLAIN SLICED MAPLE EXTERIOR TYP.

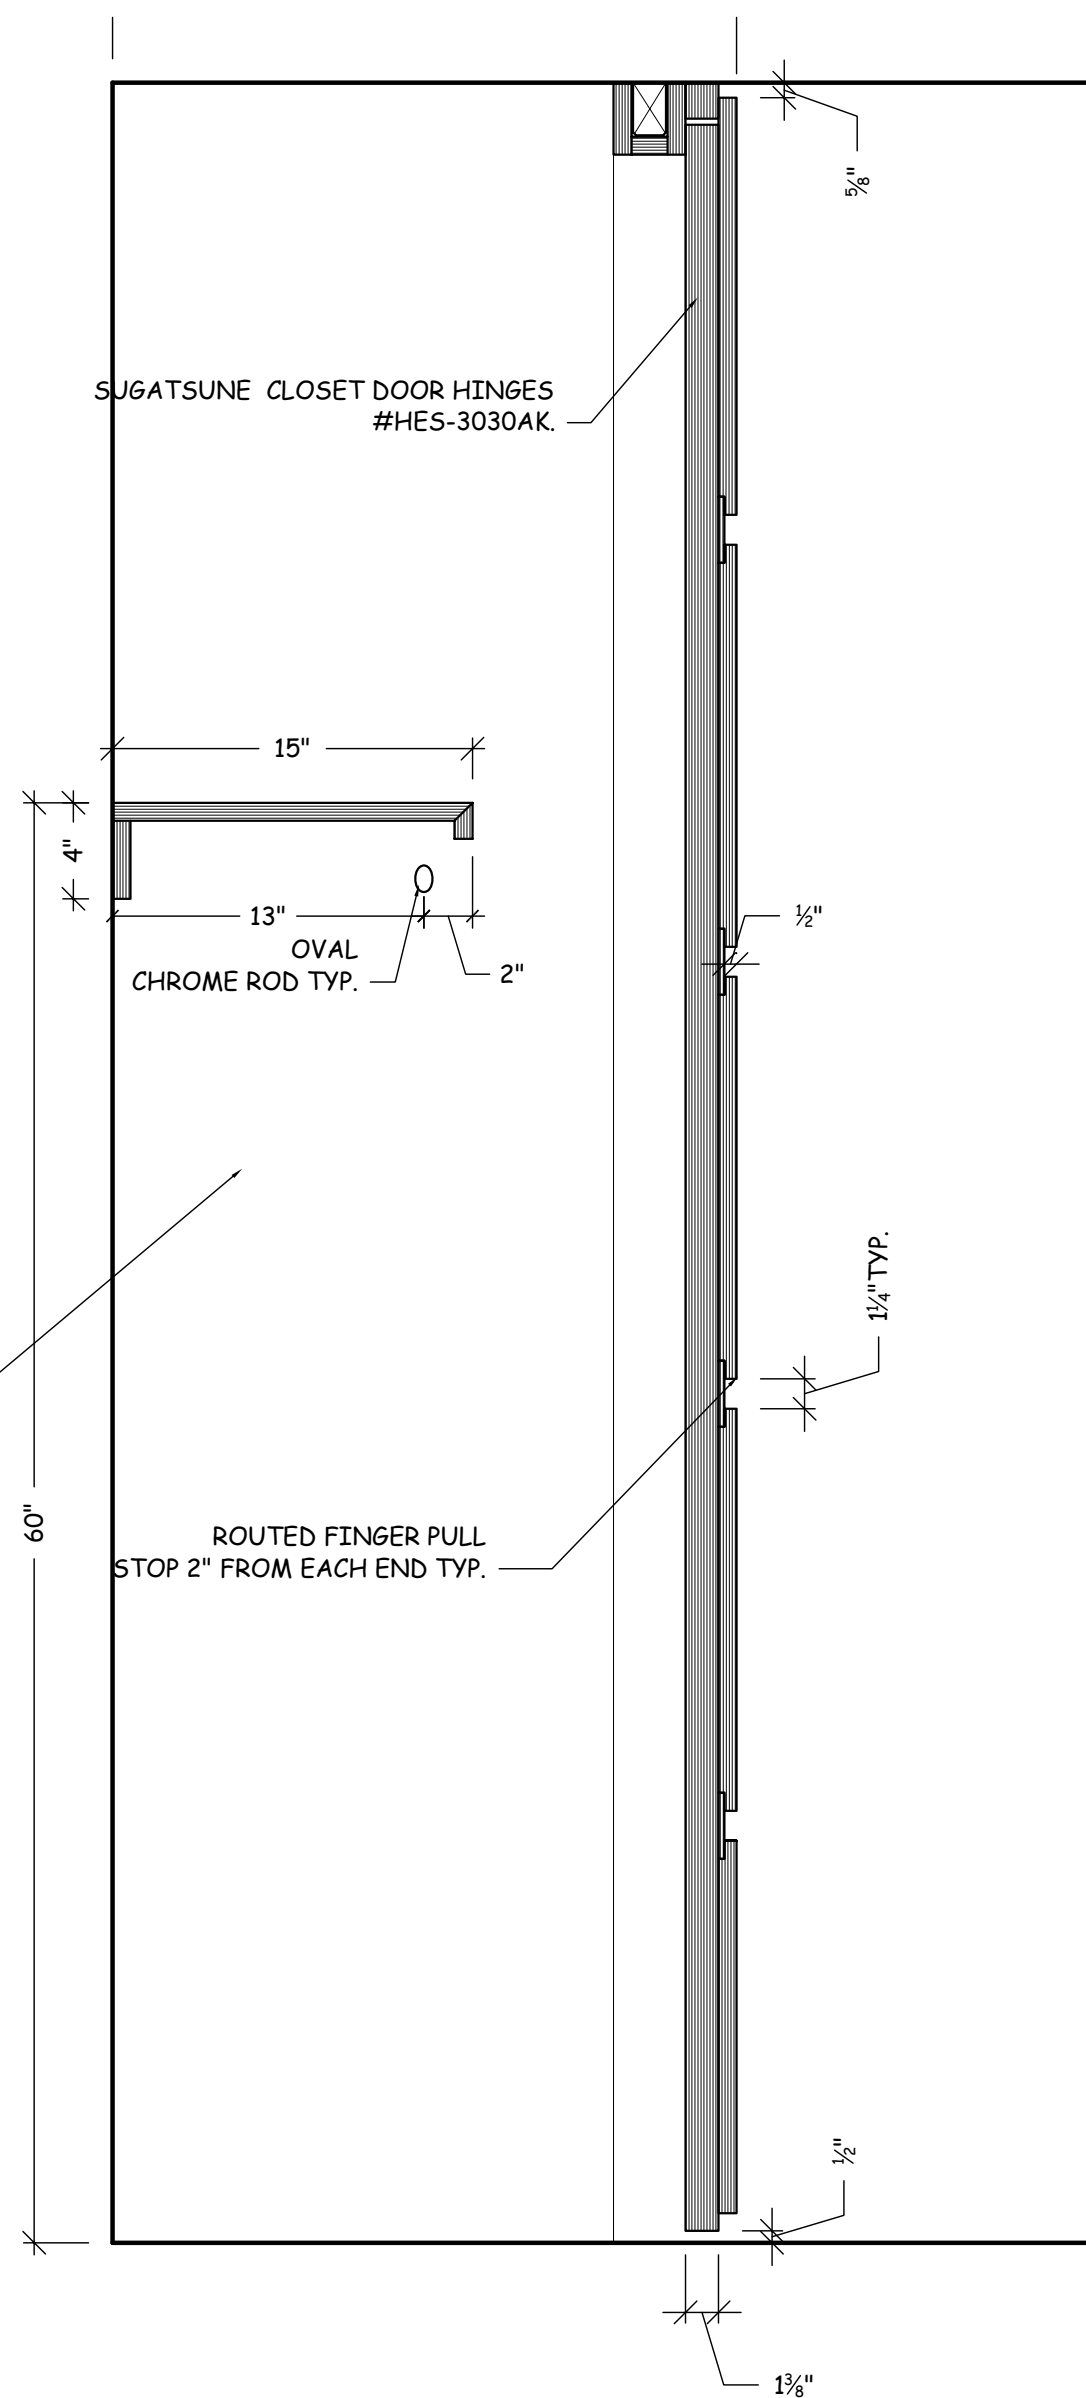


S.24 SECTION— CLOSET
SCALE: 1 1/2" = 1'-0"

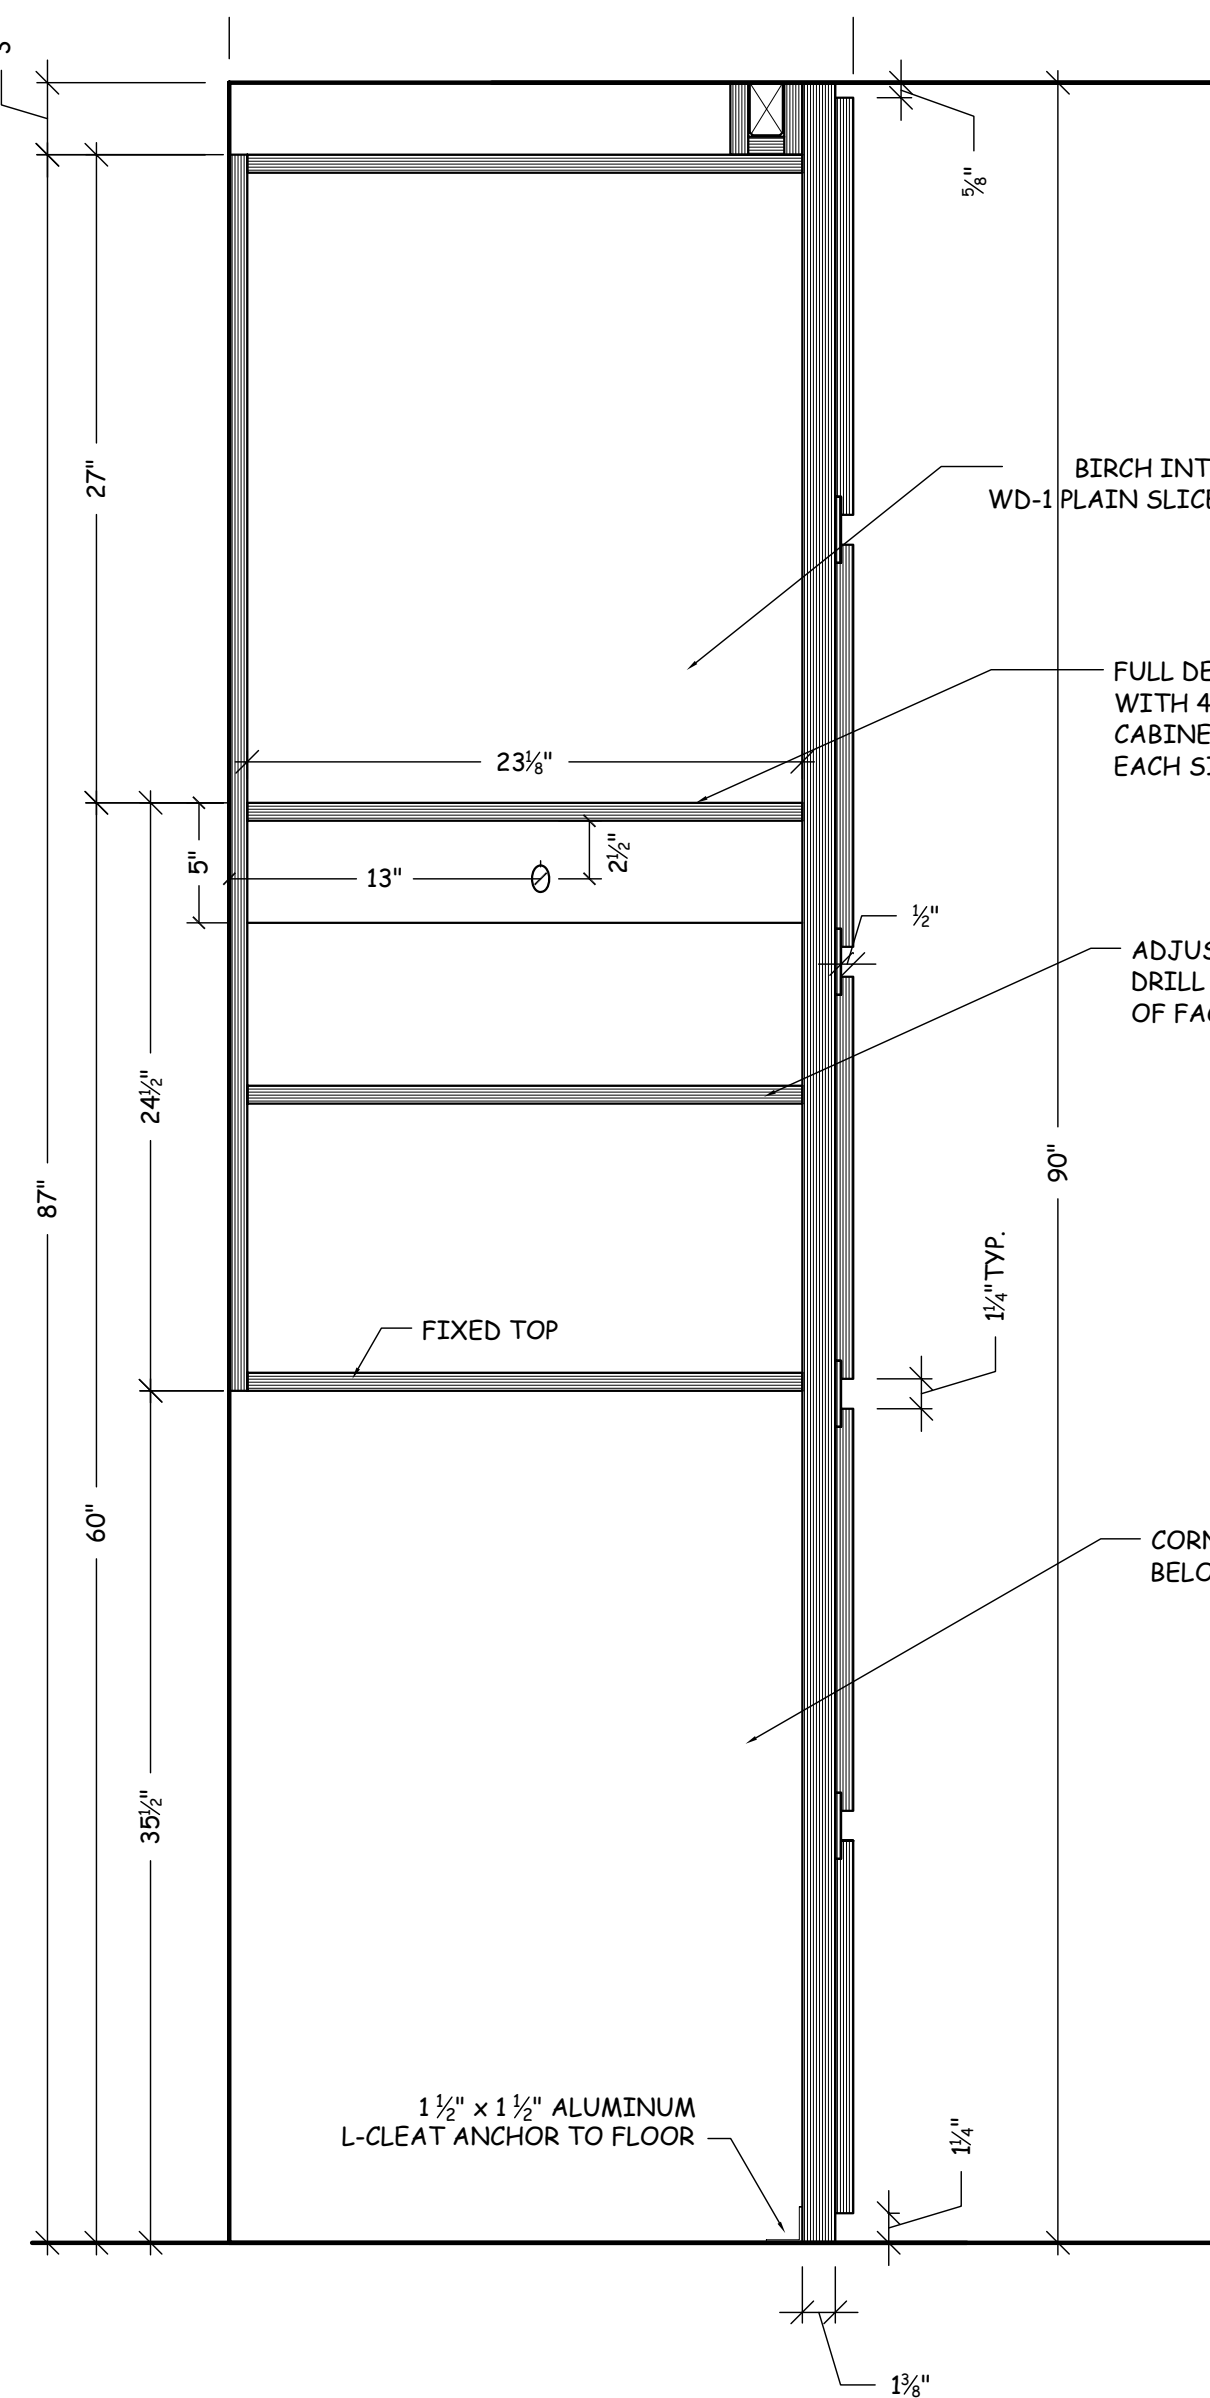


S.25 SECTION— CLOSET CORNER CABINET
SCALE: 1 1/2" = 1'-0"

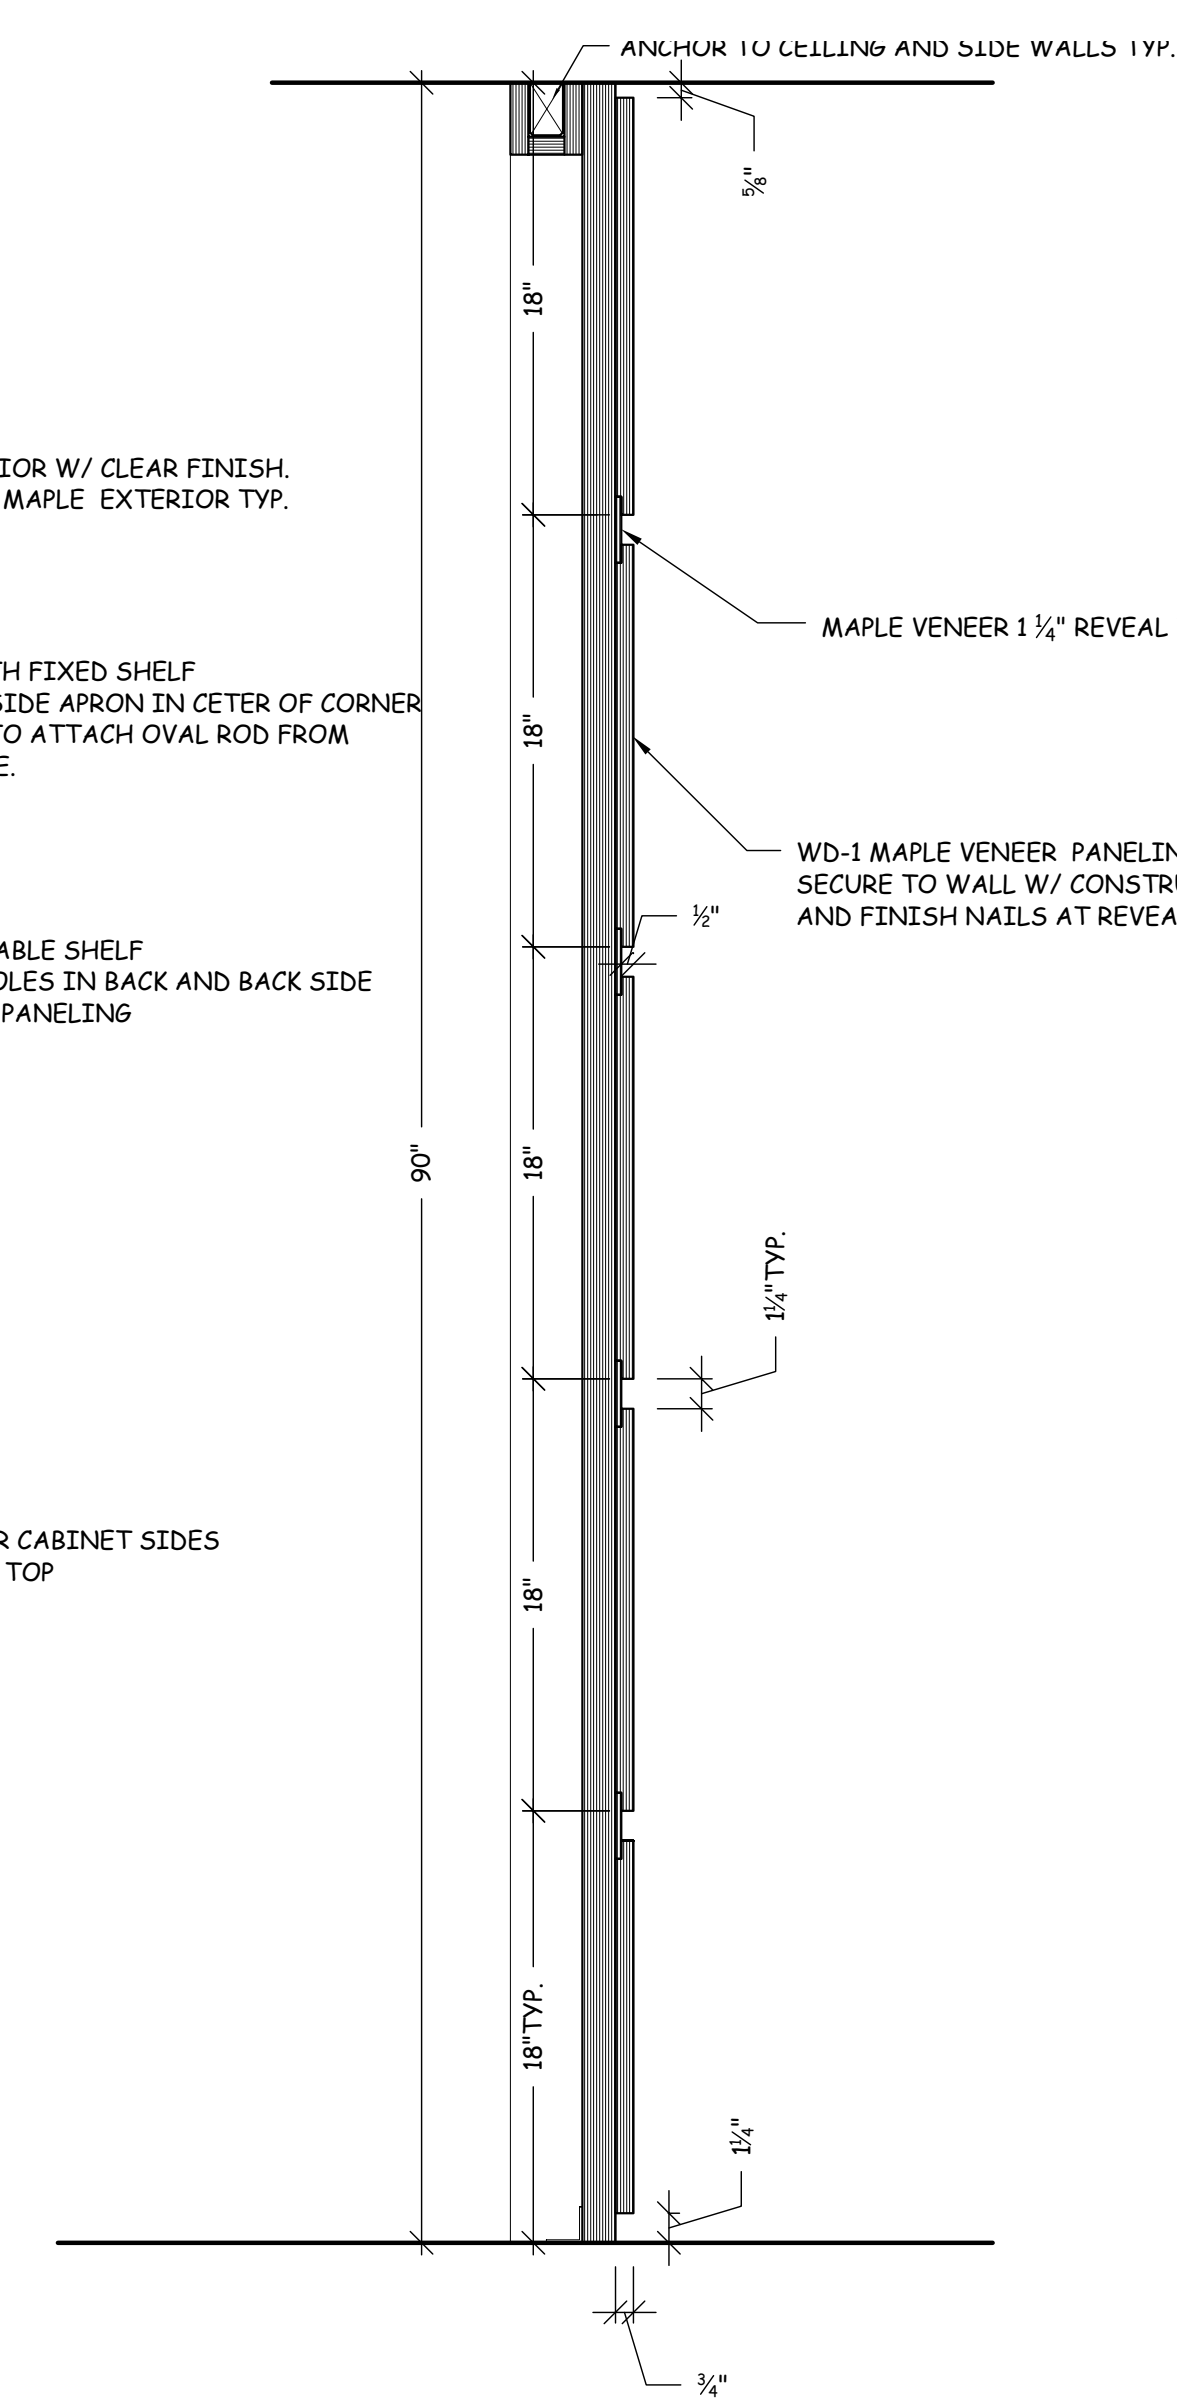

S.26 SECTION— CLOSET
SCALE: 1 1/2" = 1'-0"

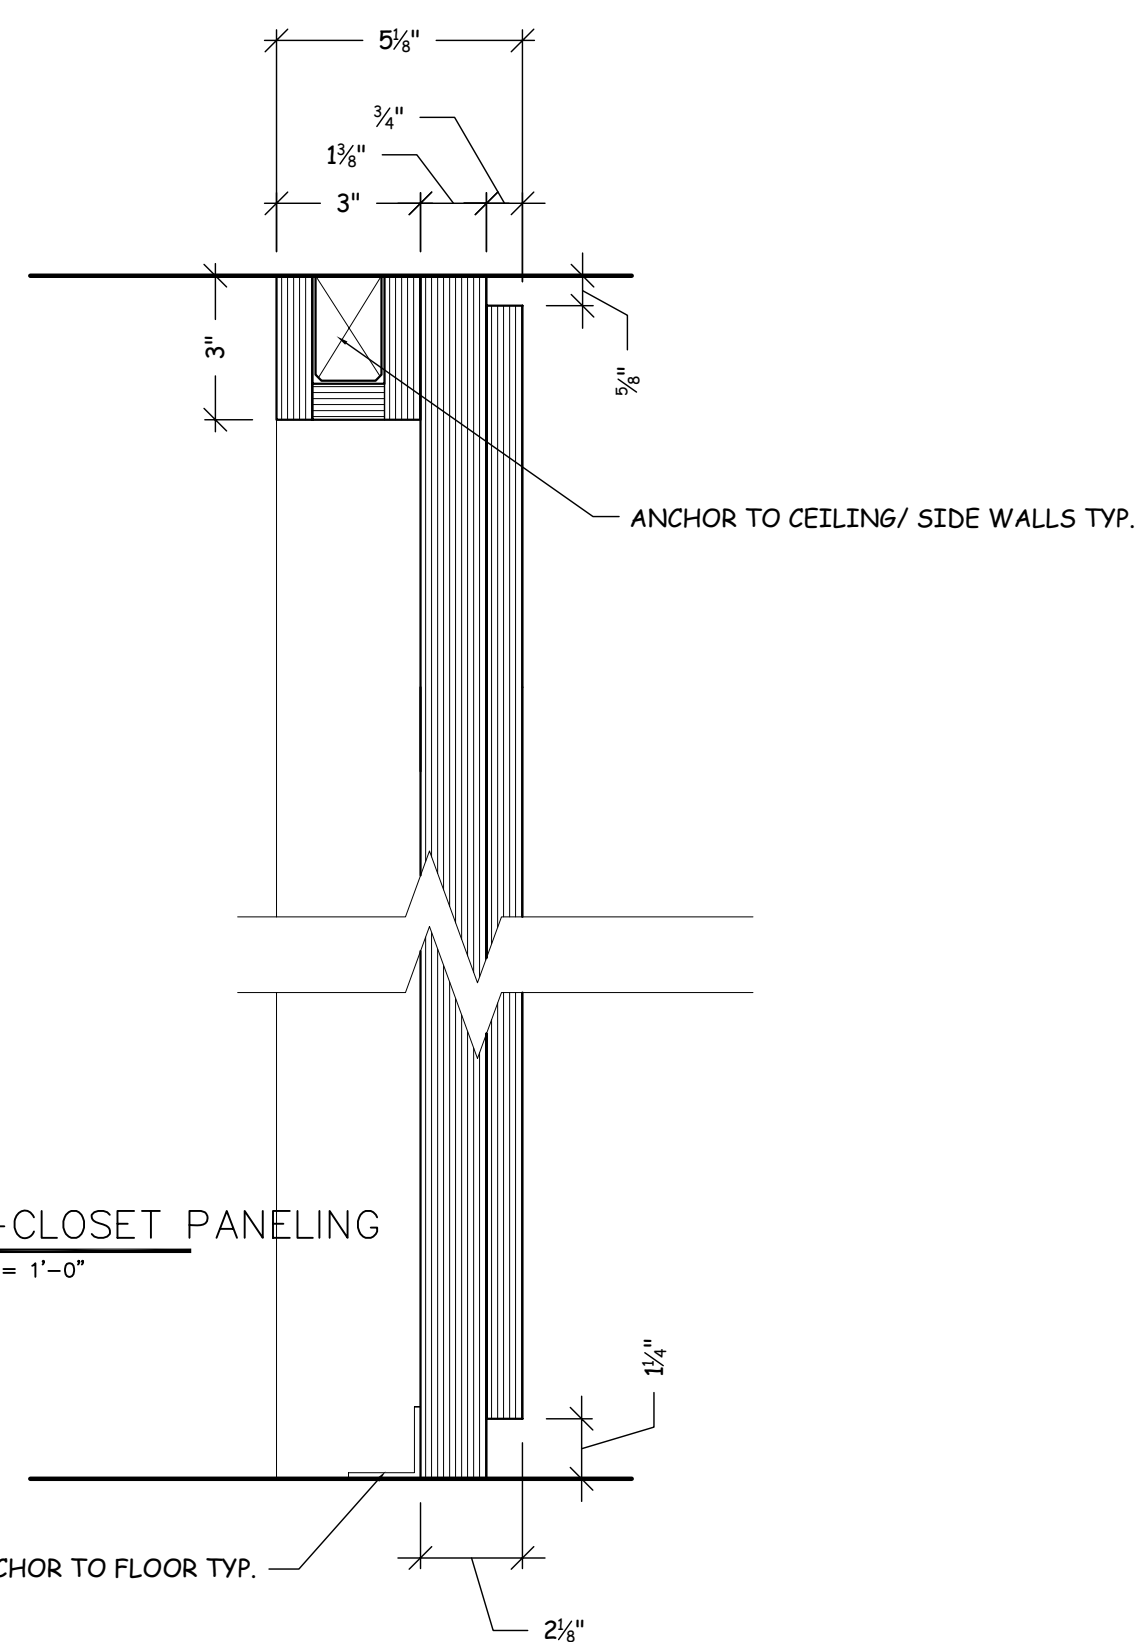

D.2 DETAIL— CLOSET PANELING
SCALE: 3" = 1'-0"

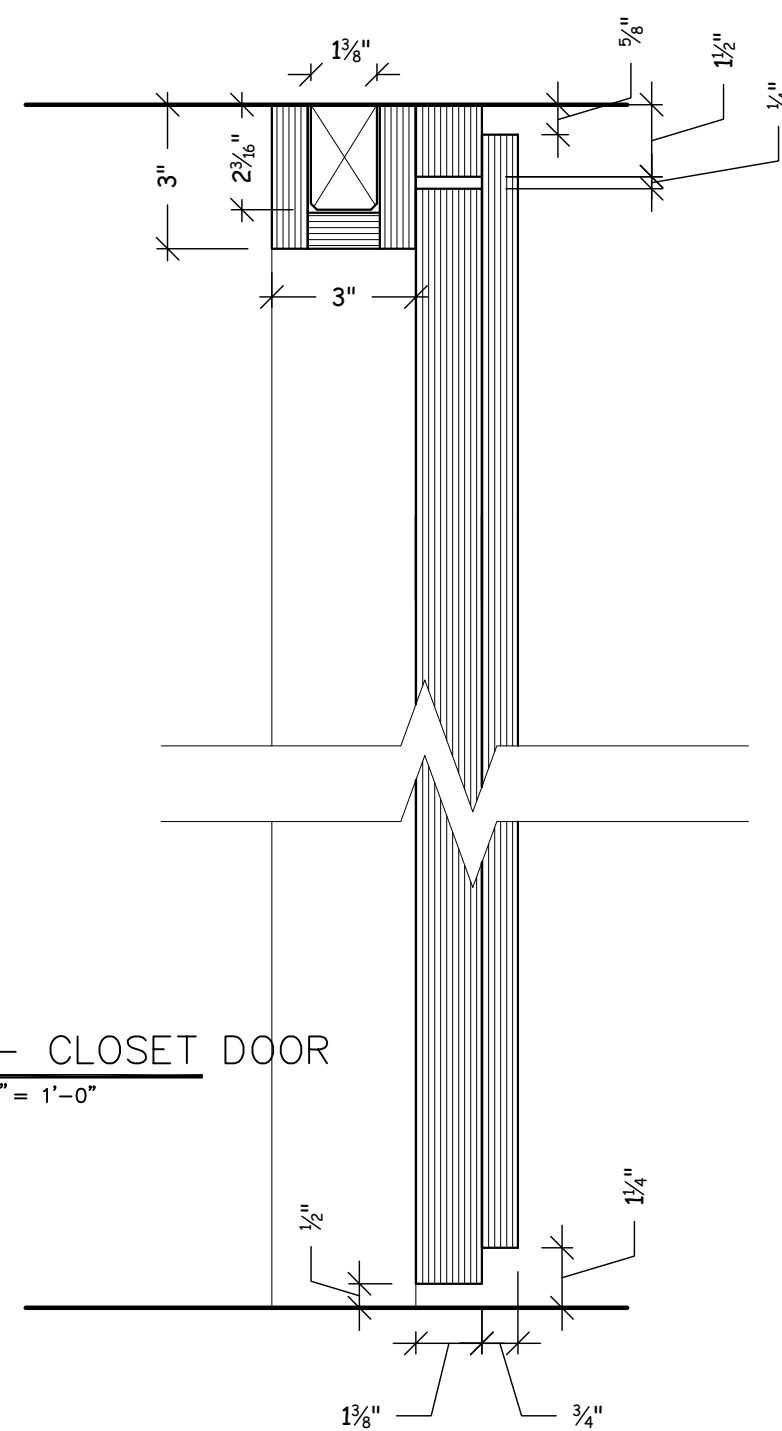

D.3 DETAIL— CLOSET DOOR
SCALE: 3" = 1'-0"

General Notes
SHOP NOTES:

N&N Architectural Drafting Service
Computer Aided Design & Drafting/ CNC Programming


LEGEND:
VIEW
SHEET NO.
DIRECTION OF VIEW

Drawn by Neno K.

No.	Revision/Issue	Date
-	UPDATED	2-03
1	MARKUP PER OWNER/ARCH.	2-27
-	1ST PHASE ADDITION	3-21
-	1ST PHASE ADDITION PART II	5-11


DRAWING RECORD

ARCHITECT:	
CONTRACTOR:	
Project Name and Address:	
Project: *	Sheet:
Date: 5-11-07	S-7
JOB #: *	

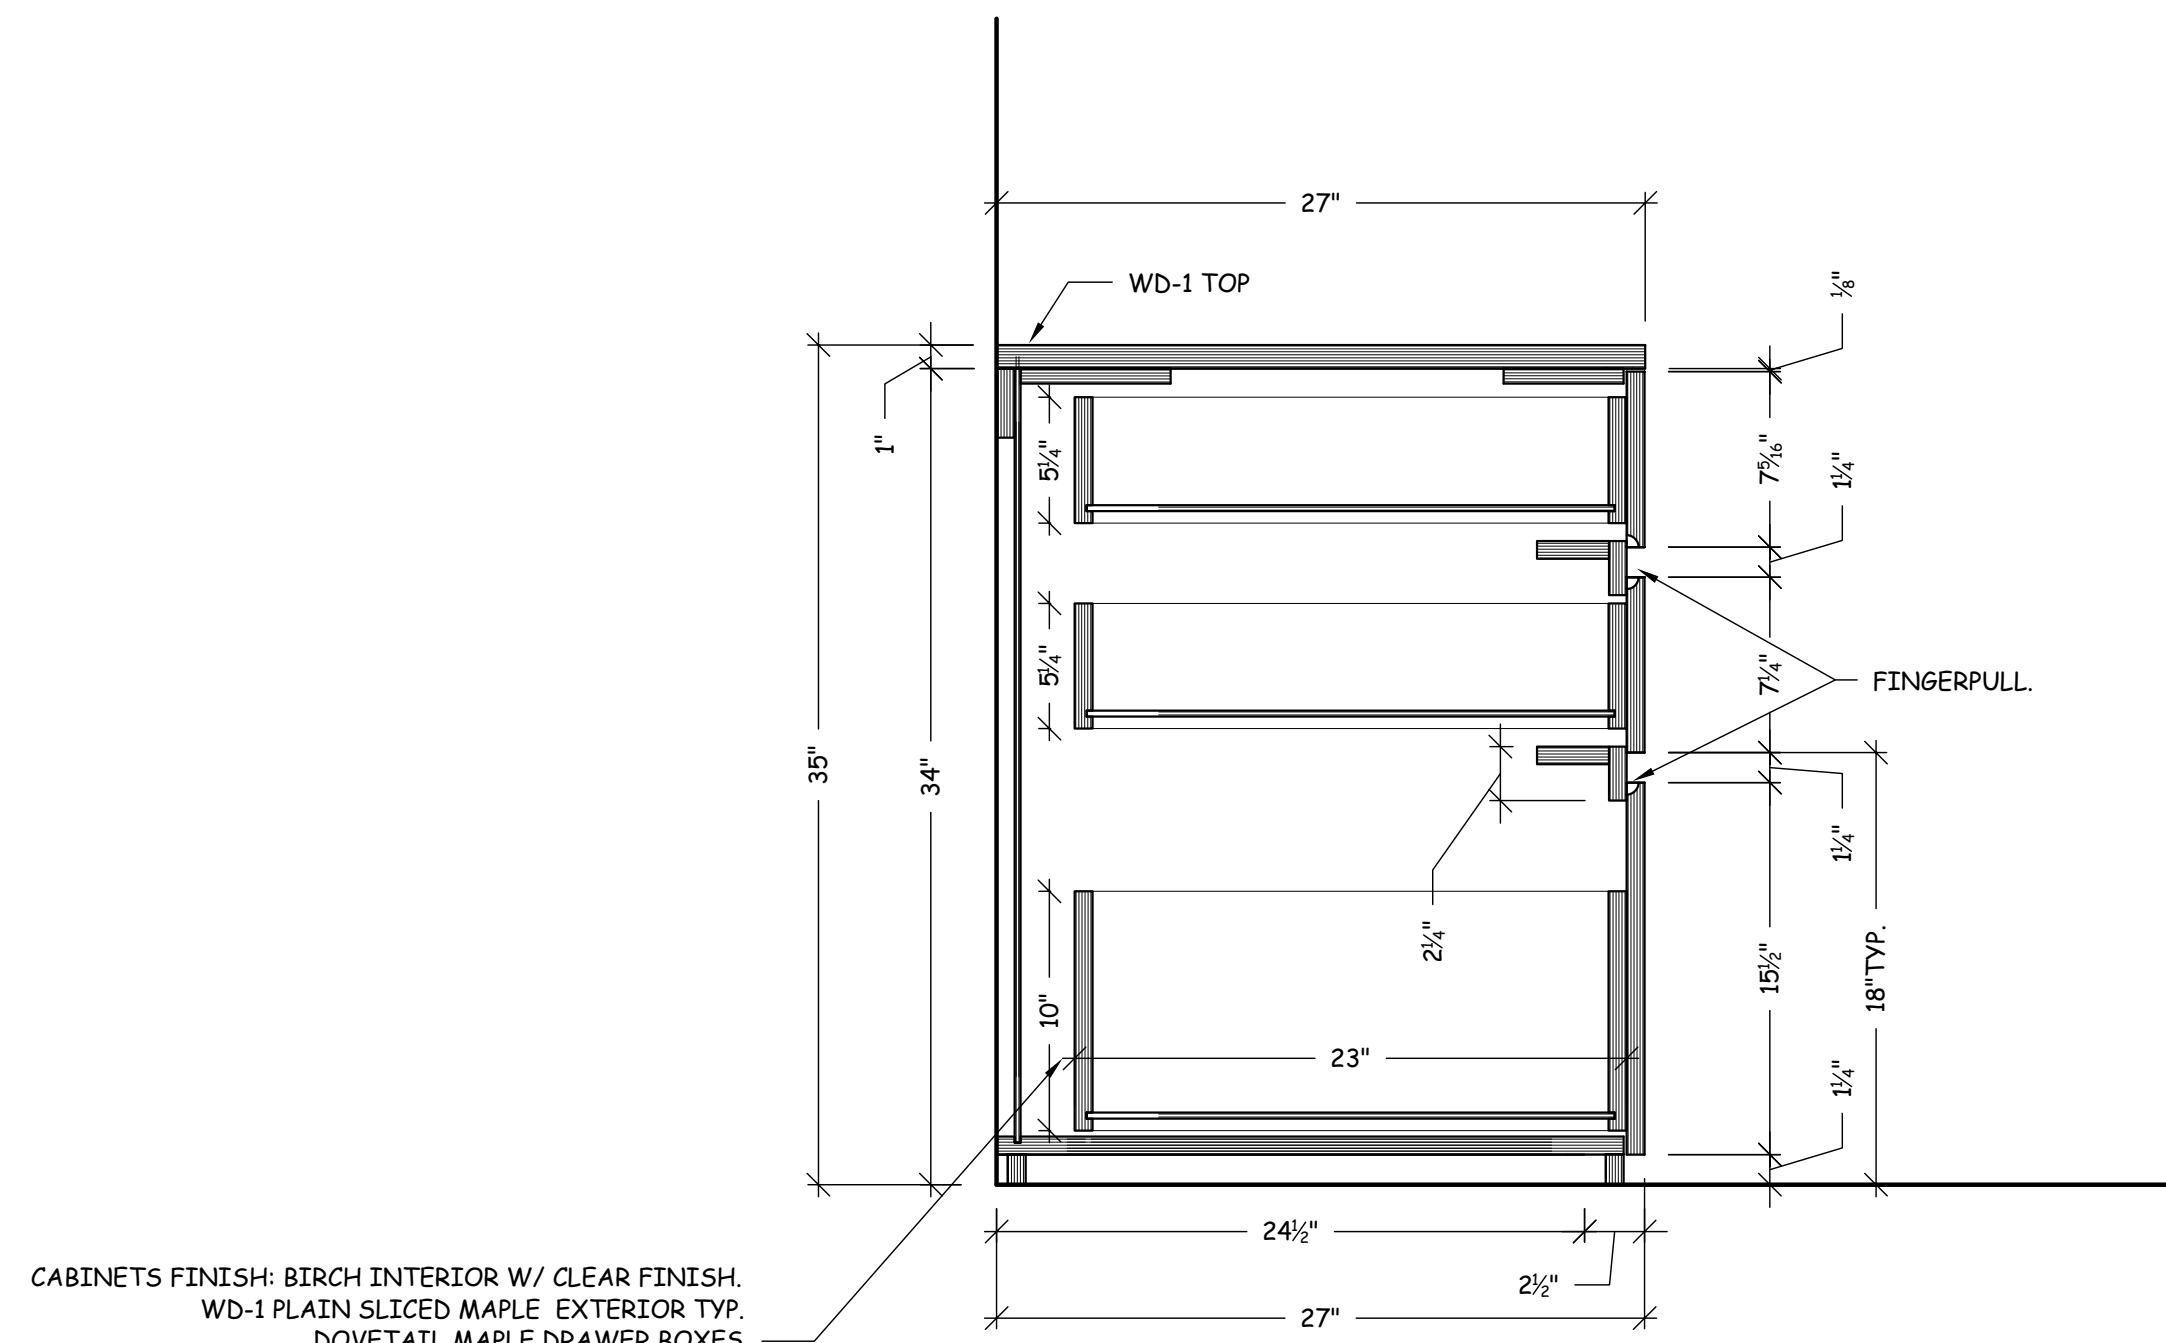


CABINETS FINISH: BIRCH INTERIOR W/ CLEAR FINISH.
WD-1 PLAIN SLICED MAPLE EXTERIOR TYP.
DOVETAIL MAPLE DRAWER BOXES

S.27 SECTION
SCALE: 1 1/2" = 1'-0"

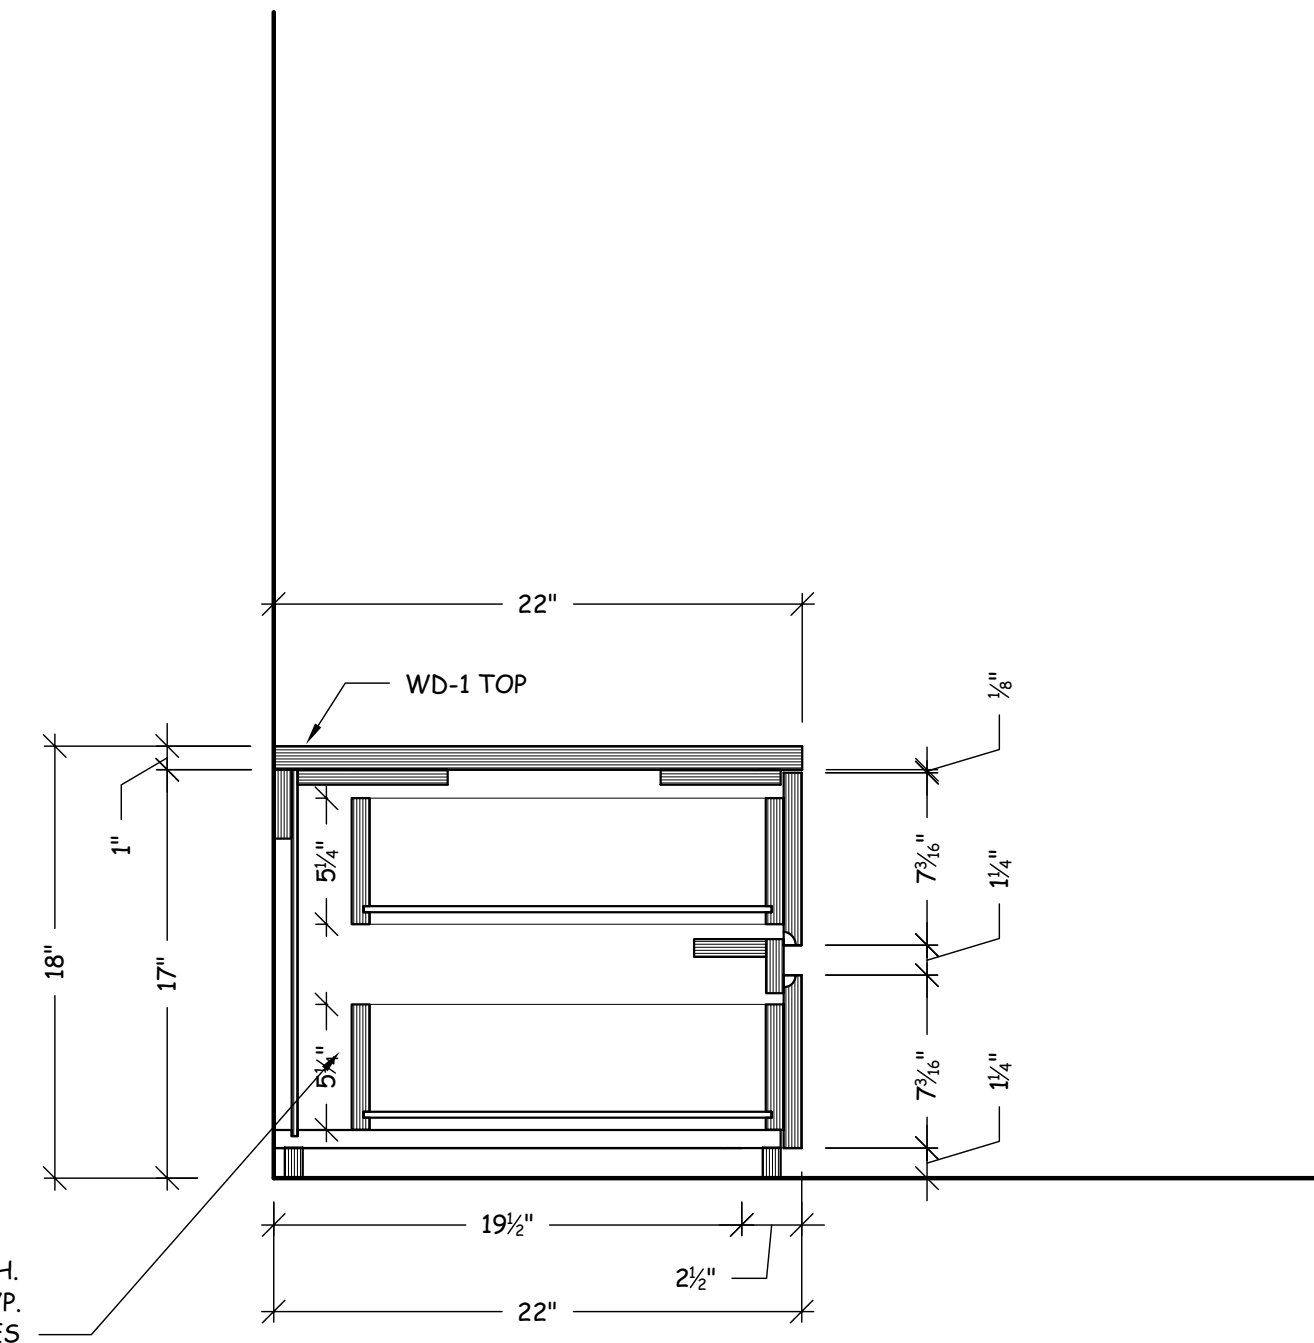


CABINETS FINISH: BIRCH INTERIOR W/ CLEAR FINISH.
WD-1 PLAIN SLICED MAPLE EXTERIOR TYP.
DOVETAIL MAPLE DRAWER BOXES


S.28 SECTION
SCALE: 1 1/2" = 1'-0"

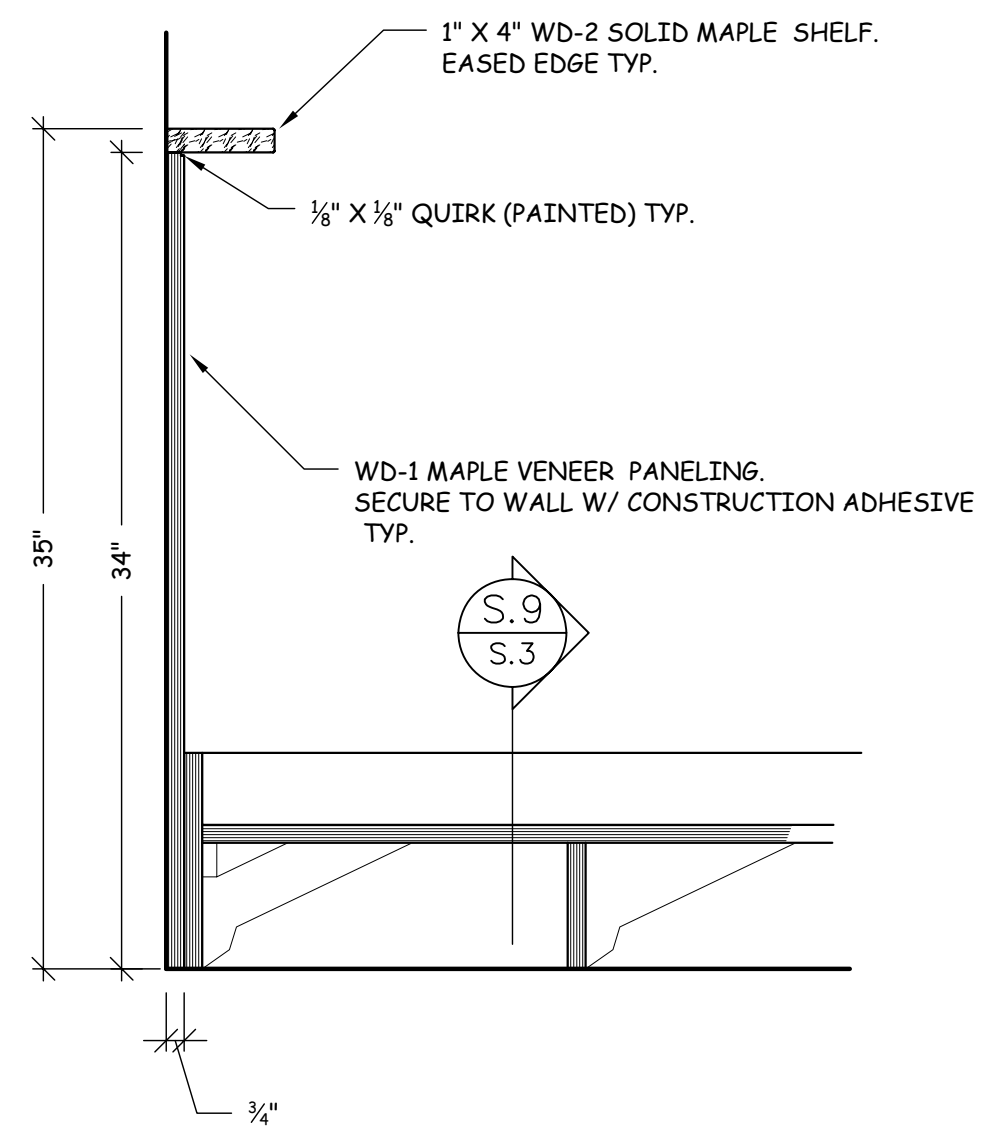

S.29 SECTION
SCALE: 1 1/2" = 1'-0"

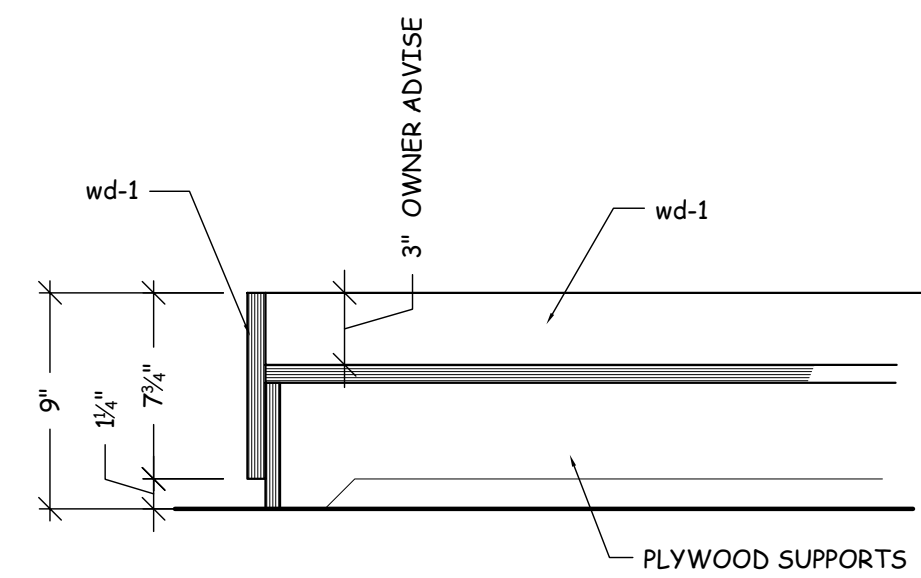

S.30 SECTION
SCALE: 1 1/2" = 1'-0"

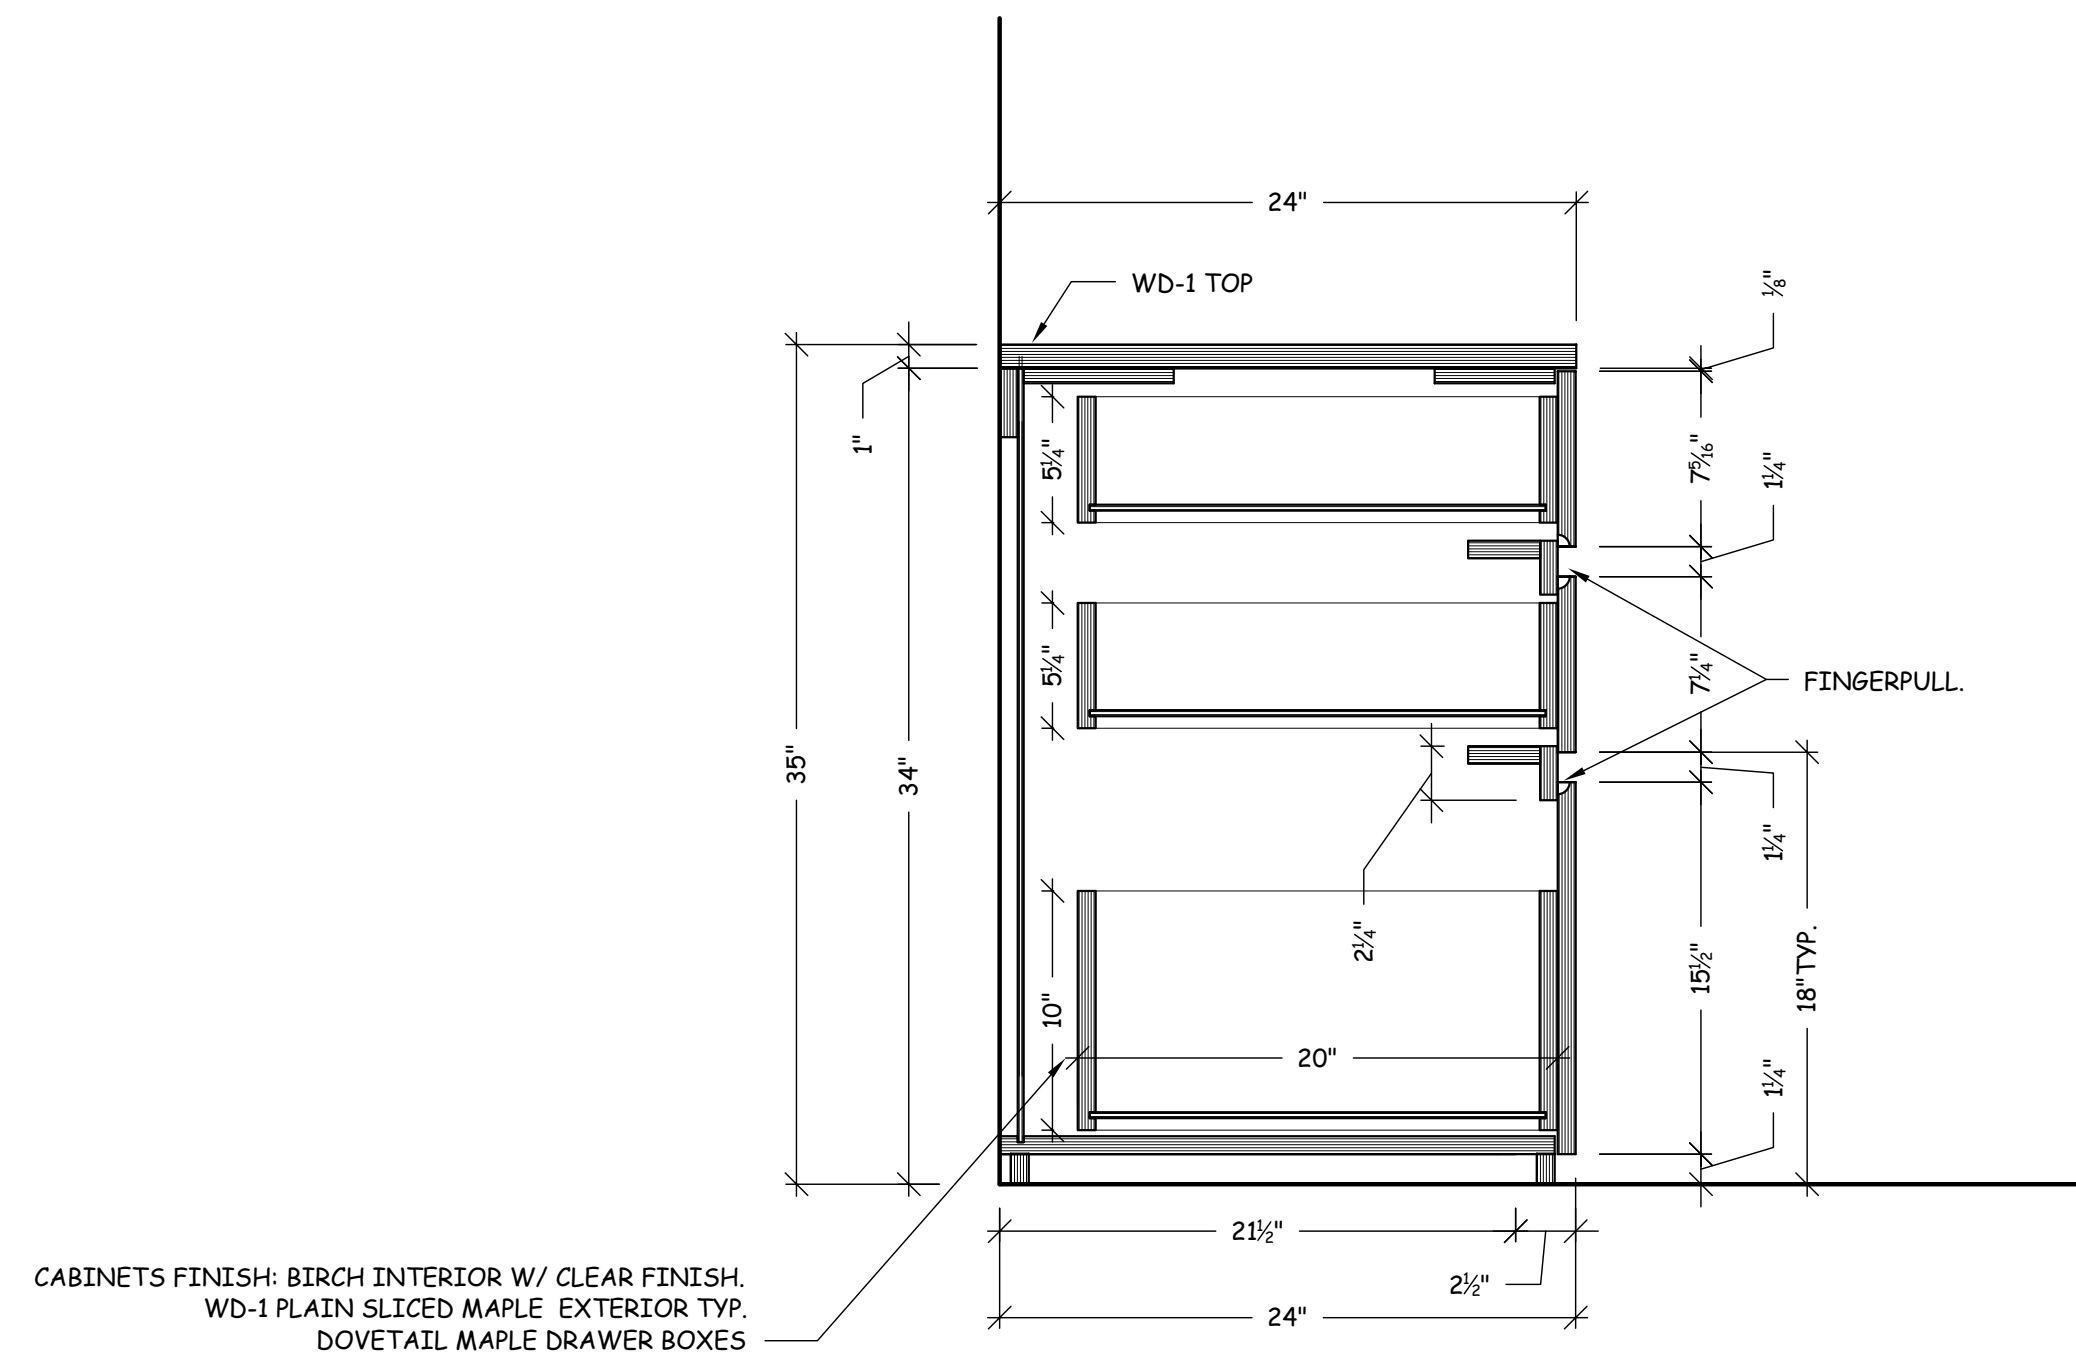

CABINETS FINISH: BIRCH INTERIOR W/ CLEAR FINISH.
WD-1 PLAIN SLICED MAPLE EXTERIOR TYP.
DOVETAIL MAPLE DRAWER BOXES

S.31 SECTION
SCALE: 1 1/2" = 1'-0"

General Notes

SHOP NOTES:

N&N Architectural Drafting Service
Computer Aided Design & Drafting/ CNC Programming


LEGEND:
VIEW
SHEET NO.
DIRECTION OF VIEW

Drawn by Nono K.


No.	Revision/Issue	Date

DRAWING RECORD


ARCHITECT:	
CONTRACTOR:	
Project Name and Address:	
Project:	
Date: 7-23-07	Sheet: S-8
JOB # : *	

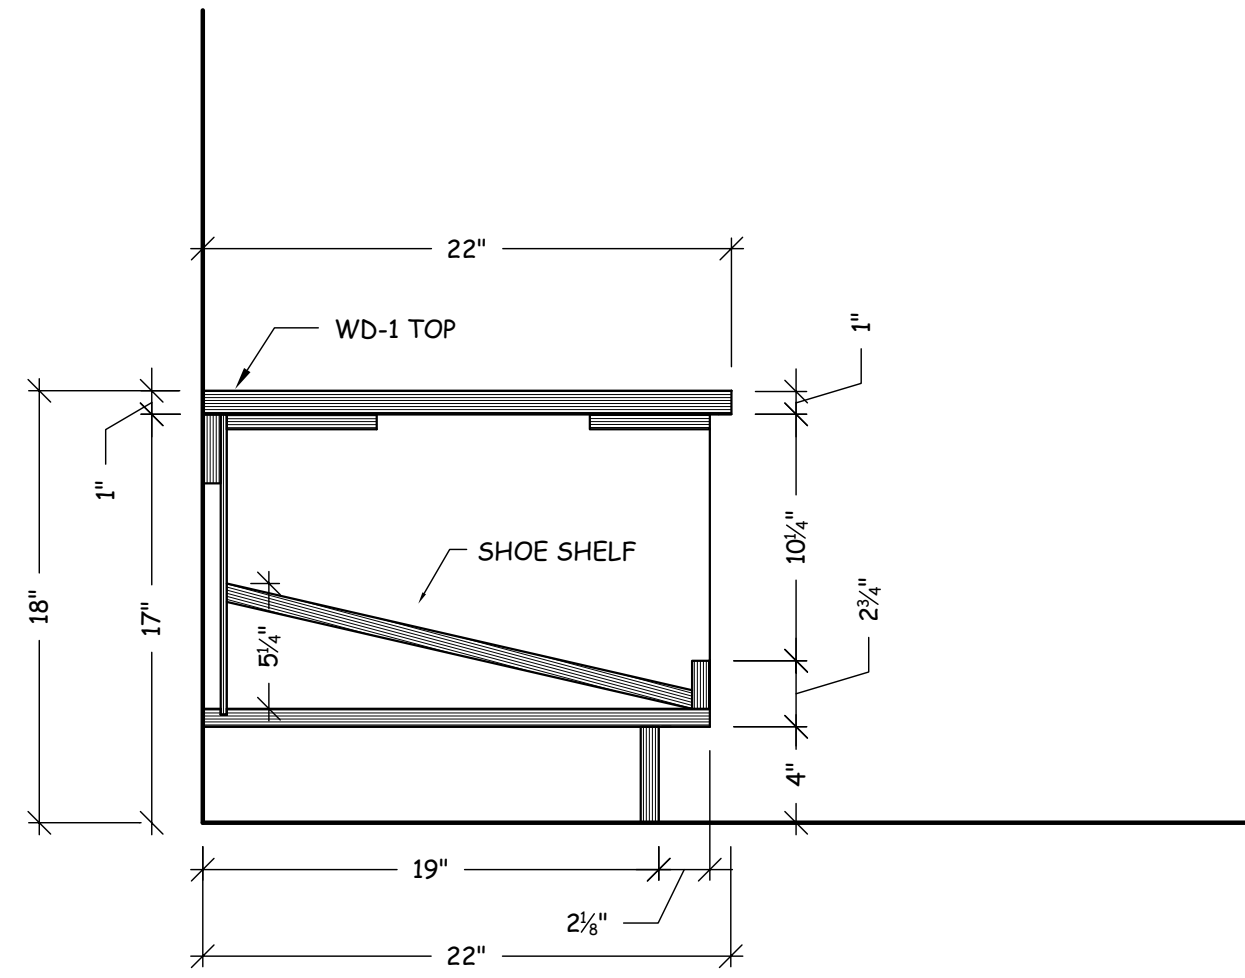


S.32 SECTION
SCALE: 1 1/2" = 1'-0"

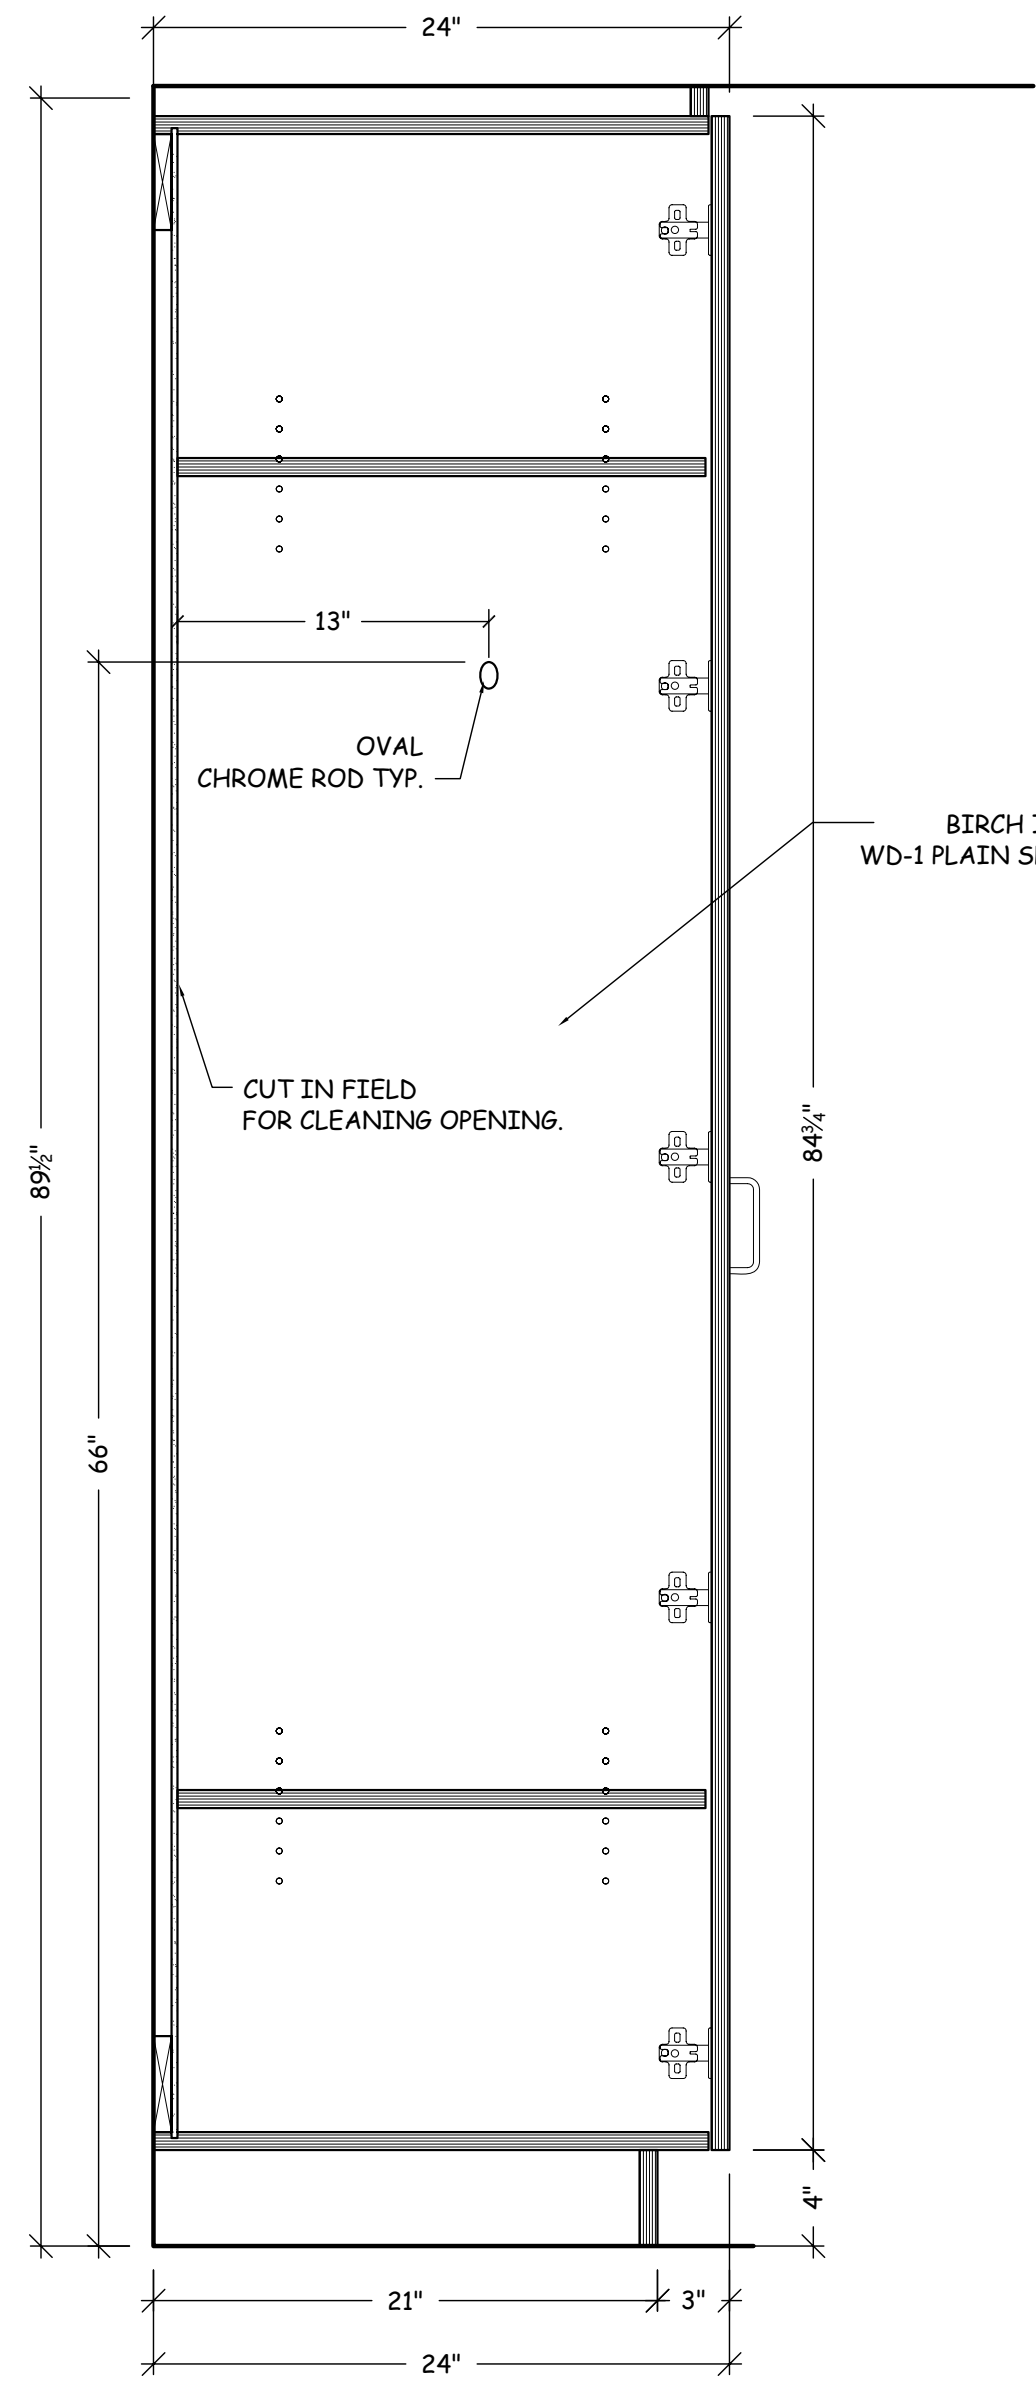

S.33 SECTION
SCALE: 1 1/2" = 1'-0"

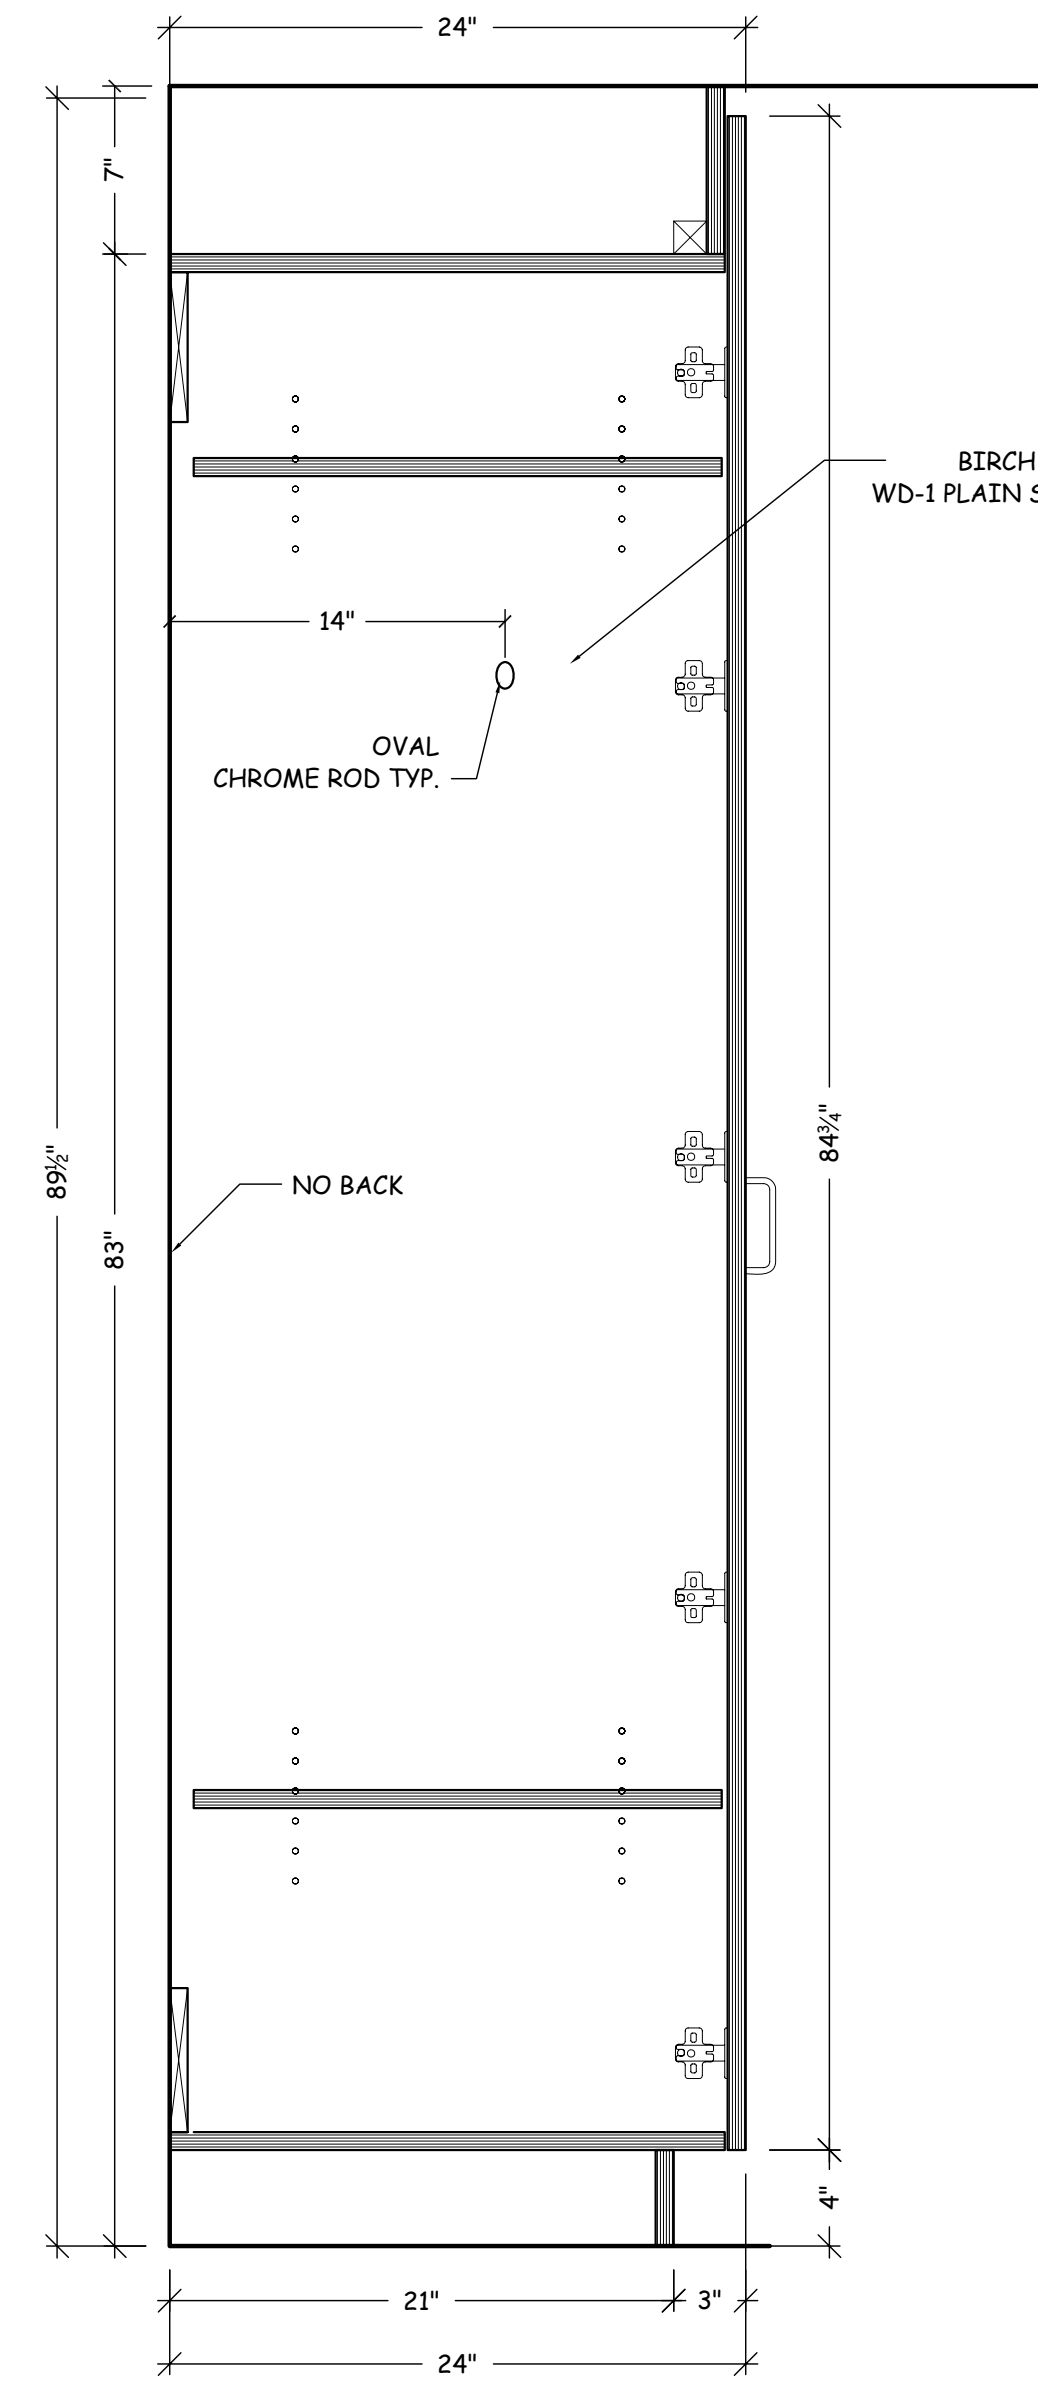

S.34 SECTION
SCALE: 1 1/2" = 1'-0"

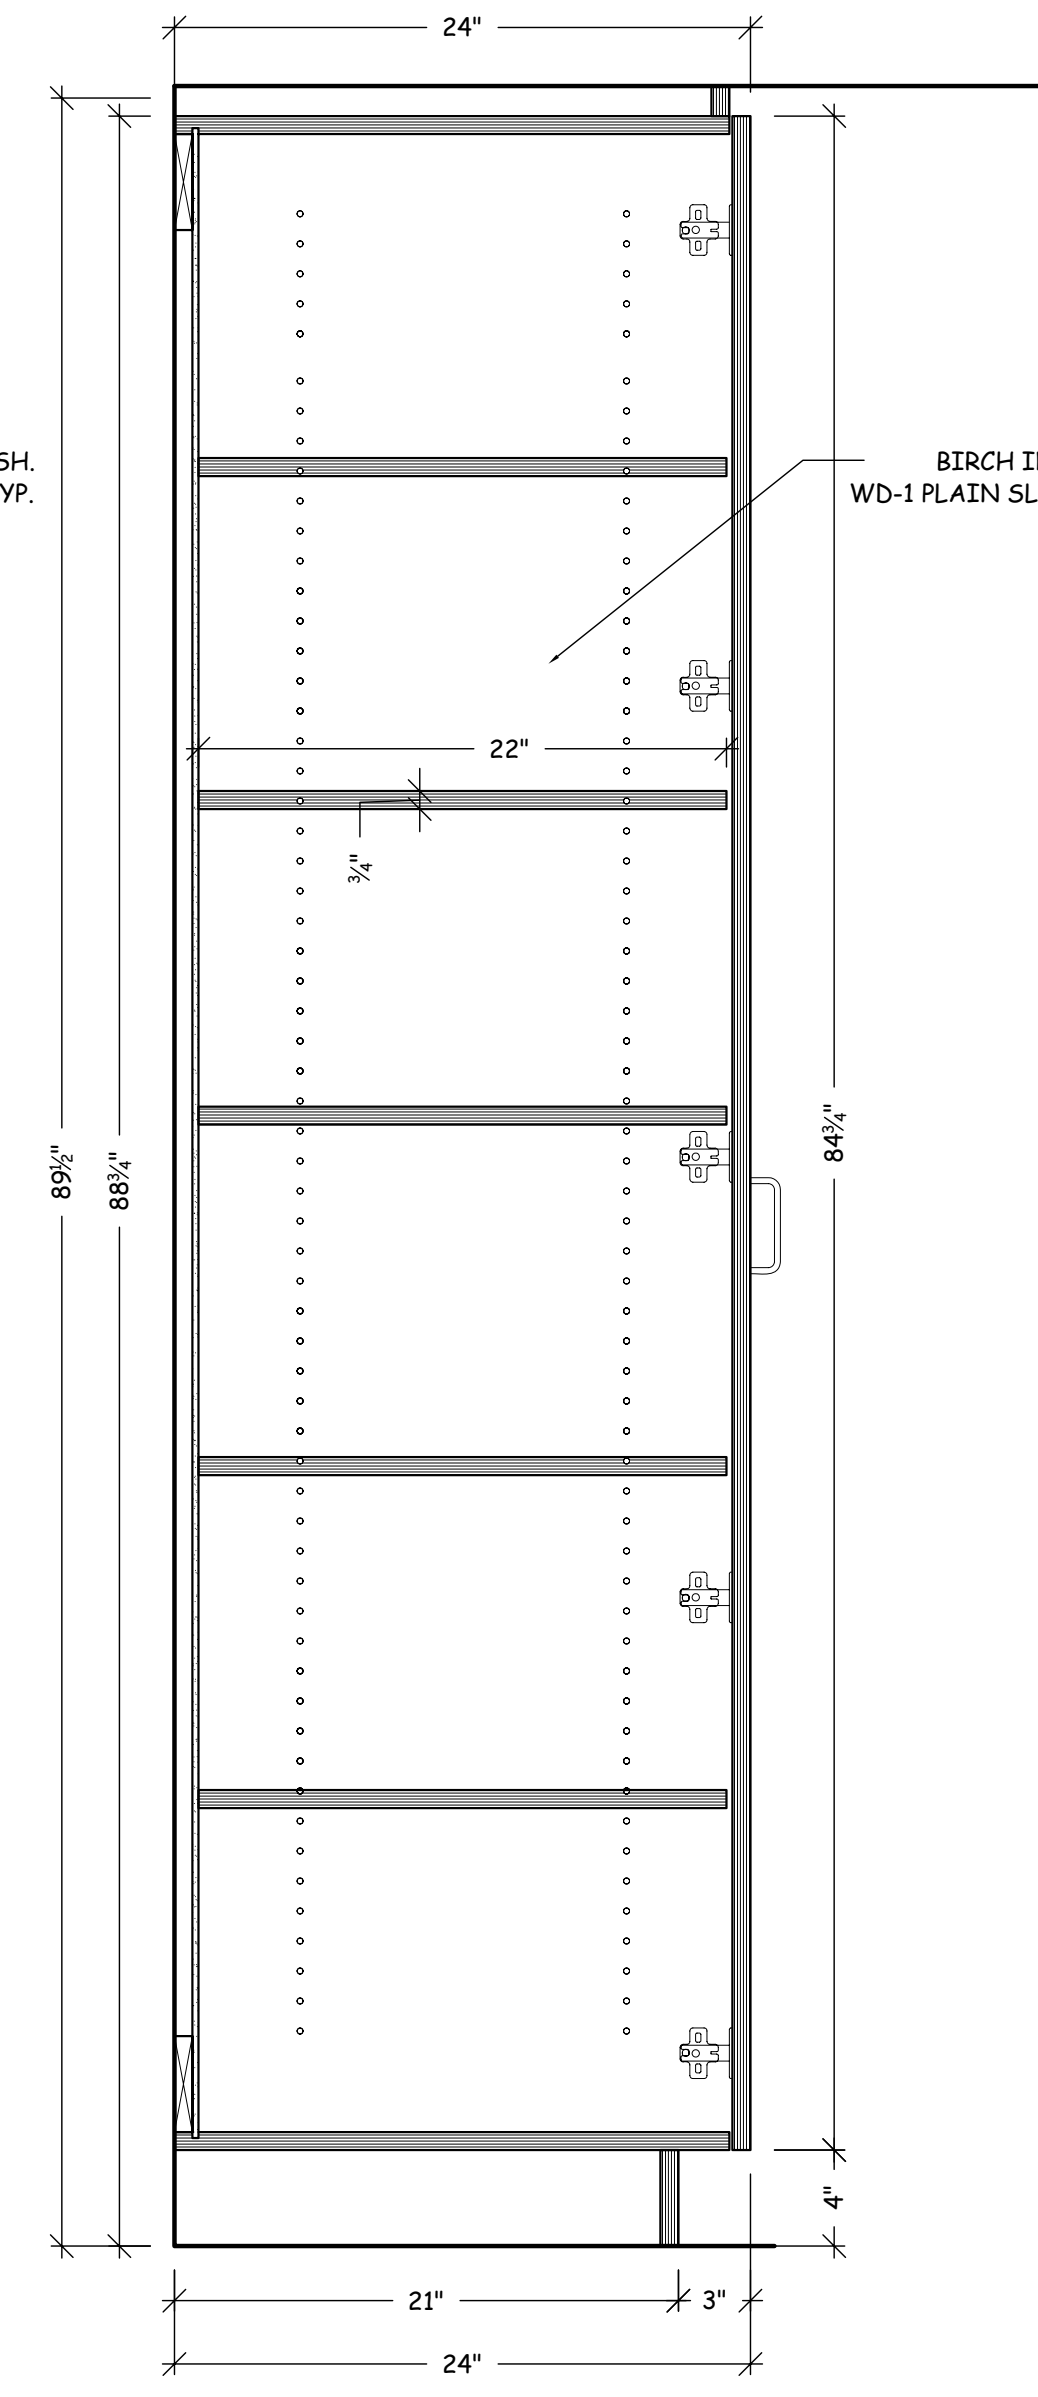

S.35 SECTION
SCALE: 1 1/2" = 1'-0"

General Notes
SHOP NOTES:

N&N Architectural Drafting Service
Computer Aided Design & Drafting/ CNC Programming

LEGEND:


 Drawn by Neno K.

No.	Revision/Issue	Date


DRAWING RECORD

ARCHITECT:
 CONTRACTOR:
 Project Name and Address:

Project: _____ Sheet: S-9
 Date: 7-23-07
 JOB # : *

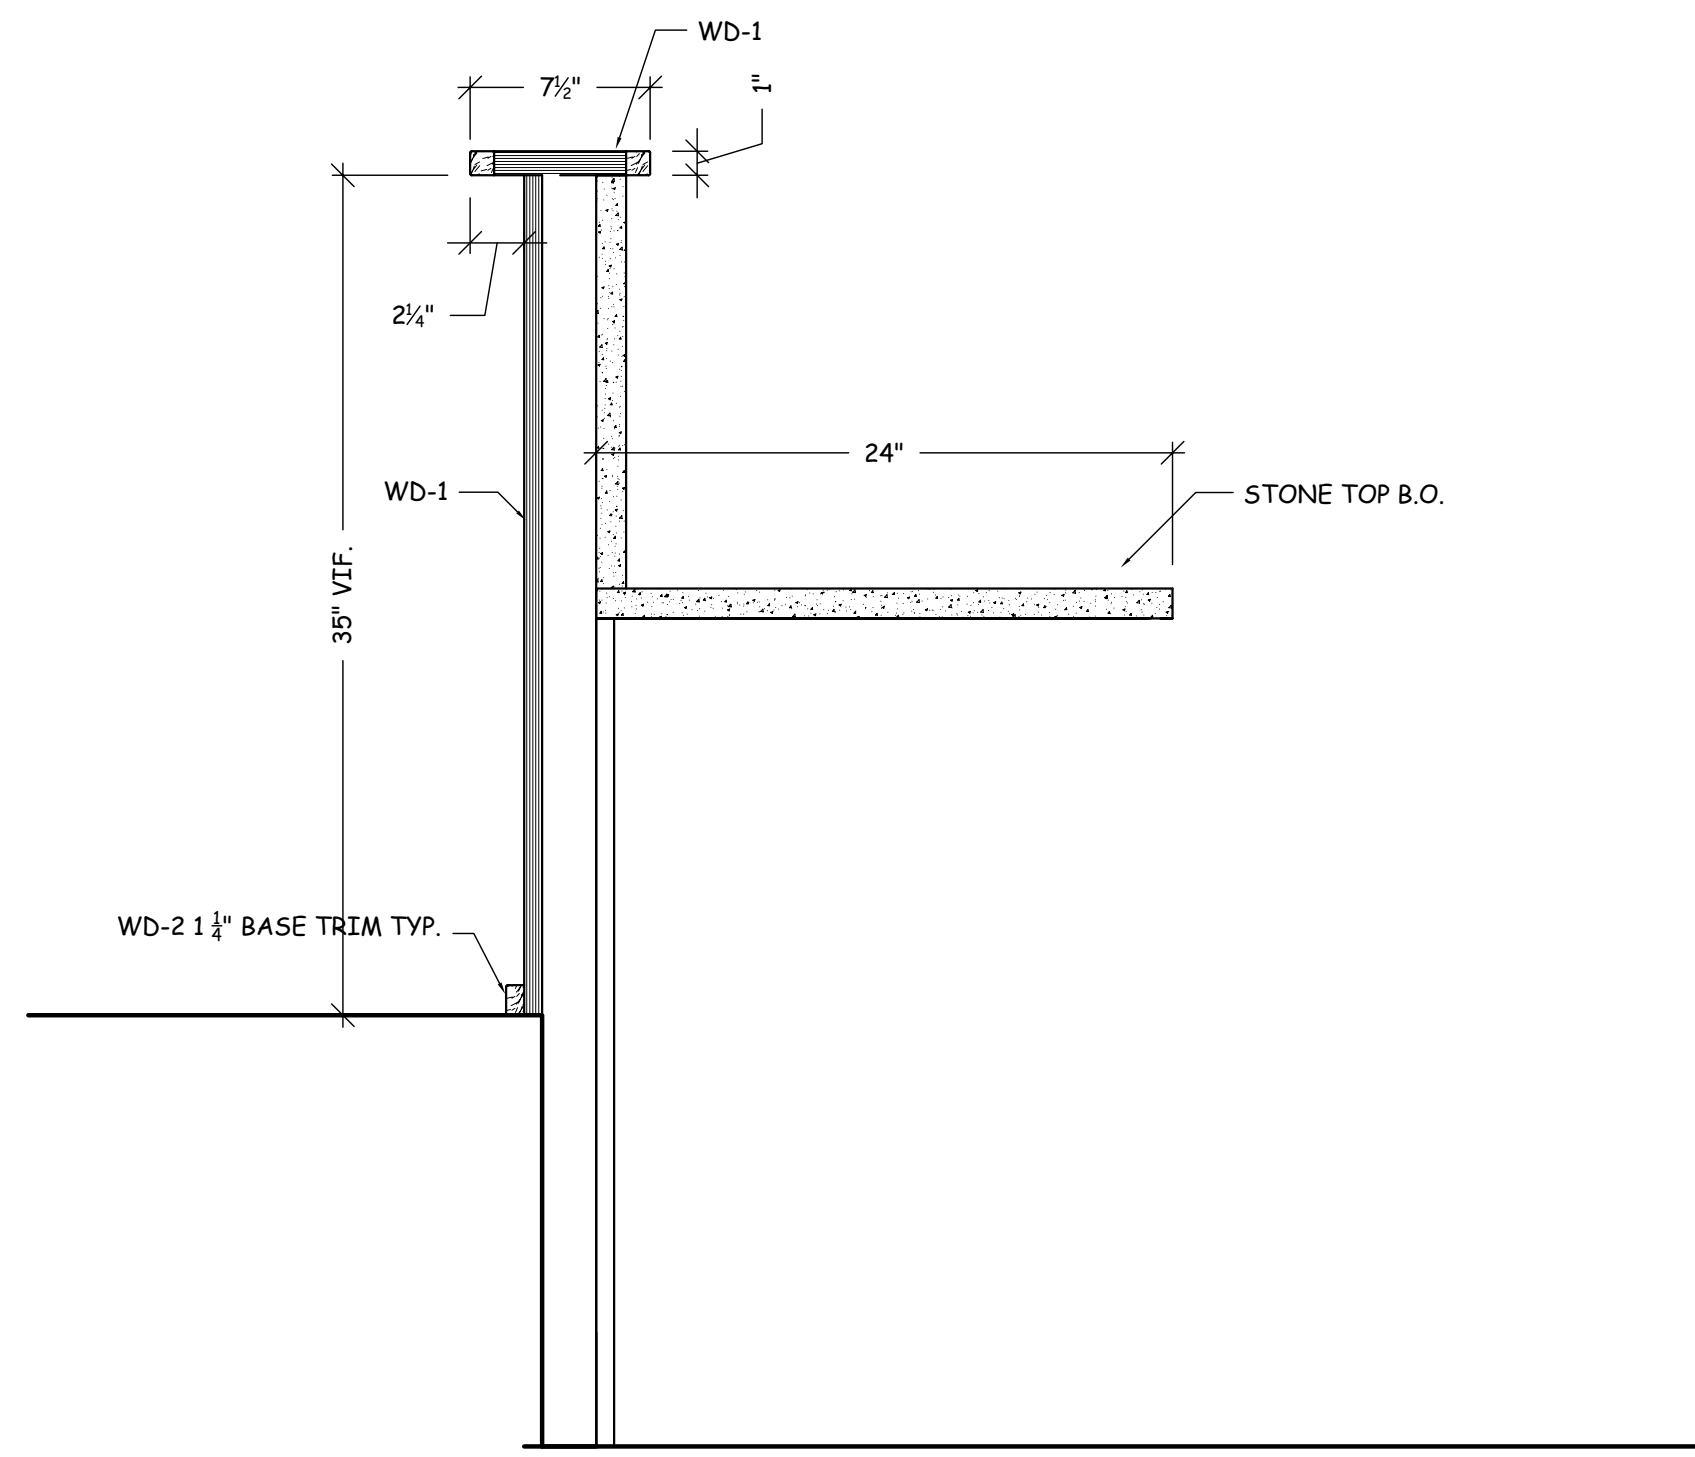

S.36 SECTION
SCALE: 1 1/2" = 1'-0"

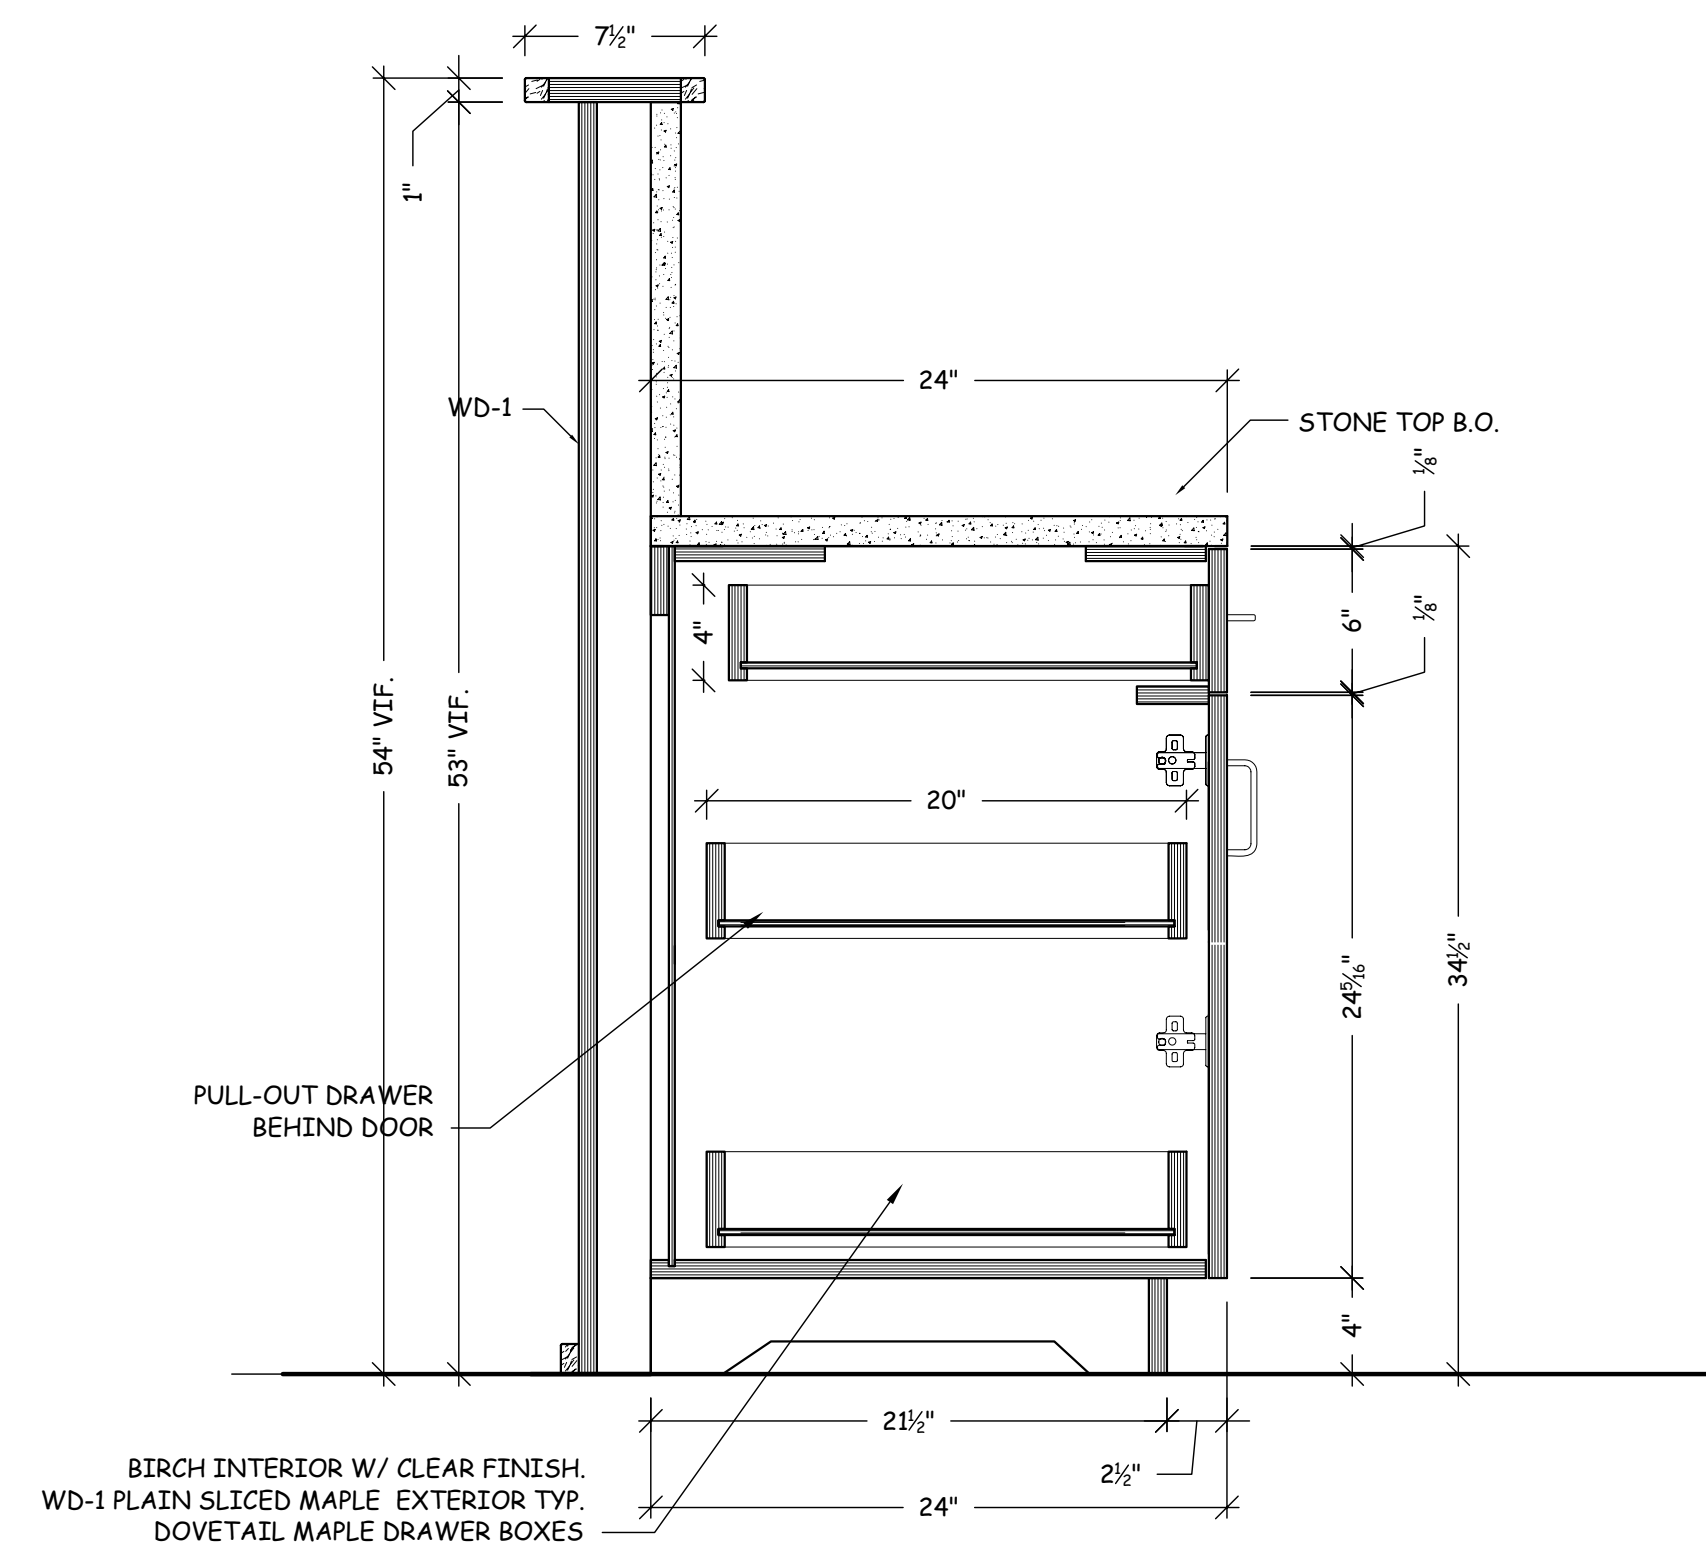

S.37 SECTION
SCALE: 1 1/2" = 1'-0"

General Notes

SHOP NOTES:

N&N Architectural Drafting Service
Computer Aided Design & Drafting/ CNC Programming

LEGEND:

 VIEW
 SHEET NO.
 DIRECTION OF VIEW

Drawn by Neno K.

No.	Revision/Issue	Date

DRAWING RECORD

ARCHITECT:


CONTRACTOR:

Project Name and Address:


Project: _____ Sheet: _____

Date: **7-23-07** S-10


JOB # : *

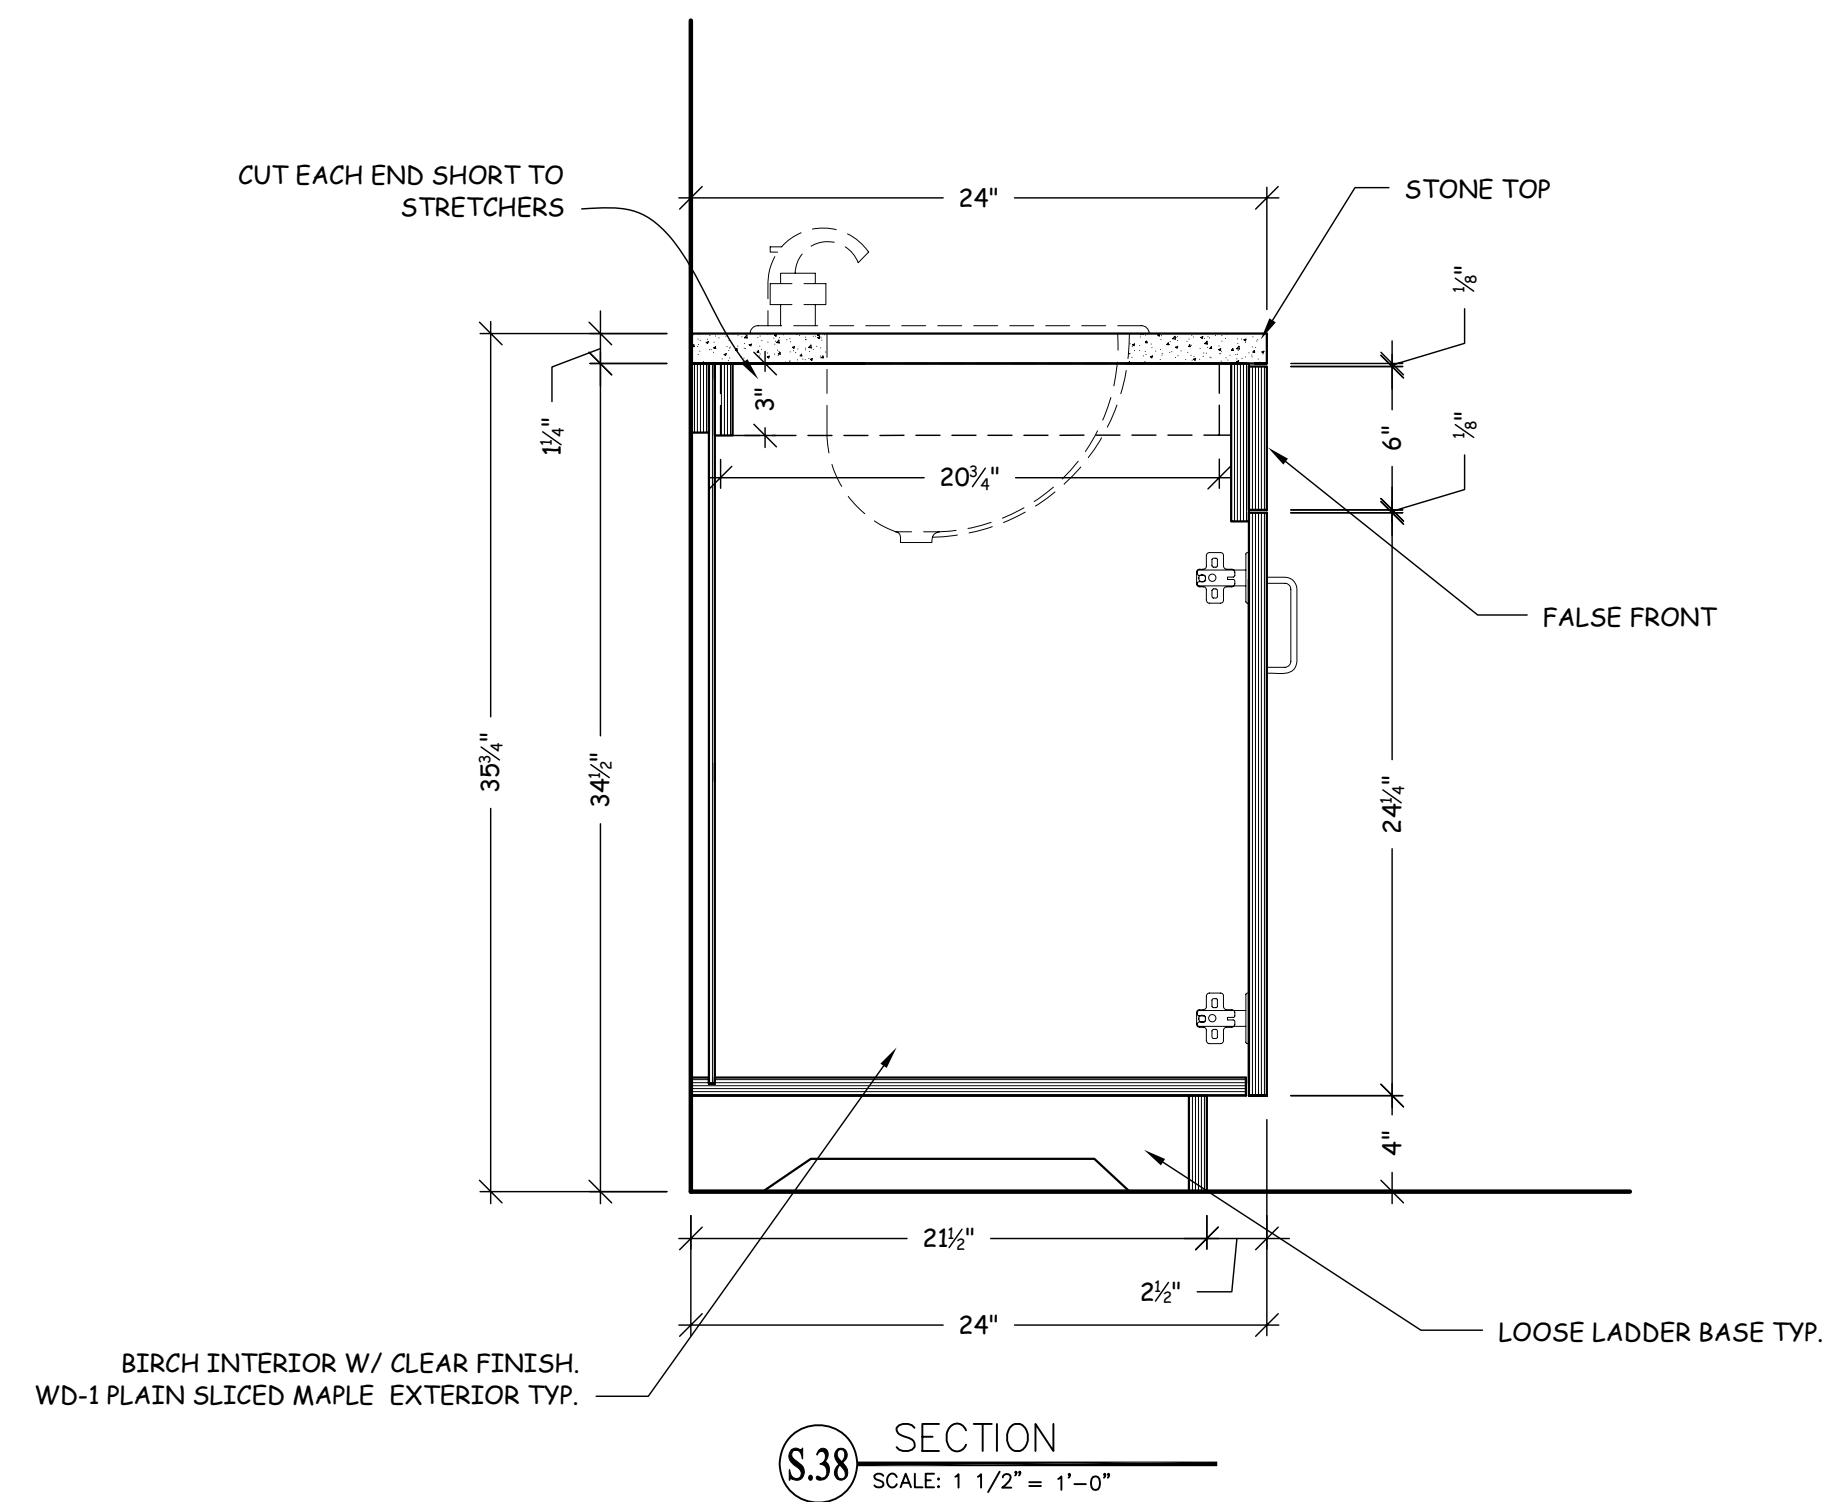

S.38 SECTION
SCALE: 1 1/2" = 1'-0"

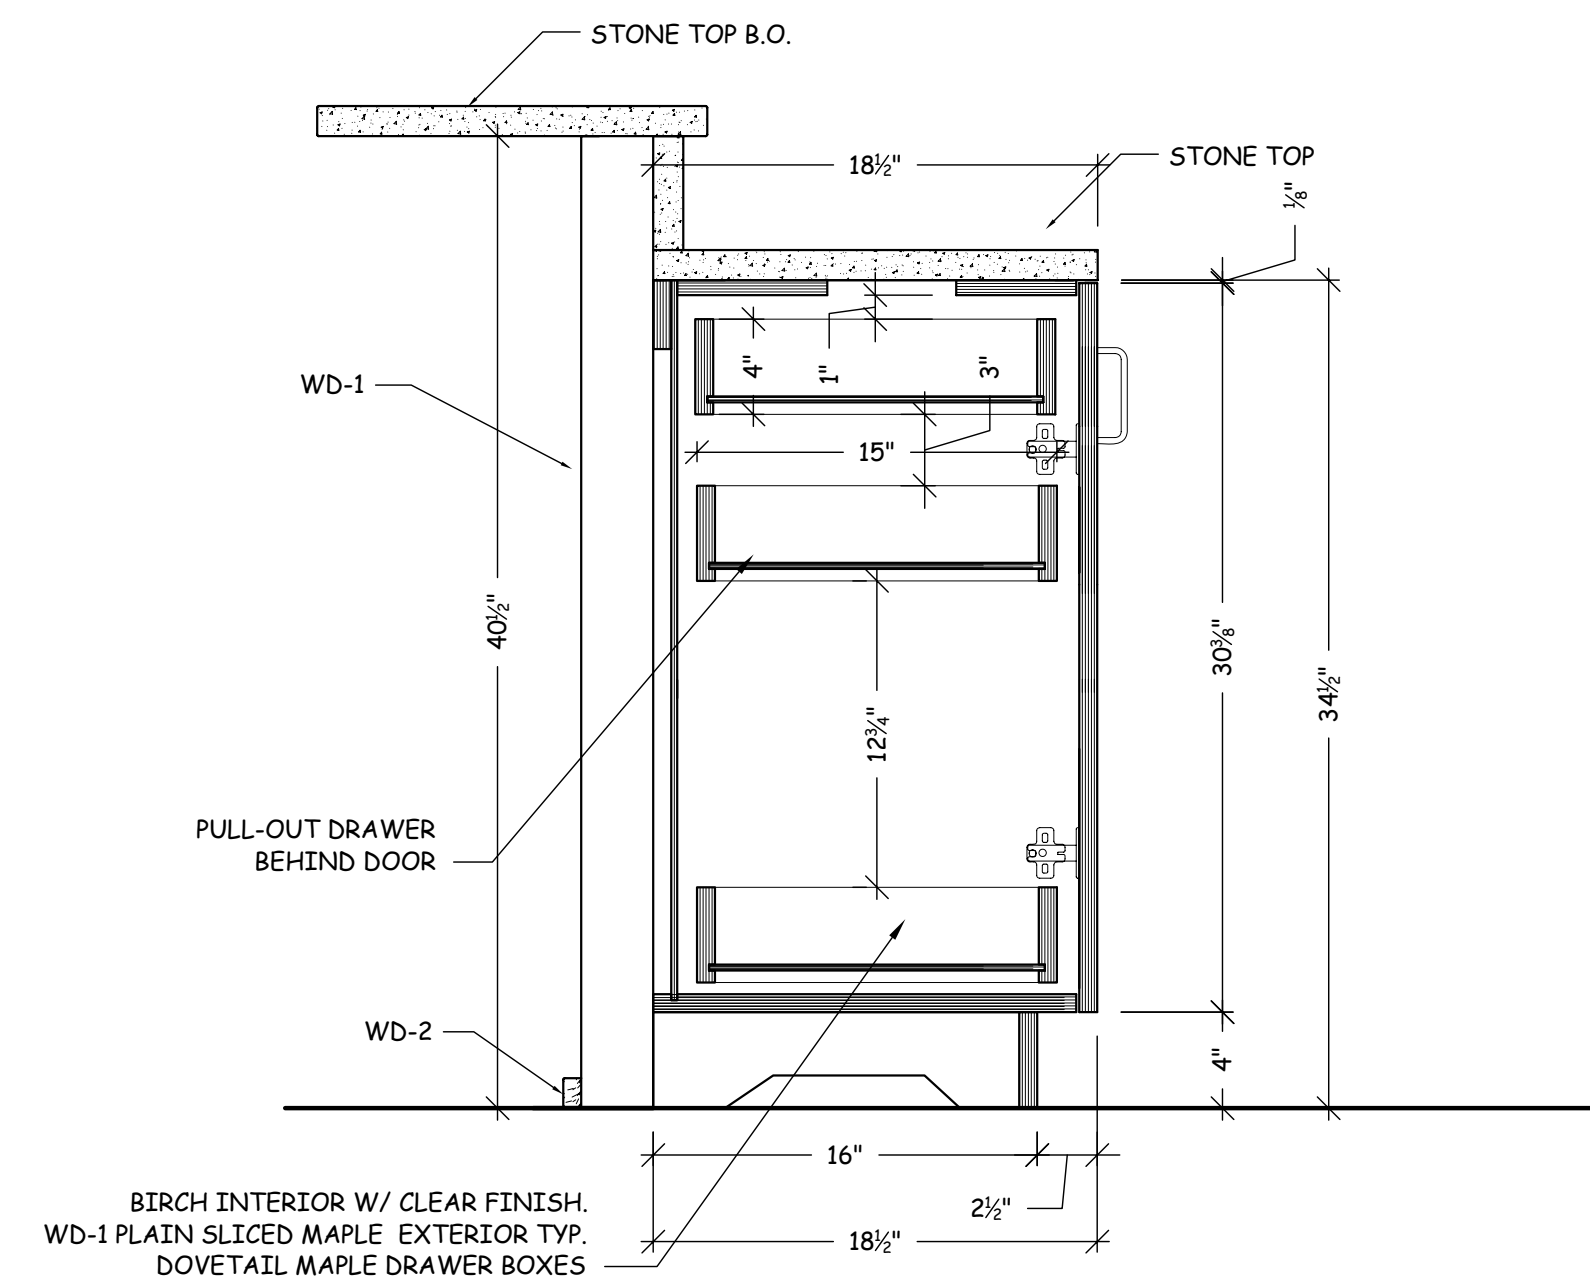

S.39 SECTION
SCALE: 1 1/2" = 1'-0"

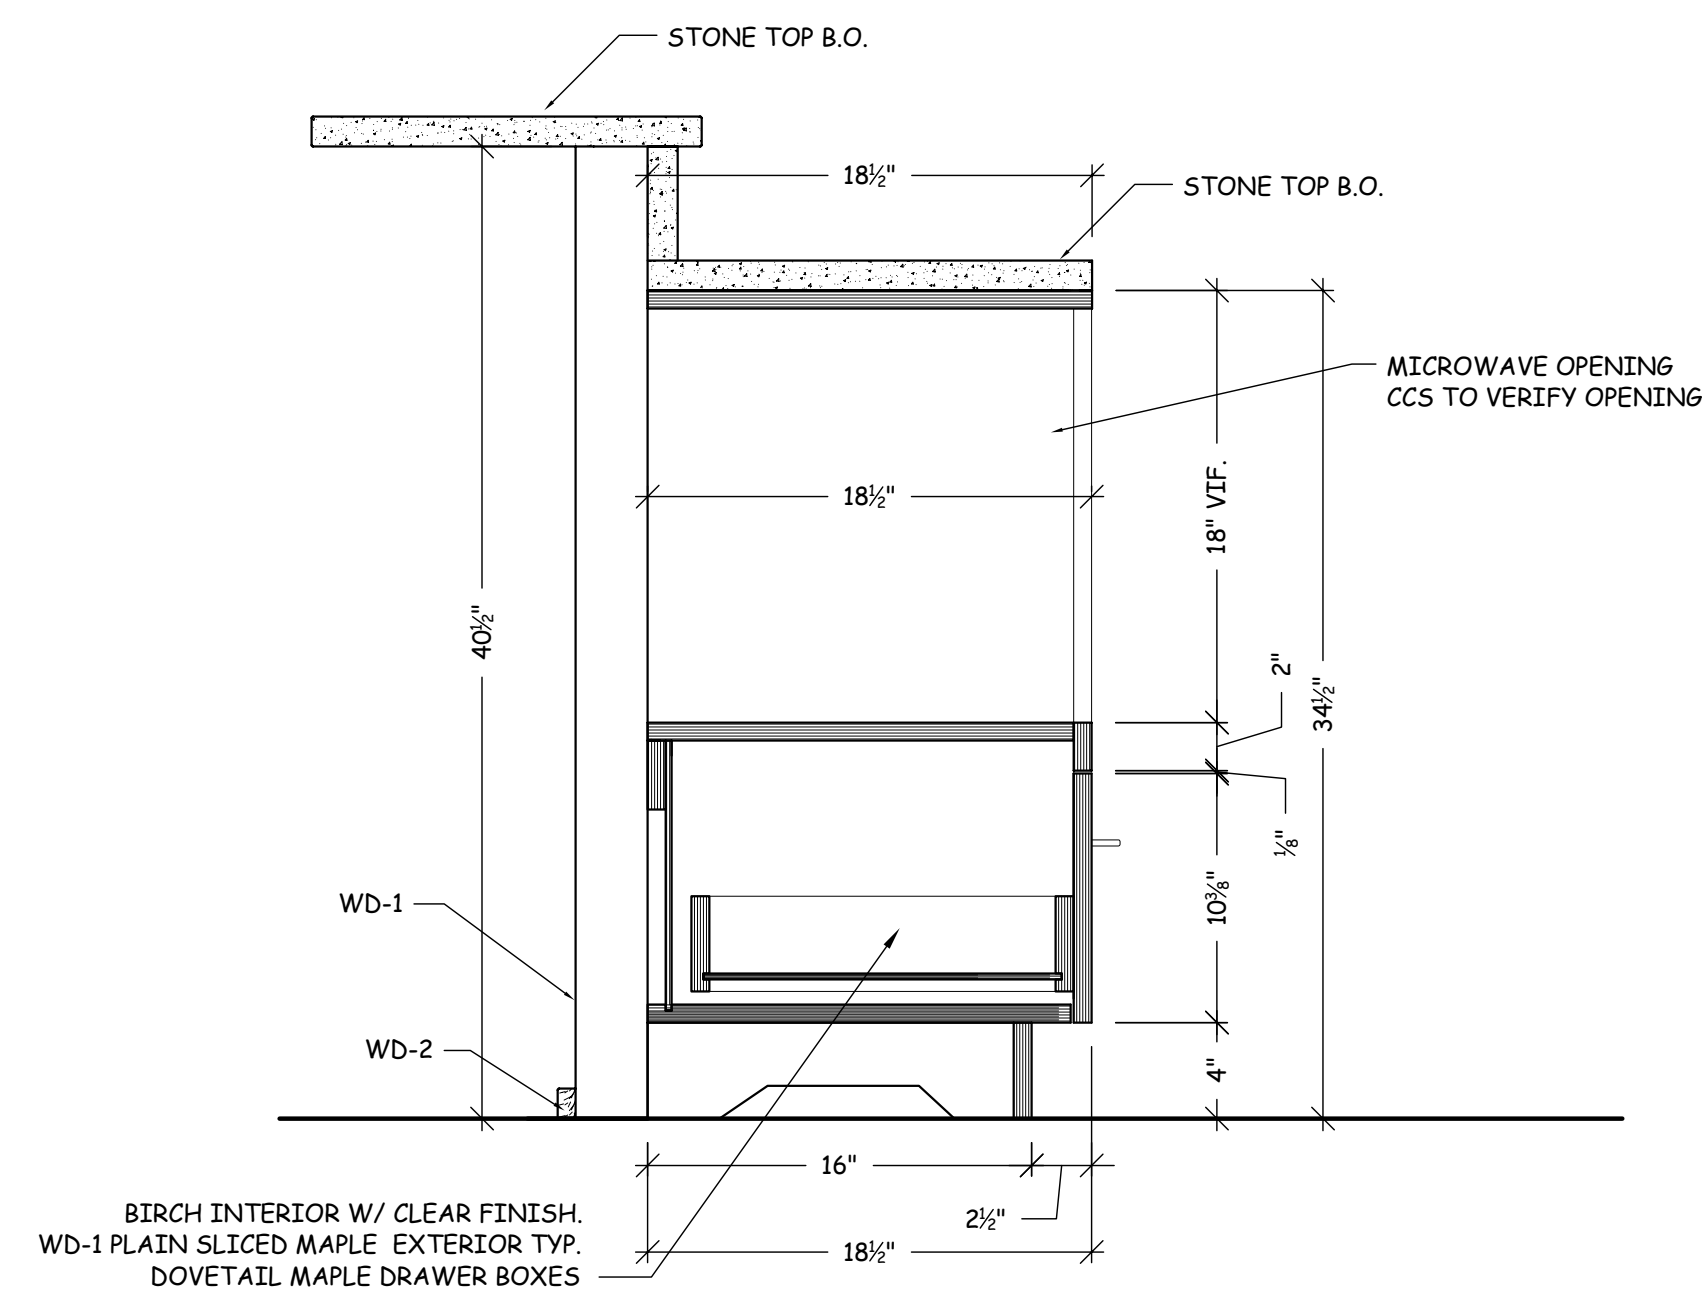

S.40 SECTION
SCALE: 1 1/2" = 1'-0"

General Notes

SHOP NOTES:

N&N Architectural Drafting Service
Computer Aided Design & Drafting/ CNC Programming

LEGEND:
VIEW
SHEET NO.
DIRECTION OF VIEW

Drawn by Neno K.

No.	Revision/Issue	Date

DRAWING RECORD

ARCHITECT:
CONTRACTOR:
Project Name and Address:

Project: -
Date: 7-23-07
JOB # : *

Sheet: S-II